

11/18/81


OFFICE OF THE

t-056  
TURKEY HILL

24S 5W 8

DOUGLAS COUNTY SURVEYOR

NAD 681229.94 4172868.41  
83 43°30' 5" 123°19'17"

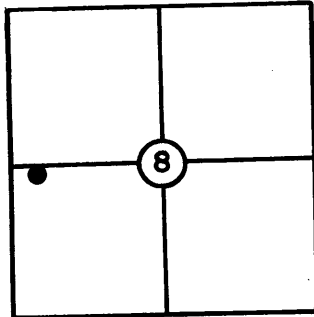

T 24 S, R 5W, Sec. 8

Station: Turkey Hill

Set By (Agency): DCSO

Date: 1977

T-056

VERTICAL CONTROL

Elevation: \_\_\_\_\_ NGS(USC&GS) Line # \_\_\_\_\_ USGS Line # \_\_\_\_\_

Order  
Of Precision \_\_\_\_\_ Agency: \_\_\_\_\_ Proj. #: \_\_\_\_\_ Date: \_\_\_\_\_

HORIZONTAL CONTROL

NAD 27

Oregon State Plane Coordinates: Y(Northing) 681,264.30 X(Easting) 1,251,908.66  
(South Zone)

Order  
Of Precision 1/25,000 Agency: DCSO Proj. #: 2010-4 Date: 1978

Approximate Geographic Position: Latitude= 43° 30' 05" C.S. 59/47 Longitude= 123° 19' 12"

DESCRIPTION: A Brass cap stamped "Turkey

Hill 1977" set in a drill hole in a 3 1/2  
ft. sq. conc. footing near the SW cor of the

footing 4 ft W. of the E. R/W fence of I-5


between the freeway & a dead-end Frontage Rd.  
47 ft. South of the South end of a freeway  
guardrail, and 4 ft. West of a metal witness  
post.

TO REACH: From the Rice Hill exit on I-5,  
proceed Sth'ly on I-5 approx. 1.9 miles to  
exit #146 thence 0.1 South on Frontage Rd.  
and cross over freeway, thence 0.8 miles  
Sth'ly along Frontage Rd. on East side of I-5  
to the station.

VICINITY: Approx. 0.8 mi. S. of the Rice

Valley interchange along I-5.

SKETCH

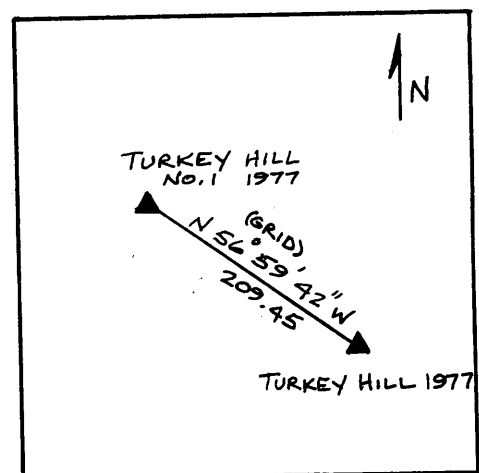

NOTE: For Possible Further Information On This Station, Please Contact The Douglas  
County Surveyors Office, Rm. 205 Douglas County Justice Bldg., Roseburg, OR.  
97470 Phone 672-3311 Ext. 272.. Douglas County residents outside the  
Roseburg calling area dial toll free 1-800-452-0991.