

OFFICE OF THE
DOUGLAS COUNTY SURVEYOR


Station: U-32 T 24 S, R 7W, Sec 3
2

Date set: 1972

Set By (Agency): DCSO


Date of Report: 1-7-82

GQ, JMP.

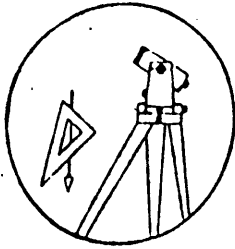

DESIGNATION U-034

- | | |
|---|------------------------------------|
| <input checked="" type="checkbox"/> Found | <input type="checkbox"/> New |
| <input type="checkbox"/> Reset | <input type="checkbox"/> Not Found |
| <input type="checkbox"/> Referenced | <input type="checkbox"/> Destroyed |

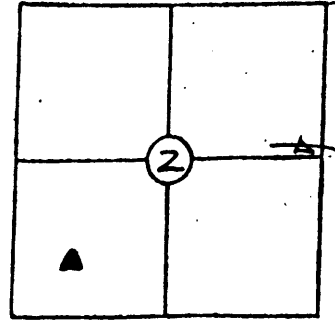

VERTICAL CONTROL NGVD 29

Elevation: 224.912 NGS Line # _____ USGS Line # _____

Precision: 2ND Agency: DCSO Proj. # 2006 Date: 1974

HORIZONTAL CONTROL OCS 27

South Zone State Plane Coordinates: Y(Northing) 685,168.13 X(Easting) 1204,805.74

Precision: 1/25,000 Agency: DCSO Proj. # 2006 Date: 1972

Approximate Geographic Position: Latitude 43° 30' 28" Longitude 123° 29' 53"

DESCRIPTION and TO REACH

FOUND BRASS CAP SET IN BOULDER FLUSH WITH GROUND MARKED
"U-32 1972". SURVEY MARKER SIGN ALONG SOUTHEASTLY SIDE
OF STATION

TO REACH: FROM THE INTERSECTION OF CO. RD # 57 & HWY 138
(SEC 13, T24S R7W) PROCEED WESTERLY ALONG HWY 138
2.3 MILES TO STATION ON LEFT.

Reference Marks:

