


OFFICE OF THE
DOUGLAS COUNTY SURVEYOR

u-028
U-26

24S 7W 14

NAD 675192.30 4126623.15
83 43°28'49" 123°29'41"

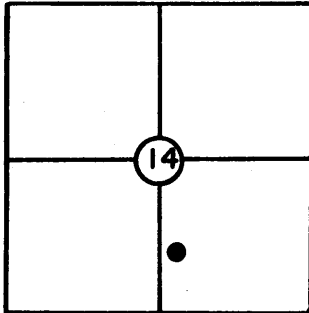

T 24 S, R 7W, Sec. 14

Station: U-26

Set By (Agency): DCSO

Date: 1972

VERTICAL CONTROL

NGVD 29

Elevation: 253.015 NGS(USC&GS) Line # _____ USGS Line # _____

Order
Of Precision 2nd Agency: DCSO Proj. #: 2006 Date: 1972

HORIZONTAL CONTROL

NAD 27


Oregon State Plane Coordinates: Y(Northing) 675,226.98 X(Easting) 1,205,663.87
(South Zone)

Order
Of Precision 1/25,000 Agency: DCSO Proj. #: 2006 Date: 1972

Approximate Geographic Position: Latitude= _____ Longitude= _____

DESCRIPTION: Brass cap set in concrete post,
survey marker alongside.

SKETCH

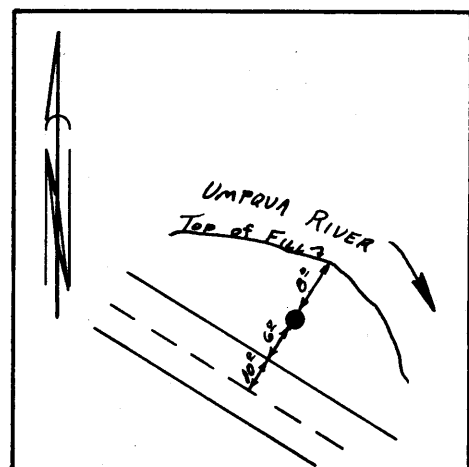

VICINITY: From Umpqua go W'stly on Tyee
Rd. 20.5 mi.

NOTE: For Possible Further Information On This Station, Please Contact The Douglas County Surveyors Office, Rm. 205 Douglas County Justice Bldg., Roseburg, OR. 97470 Phone 672-3311 Ext. 272.. Douglas County residents outside the Roseburg calling area dial toll free 1-800-452-0991.