


OFFICE OF THE
DOUGLAS COUNTY SURVEYOR

1-026
LAST

25S 6W 13

NAD 645330.20 4160654.11
83 43°24' 6" 123°21'46"

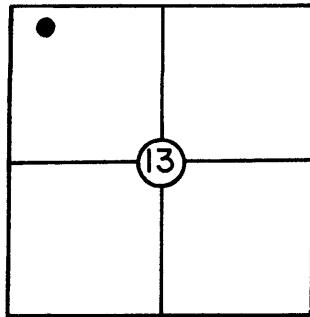

L-026

VERTICAL CONTROL

NGVD 29

Elevation: 396.475 NGS(USC&GS) Line # _____ USGS Line # _____

Order (Calapooya)
Of Precision 2nd - I Agency: DCSO Proj. #: 2006 Date: 1980

HORIZONTAL CONTROL

NAD 27

Oregon State Plane Coordinates: Y(Northing) 645,364.79 X(Easting) 1,239,694.98
(South Zone)


Order (Calapooya)
Of Precision 1/25,000 Agency: DCSO Proj. #: 2006 Date: 1980

Approximate Geographic Position: Latitude= 43° 24' 07" Longitude= 123° 21' 41"

DESCRIPTION: A standard DCSO brass cap drill-
ed into the NE conc. headwall abutment of the
covered bridge crossing the Calapooya along
Co. Rd. 10. Cap is 2.2 ft. NE on curbing,
12.3 ft. NE of centerline of Co. Rd. 10.
TO REACH: From I-5 crossing Hwy 138 to
Co. Rd. 10 thence along Co. Rd. 0.5 mi. to
covered bridge. Monument on right at NE
end.

VICINITY: 0.5 mi. along Co. Rd. 10 from the
intersection of Hwy 138 and Co. Rd. 10

SKETCH

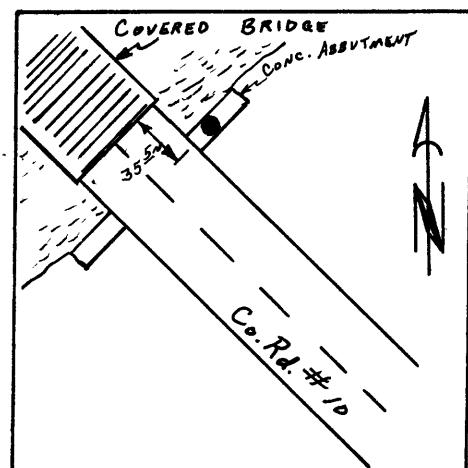

NOTE: For Possible Further Information On This Station, Please Contact The Douglas County Surveyors Office, Rm. 205 Douglas County Justice Bldg., Roseburg, OR. 97470 Phone 672-3311 Ext. 272.. Douglas County residents outside the Roseburg calling area dial toll free 1-800-452-0991.