

OFFICE OF THE  
DOUGLAS COUNTY SURVEYOR



270-06W-22-023      27S 06W 22  
S 1/4

NAD      572066.91    4148997.82  
83      43°11'59"    123°23'49"

Station: S 1/4      T 27 S, R 6 W , Sec 22

Set By (Agency): unknown

440300

Date Set: unknown

Recovered By RWS, SJF


Date Recovered 3/6/90

Recovered By \_\_\_\_\_

Date Recovered \_\_\_\_\_

Recovered By \_\_\_\_\_

Date Recovered \_\_\_\_\_

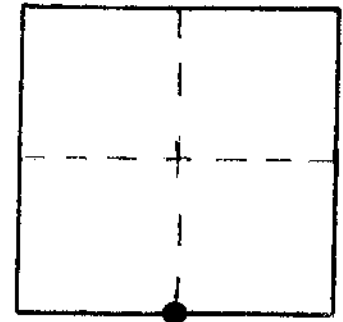

VERTICAL CONTROL

Elevation: N/A      NGS Line # \_\_\_\_\_      USGS Line # \_\_\_\_\_      OSHD Line # \_\_\_\_\_

Precision: \_\_\_\_\_      Agency: \_\_\_\_\_      Proj. # \_\_\_\_\_      Date: \_\_\_\_\_

HORIZONTAL CONTROL      OCS 27

South Zone State Plane Coordinates: Y(Northing) 572,102.02      X(Easting) 1,228,039.39

Precision: 1/5,000      Agency: DCSO      Proj. # 2015      Date: 1990

Approximate Geographic Position: Latitude 43°12'00"      Longitude 123°23'45"

DESCRIPTION and TO REACH

SKETCH

See DCSO corner renewal records.

Reference Marks:

Note: For further information, contact the Douglas County Surveyor's Office, Room 205 Douglas County Justice Building, Roseburg, OR 97470. Phone 440-4278. Douglas County residents outside the Roseburg calling area, dial toll free 1-800-452-0991.