


OFFICE OF THE

DOUGLAS COUNTY SURVEYOR

1-063  
LENORA

285 3E 3

NAD 552795.77 4401732.43  
E 45-10' 1" 122°26' 49"

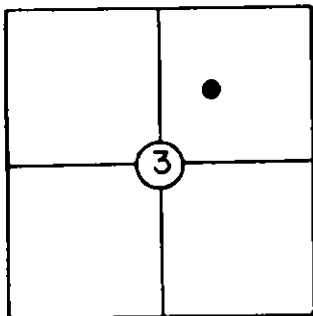

T 28 S, R 3 E, Sec. 3

Station: Lenora

Set By (Agency): DCSO

Date: 1974

VERTICAL CONTROL

Elevation: 5916.2 NGS(USC&GS) Line # \_\_\_\_\_ USGS Line # \_\_\_\_\_

Order  
Of Precision VA Agency: DCSO Proj. #: 2004-8 Date: 1975

HORIZONTAL CONTROL

Oregon State Plane Coordinates: Y(Northing) 552,832.74 X(Easting) 1,480,973.72  
(South Zone)

Order  
Of Precision 1/100,000 Agency: DCSO Proj. #: 2004-8 Date: 1975

Approximate Geographic Position: Latitude= \_\_\_\_\_ Longitude= \_\_\_\_\_

DESCRIPTION: Brass cap set in a 4 ft x 5 ft

rock 0.2 ft. above ground (R.M.'s also set  
in rock) on cut and burned part of N-S ridge.


monument is not on highest part of ridge.

To reach from the intersection of rd. no.  
2739 and 2739-L ( known as French Junct)

Proceed SE'stly on Rd. 2739-L 2.6 mi to  
junct of Rd. 2739-L and Rd. #2716 - turn

left on to Rd #2716 and procede 1.1 mi.  
to 4 wheel drive rd. on right - follow  
rd. to station approx. 0.2 mi.

SKETCH

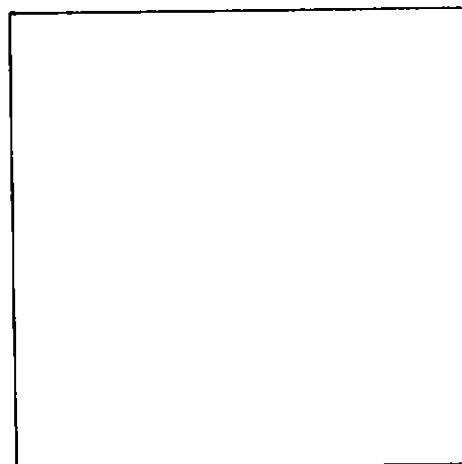

VICINITY: From Hwy 138 intersection w/ rd.  
no. 2739 on #2739 approx. 12 mi.

NOTE: For Possible Further Information On This Station, Please Contact The Douglas County Surveyors Office, Rm. 205 Douglas County Justice Bldg., Roseburg, OR. 97470 Phone 672-3311 Ext. 272. Douglas County residents outside the Roseburg calling area dial toll free 1-800-452-0991.