


OFFICE OF THE
DOUGLAS COUNTY SURVEYOR

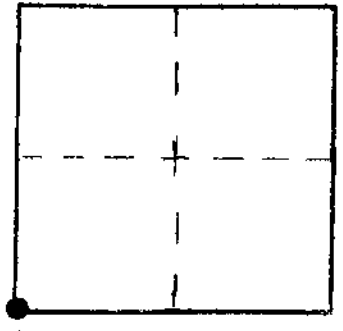

280-06W-31-019 28S 06W 31
SE CORNER
NAD 530434.24 4129523.19
83 43°05'01" 123°27'52"

Station: SE COR T 28 S, R 6 W , Sec 31
Set By (Agency): DCSO 100100
Date Set: 1958
Recovered By RWS, SIF
Date Recovered 2/14/90
Recovered By _____
Date Recovered _____
Recovered By _____
Date Recovered _____



VERTICAL CONTROL

Elevation: _____ NGS Line # _____ USGS Line # _____ OSHD Line # _____
Precision: _____ Agency: _____ Proj. # _____ Date: _____

HORIZONTAL CONTROL **OCS 27**

South Zone State Plane Coordinates: Y(Northing) 530,469.42 X(Easting) 1,208,564.98
Precision: 1/5,000 Agency: DCSO Proj. # 2015 Date: 1990
Approximate Geographic Position: Latitude 43°05'02" Longitude 123°27'48"

DESCRIPTION and TO REACH

SKETCH

SEE DCSO CORNER RENEWAL RECORDS.

Reference Marks:

Note: For further information, contact the Douglas County Surveyor's Office, Room 205 Douglas County Justice Building, Roseburg, OR 97470. Phone 440-4278. Douglas County residents outside the Roseburg calling area, dial toll free 1-800-452-0991.