

OFFICE OF THE  
DOUGLAS COUNTY SURVEYOR

Station: MORT



T 30S S, R 5W , Sec 5

Date Set: 1999

Set By (Agency): DCSO

Date Recovered: 10-26-99

Recovered By: RWS SJF

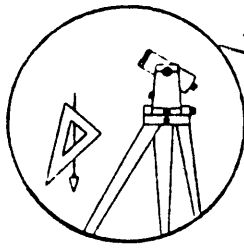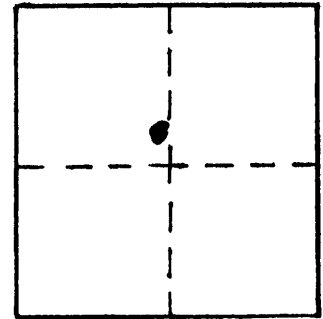

- Found
- New
- Reset
- Not Found
- Referenced
- Destroyed

DESTROYED

M-109  
VERTICAL CONTROL NGVD 29

Elevation: 620.15 NGS Line #          USGS Line #          OSHD Line #         

Precision: 3rd Agency: DCSO Proj. # 2007 Date: 1999

HORIZONTAL CONTROL

South Zone O.C.S. 27: Y(Northing)          X(Easting)         

South Zone O.C.S. 83: Y(Northing)          X(Easting)         

Precision:          Agency:          Proj. #          Date:         

Approx. NAD <sup>83</sup> Geographic Position: Latitude 42 59 33 Longitude 123 18 48

DESCRIPTION and TO REACH

DCSO DRILL CAP SET IN CONCRETE  
CURB, STAMPED "MORT 1999"

FROM THE INTERSECTION OF OLD PACIFIC HWY  
(CO. RD # 386) AND CHARWICK LANE (CO. RD # 20B)  
IN T30S R5W SEC 5 PROCEED NORTHERLY  
ALONG OLD PACIFIC HWY 0.6 MILES  
TO MONUMENT ON RIGHT.



(MONUMENT REPORTED AS)  
DESTROYED 7/06  
BY NEIL HIBBS

Reference Marks:

