



OFFICE OF THE
DOUGLAS COUNTY SURVEYOR

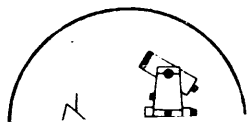

#-112
30528 A

NAD 476849.52 4174749.61
83 42°56'28" 123°17'19"

Station: 30528 A T 30 S, R 5 W , Sec 28
Set By (Agency): OSHD
Date Set: 1978
Recovered By JP,RS
Date Recovered 10/12/83
Recovered By _____
Date Recovered _____
Recovered By _____
Date Recovered _____

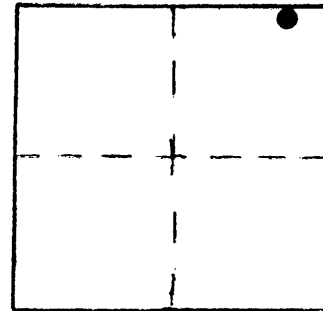

VERTICAL CONTROL

Elevation: _____ NGS Line # _____ USGS Line # _____ OSHD Line # _____
Precision: _____ Agency: _____ Proj. # _____ Date: _____

HORIZONTAL CONTROL OCS 27

South Zone State Plane Coordinates: Y(Northing) 476,885.34 X(Easting) 1,253,790.98
Precision: 1/25,000 Agency: DCSO Proj. # 2008 Date: 1978
Approximate Geographic Position: Latitude 42°56'28" Longitude 123°17'15"

DESCRIPTION and TO REACH


SKETCH

DESCRIPTION:

A OSHD disk stamped "DCSO 30528 A 1978" set flush
in the northwest corner of the southbound I-5 overpass of
North Canyonville access road.

TO REACH:

On Interstate Highway 5 go to overpass crossing of
North Canyonville access road at Exit 99 in T30s,
R5W, Sec. 28.

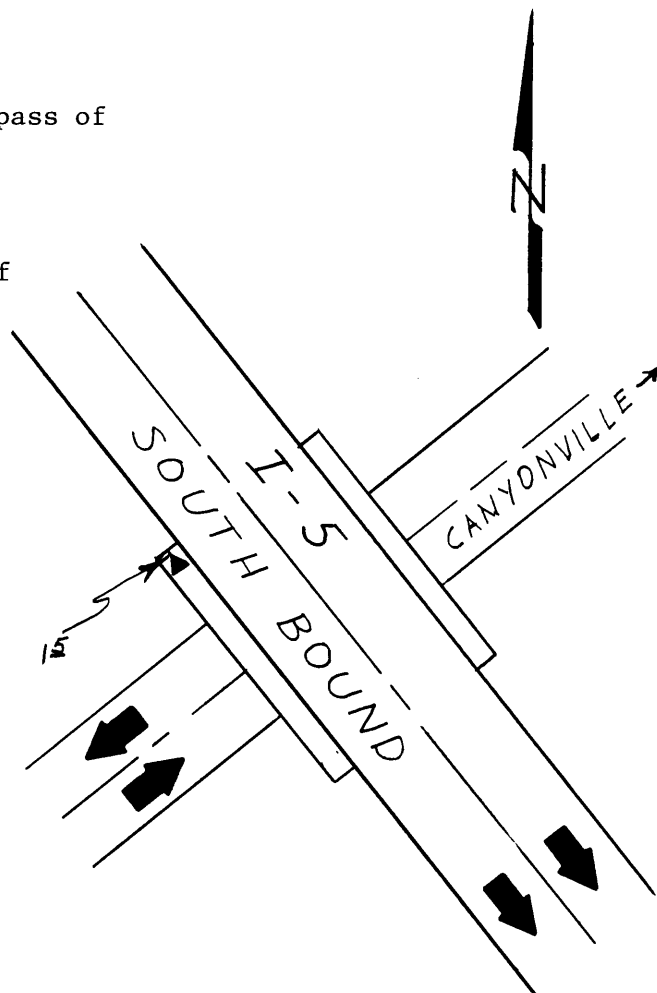

Reference Marks:

Note: For further information, contact the Douglas County Surveyor's Office, Room 205
Douglas County Justice Building, Roseburg, OR 97470. Phone 440-4278. Douglas
County residents outside the Roseburg calling area, dial toll free 1-800-452-0991.