DOUGLAS COUNTY SURVEYOR'S OFFICE

Designation: 340679 Station: SOUTH W.C. TO N 1/4 T 33 S R 06 W S 4 ¼ A

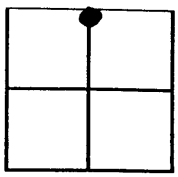

Date Set: 1962 Set by (Agency) PRIVATE

Date Recovered: 1986 Recovered by: D.C.S.O.

☐ Found ☐ New ☐ Reset

☐ Not Found ☐ Referenced ☐ Destroyed

VERTICAL CONTROL

NGVD 29 Elevation: _____ Feet File # _____

Precision: _____ Agency: _____ Project: _____ Date: _____

NAVD 88 Elevation: _____ Meters File # _____

Precision: _____ Agency: _____ Project: _____ Date: _____

HORIZONTAL CONTROL - south zone

N 404650.54	E 1217145.16	Datum/Adj.: 1927	Precision: 1/5000	
Lat: 42 44 23	Long: 123 24 53	Agency: D,C.S.O.	File # _____	Date: 1986
N 404,614.55	E 4,138,103.72	Datum/Adj.: 1983	Precision: 1/5000	
Lat: 42 44 22	Long: 123 24 57	Agency: D.C.S.O.	File # _____	Date: 1986
N _____	E _____	Datum/Adj.: _____	Precision: _____	
Lat: _____	Long: _____	Agency: _____	File # _____	Date: _____
N _____	E _____	Datum/Adj.: _____	Precision: _____	
Lat: _____	Long: _____	Agency: _____	File # _____	Date: _____

DESCRIPTION AND TO REACH
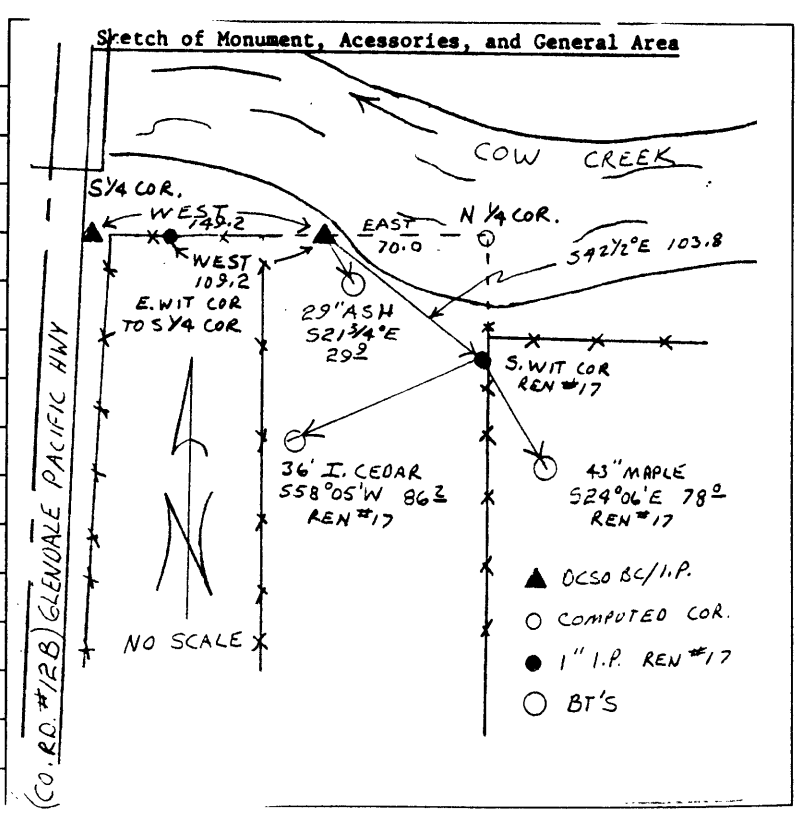
1" dia. I.P. See D.C.S.O. corner info.