T. 22 S., R. 4 W.

3/04

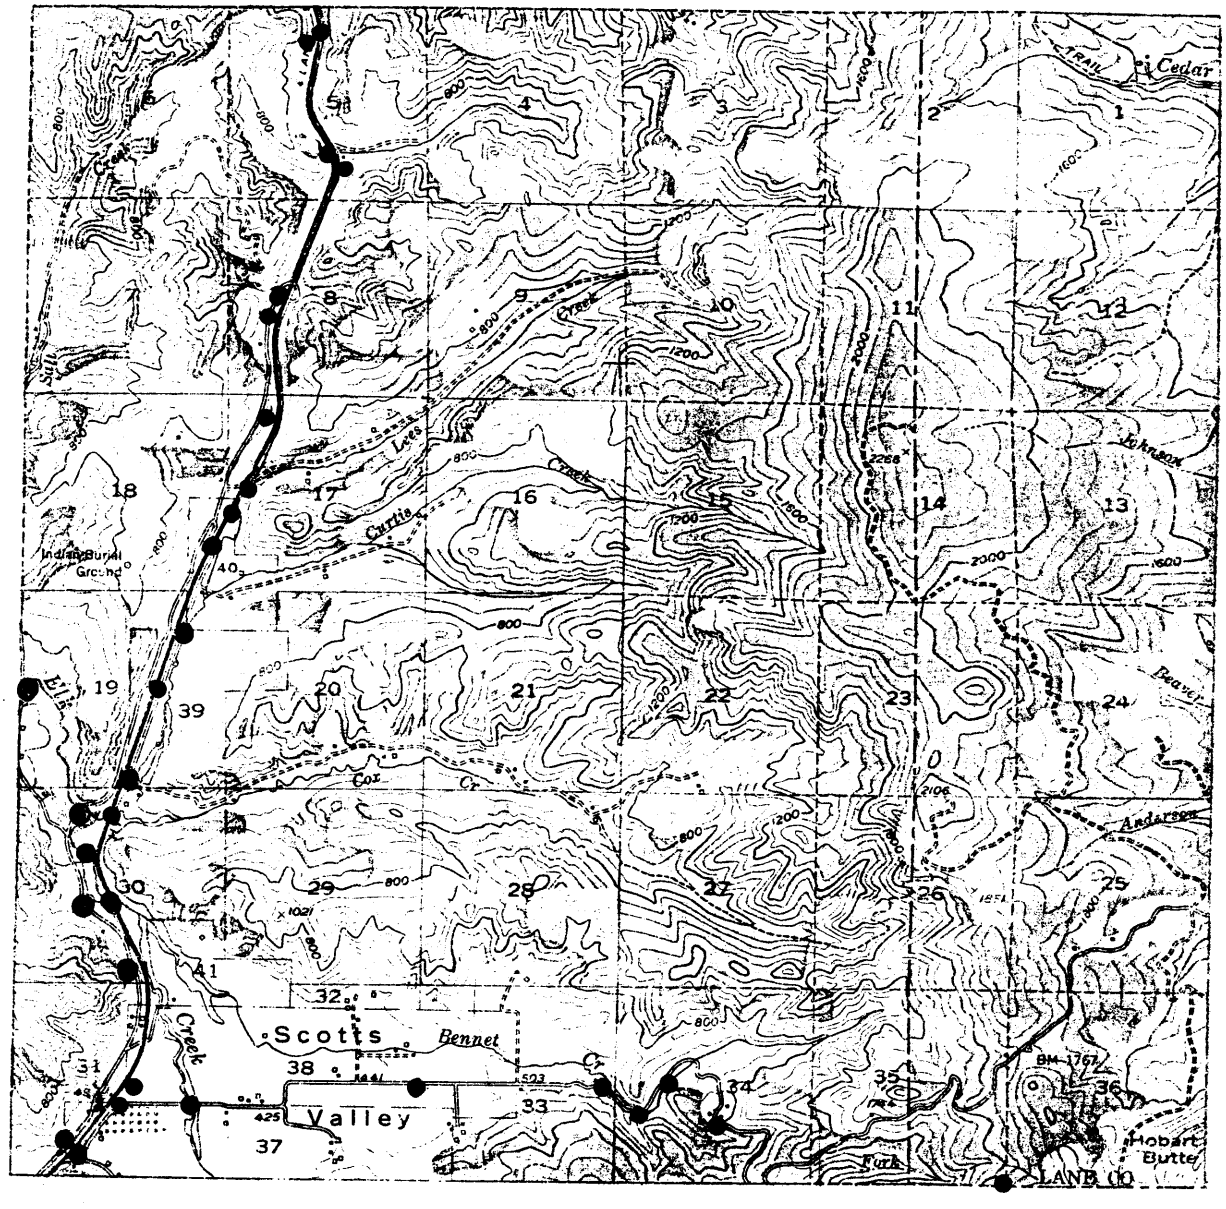
Cedar
Trail
Johnson
Beaver
Anderson
Hobart Butte
Lees
Curtis
Creek
Cor
Cr
Indian Burial Ground
Scotts
Bennet
Valley
Creek
Fork
LANE CO
BM 1767