T. 25 S., R. 6 W.

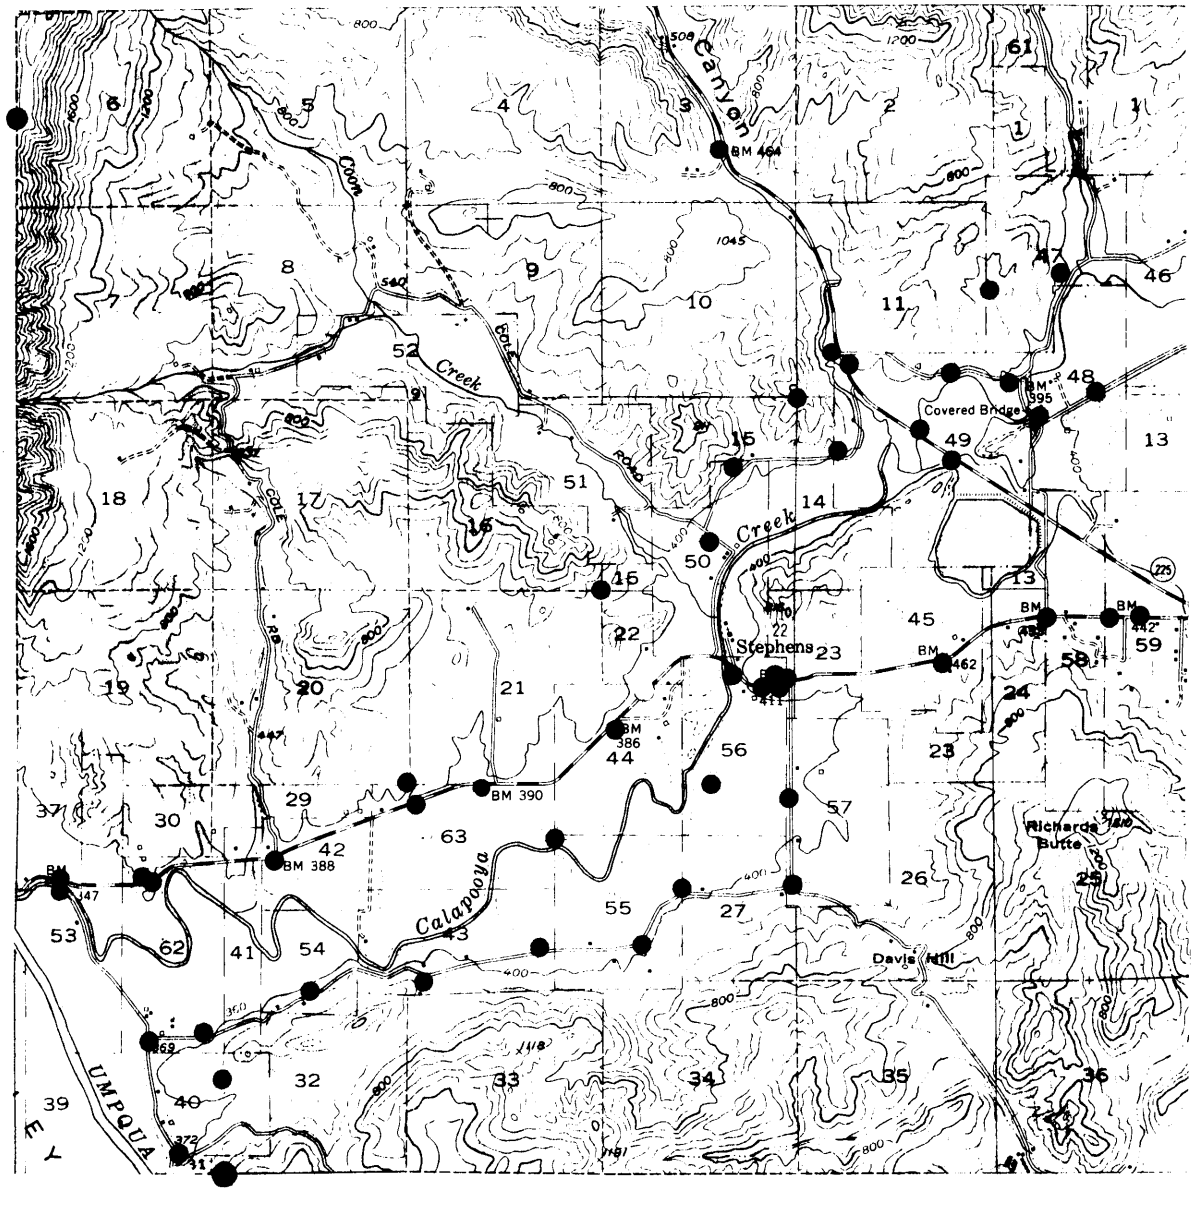
Canyon
Coon
Cole
Creek
Creek
Covered Bridge
Stephens
Calapooya
Richards Butte
Davis Hill
UMPQUA
BM 464
BM 395
BM 462
BM 386
BM 390
BM 388