


OFFICE OF THE
DOUGLAS COUNTY SURVEYOR

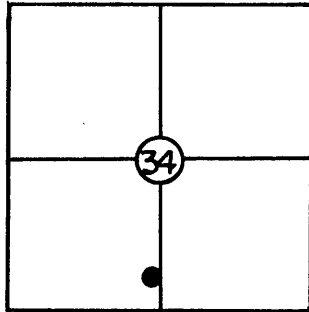

DESIGNATION L-019

NGVD 29

VERTICAL CONTROL

Elevation: 15.427 USC&GS Line # 16 USGS Line # _____

Order
Of Precision 3rd Agency: OSHD Proj. #: _____ Date: 10/81

HORIZONTAL CONTROL

Oregon State Plane Coordinates: Y(Northing) _____ X(Easting) _____
(South Zone)


Order
Of Precision _____ Agency: _____ Proj. #: _____ Date: _____

Approximate Geographic Position: Latitude= _____ Longitude= _____

DESCRIPTION: Station mark is a standard
(unstamped) OSHD brass cap set in West end
of bridge over Dean Creek on Hwy 138. Wing-
wall is on South side of Hwy 138, approx.
1/2 ft. below asphalt and approx. 1 ft. -
South of guardrail. Now stamped "L687
DCSO 1981".

VICINITY: 5 1/2 miles ESE of Reedsport,
at Dean Creek.

SKETCH

 

NOTE: For Possible Further Information On This Station, Please Contact The Douglas County Surveyors Office, Rm. 205 Douglas County Justice Bldg., Roseburg, OR. 97470 Phone 672-3311 Ext. 272.. Douglas County residents outside the Roseburg calling area dial toll free 1-800-452-0991.