


OFFICE OF THE

DOUGLAS COUNTY SURVEYOR

u-025
U-23

24S 7W 22

NAD 673013.13 4120561.29
83 43°28'26" 123°31' 2"

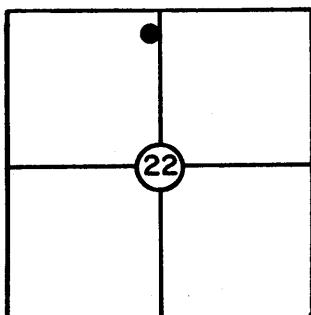

T 24 S, R 7W, Sec. 22

Station: U-23

Set By (Agency): DCSO

Date: 1972

VERTICAL CONTROL

NGVD 29

Elevation: 288.279 NGS(USC&GS) Line # _____ USGS Line # _____

Order
Of Precision 2nd Agency: DCSO Proj. #: 2006 Date: 1972

HORIZONTAL CONTROL

NAD 27

Oregon State Plane Coordinates: Y(Northing) 673,047.25 X(Easting) 1,199,602.09
(South Zone)

Order
Of Precision 1/25,000 Agency: DCSO Proj. #: 2006 Date: 1972

Approximate Geographic Position: Latitude= _____ Longitude= _____

DESCRIPTION: Brass cap set in concrete

belltile, survey marker alongside. Approx.


22 ft. from centerline & approx. 3 ft. from

top of fill.

VICINITY: From Umpqua go W'stly on Tyee

Rd 18.7 mi.

SKETCH

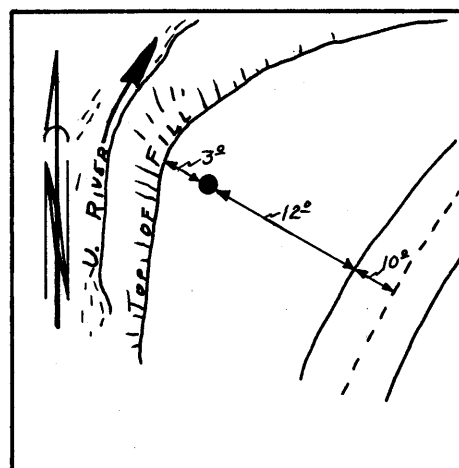

NOTE: For Possible Further Information On This Station, Please Contact The Douglas County Surveyors Office, Rm. 205 Douglas County Justice Bldg., Roseburg, OR. 97470 Phone 672-3311 Ext. 272.. Douglas County residents outside the Roseburg calling area dial toll free 1-800-452-0991.