

OFFICE OF THE  
DOUGLAS COUNTY SURVEYOR

U-005  
U-5

255 6W 31


NAD 626189.77 4136791.38  
83 43°20'49" 123°26'60"

T 25 S, R 6 W, Sec. 31

Station: U-5

Set By (Agency): DCSO

Date: 1972

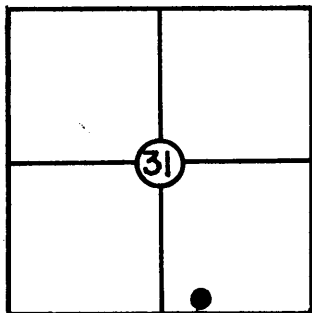

U-005

VERTICAL CONTROL

NGVD 29

Elevation: 372.718 NGS(USC&GS) Line # \_\_\_\_\_ USGS Line # \_\_\_\_\_

Order  
Of Precision 2nd Agency: DCSO Proj. #: 2007 Date: 1991

HORIZONTAL CONTROL

NAD 27

Oregon State Plane Coordinates: Y(Northing) 626,224.55X(Easting) 1,215,832.60  
(South Zone)


Order  
Of Precision 1/25,000 Agency: DCSO Proj. #: 2006 Date: 1981 (Calapooya)

Approximate Geographic Position: Latitude= 43° 20' 50" Longitude= 123° 26' 55"

DESCRIPTION: From Umpqua Post Office go  
West 0.3 mi., thence South on Garden Valley  
Rd.(Rd. #6) 1.5 mi. to Cal Henry Rd. Point  
is SE of rd. near fence, which is 3' E'stly.  
PP&L power pole bears N 6° E 28.5' (true)  
Tele Pd. bears N 6° E 21' (true)

VICINITY: Intersection of Garden Valley  
Rd. and Cal Henry Rd.

SKETCH

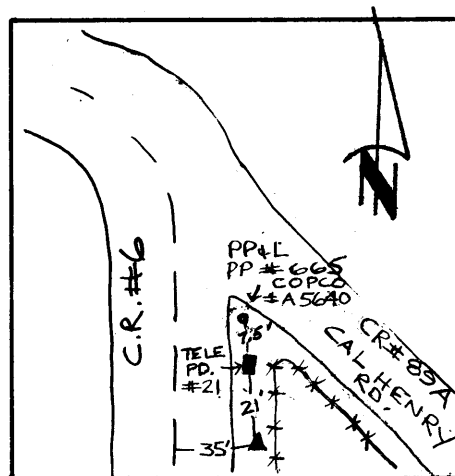

NOTE: For Possible Further Information On This Station, Please Contact The Douglas County Surveyors Office, Rm. 205 Douglas County Justice Bldg., Roseburg, OR. 97470 Phone 672-3311 Ext. 272.. Douglas County residents outside the Roseburg calling area dial toll free 1-800-452-0991.