


OFFICE OF THE
DOUGLAS COUNTY SURVEYOR

U-009
U-9

25S 7W 10

NAD 647598.92 4118157.59
83 43°24'14" 123°31'22"

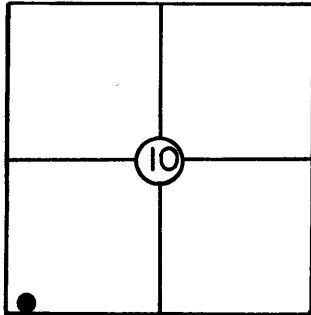

U-009

T 25 S, R 7W, Sec. 10

Station: U-9

Set By (Agency): DCSO

Date: 1972

VERTICAL CONTROL

NGVD29

Elevation: 310.507 NGS(USC&GS) Line # USGS Line #

Order
Of Precision 2nd Agency: DCSO Proj. #: 2006 Date: 1973

HORIZONTAL CONTROL

NAD 27

Oregon State Plane Coordinates: Y(Northing) 647,633.52 X(Easting) 1,197,198.63
(South Zone)

Order
Of Precision 1/25,000 Agency: DCSO Proj. #: 2006 Date: 1972

Approximate Geographic Position: Latitude= Longitude=

DESCRIPTION: FROM UMPQUA POST OFFICE GO 6.6

MILES N. ON TYEE-UMPQUA RD #33. POINT

IS IN VERY LARGE BOULDER 15'x15'x10', IN


UMPQUA RIVER POINT IS 75 FT. S.E. OF RD.

SIDE.

VICINITY: NEAR BOTTLE CREEK JUNCTION WITH

UMPQUA RIVER.

SKETCH

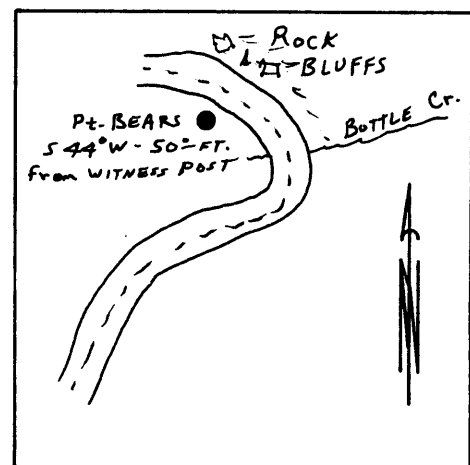

NOTE: For Possible Further Information On This Station, Please Contact The Douglas County Surveyors Office, Rm. 205 Douglas County Justice Bldg., Roseburg, OR. 97470 Phone 672-3311 Ext. 272. Douglas County residents outside the Roseburg calling area dial toll free 1-800-452-0991.