



OFFICE OF THE
DOUGLAS COUNTY SURVEYOR

M-006

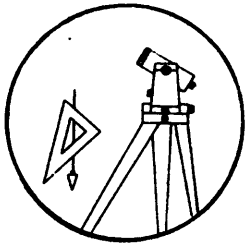

Station: M 480 T 26 S, R 5 E , Sec 35
 Set By (Agency): USC & GS
 Date Set: 1941
 Recovered By FLI (DCSO)
 Date Recovered 7-23-84
 Recovered By _____
 Date Recovered _____
 Recovered By _____
 Date Recovered _____

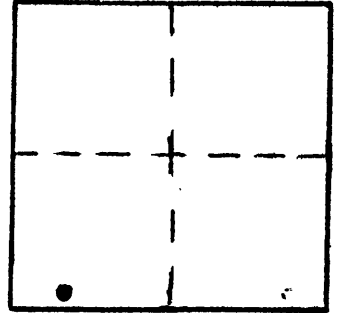

VERTICAL CONTROL NGVD 29

Elevation: 4415.247 NGS Line # 94 USGS Line # _____ OSHD Line # _____
 Precision: 1st Agency: USC & GS Proj. # _____ Date: 1961

HORIZONTAL CONTROL

South Zone State Plane Coordinates: Y(Northing) _____ X(Easting) _____
 Precision: _____ Agency: _____ Proj. # _____ Date: _____
 Approximate Geographic Position: Latitude _____ Longitude _____

DESCRIPTION and TO REACH

SKETCH

0.4 miles west along Highway
 138 from intersection of Highway
 138 & USFS Road Number 999 (Form-
 erly 4780).

Brass cap in concrete post,
 250 ft. south of edge of pavement
 of Highway 138, 22 ft. north of old
 overgrown road, 3 ft. higher than
 old road.

Reference Marks:

Note: For further information, contact the Douglas County Surveyor's Office, Room 205
 Douglas County Justice Building, Roseburg, OR 97470. Phone 440-4278. Douglas
 County residents outside the Roseburg calling area, dial toll free 1-800-452-0991.