


OFFICE OF THE
DOUGLAS COUNTY SURVEYOR

C-159

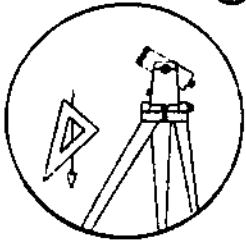

Station: CARRKO

T 21 S, R 5W, Sec 21


Date Set: 1998

Set By (Agency): DCSO

Date Recovered: 7-14-98

Recovered By: RWS SJF

- Found
- New
- Reset
- Not Found
- Referenced
- Destroyed

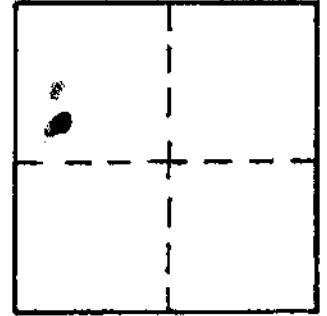

VERTICAL CONTROL NGVD 29

Elevation: 484.39 NGS Line # _____ USGS Line # _____ OSHD Line # _____

Precision: 3rd Agency: DCSO Proj. # 2007 Date: 1998

HORIZONTAL CONTROL

South Zone O.C.S. 27: Y(Northing) _____ X(Easting) _____

South Zone O.C.S. 83: Y(Northing) _____ X(Easting) _____

Precision: _____ Agency: _____ Proj. # _____ Date: _____

Approx. NAD 83 Geographic Position: Latitude 43 12 41 Longitude 123 18 05

DESCRIPTION and TO REACH

A 3 INCH DIAMETER DCSO DRILL CAP STAMPED "CARRKO 1998"
SET FLUSH IN TOP OF CONCRETE BRIDGE ABUTMENT.

MONUMENT LIES JUST SOUTH (SEE SKETCH) FROM INTERSECTION
OF DOUGLAS AVENUE (CO. RD. #4A) AND DAWSON ROAD (CO. RD. 148)
IN T27S, R5W, SEC 21,

Reference Marks:

