



OFFICE OF THE
DOUGLAS COUNTY SURVEYOR
76-005

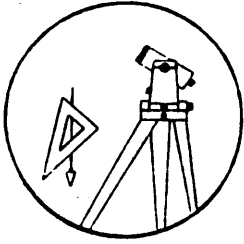

Station: 133 B B
Date Set: 1919
Set By (Agency): USGS
Date Recovered: 12/28/98
Recovered By: SJF

T 22 S, R 8W, Sec 14

- Found New
 Reset Not Found
 Referenced Destroyed

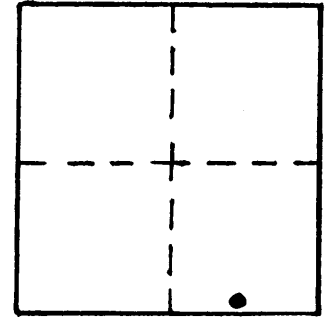

VERTICAL CONTROL NGVD 29

Elevation: 133.622 FT. NGS Line # _____ USGS Line # 16 OSHD Line # _____
Precision: 1st Agency: USC&GS Proj. # _____ Date: 1958

HORIZONTAL CONTROL

South Zone O.C.S. 27: Y(Northing) _____ X(Easting) _____
South Zone O.C.S. 83: Y(Northing) _____ X(Easting) _____
Precision: _____ Agency: _____ Proj. # _____ Date: _____
Approx. NAD ⁸³ Geographic Position: Latitude 43° 39' 02" Longitude 123° 36' 32"

DESCRIPTION and TO REACH

A 4 INCH DIAMETER USGS DISK STAMPED " B 133 B 1919 " SET NEAR THE HIGHEST POINT OF A PARTIALLY BURIED BOULDER, THE LARGEST DIMENSION OF WHICH IS APPROXIMATELY 4 5 FEET, AND WHICH PROTRUDES APPROXIMATELY 3 FEET ABOVE GROUND.

FROM THE INTERSECTION OF STATE HIGHWAY 138 AND STATE HIGHWAY 38 IN T22S, R7W, SECTION 29 PROCEED NORTHWESTERLY ALONG STATE HIGHWAY 38 APPROXIMATELY 2.45 MILES TO MILE POINT 33.7 AND MONUMENT TO RIGHT, APPROXIMATELY 250 FT NORTHERLY FROM ROAD.

Reference Marks:

