OFFICE OF THE
DOUGLAS COUNTY SURVEYOR

Station: 17-2
Date Set:
Set By (Agency): CITY (RSBG)
DCSO Designation: #-062
Date Recovered: 5-82
Recovered By: SJF
Date Recovered: ~~R.W.S.~~ SJF
Recovered By: 2000
Date Recovered:
Recovered By:

T27W R6W Sec. 14

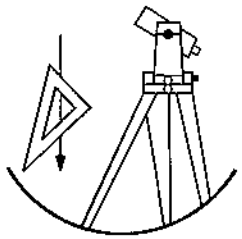

#-062

VERTICAL CONTROL

NGVD 29 Elevation: ~~434.06~~ 434.07 FEET NAVD 88 Elevation: METERS

NGS Line # USGS LINE # OSHD Line # FILE #

Precision: 3RD ORDER Agency: ~~CITY (RSBG)~~ DCSO ~~Proj~~ CS# 66138 Date: 2000

HORIZONTAL CONTROL

O.C.S. 27 Y(Northing): 581,503.63 O.C.S. 83 Y(Northing): 581,468.52

(South Zone) X(Easting): 1,232,273.31 (South Zone) X(Easting): 4,153,231.66

Precision: 1/25,000 Agency: DCSO Proj: 2005-2 Date: 1983

Approx. O.C.S. 27 Geographic Position: Latitude: 43°13'34.0" Longitude: 123°22'52.0"

Approx. O.C.S. 83 Geographic Position: Latitude: 43°13'33" Longitude: 123°22'56"

Found: A disk stamped "17-2" set flush in concrete curbing.

To reach: Go to the intersection of NW Jefferson St. and NW Cherry Dr.

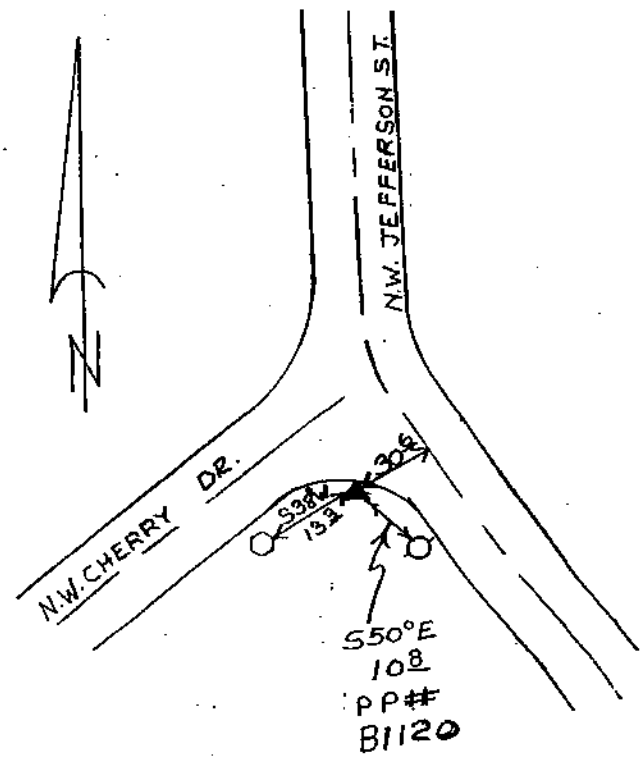

Note: For further information contact the Douglas County Surveyors Office, Room 205 Douglas County Justice Building, Roseburg, OR 97470. Phone 440-4272. Douglas County Residents outside Roseburg calling area, dial toll free 1-800-477-0991.