OFFICE OF THE

DOUGLAS COUNTY SURVEYOR

Station: 16 D 18

Date Set: 1928

Set By (Agency): BPR

DCSO Designation: #-149

Date Recovered: 9-28-93

Recovered By: RWS-SJF

Date Recovered:

Recovered By:

Date Recovered:

Recovered By:

T31S R2W Sec.24

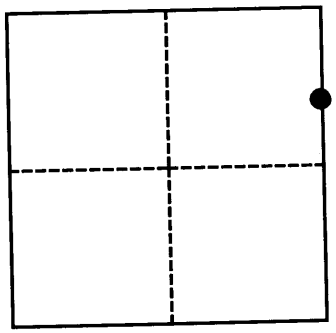

VERTICAL CONTROL

NGVD 29 Elevation: 1441.059 FEET NAVD 88 Elevation: METERS

NGS Line # USGS LINE # OSHD Line # FILE #

Precision: 2ND ORDER Agency: DCSO Proj: 2020 Date: 1993

HORIZONTAL CONTROL

O.C.S. 27 Y(Northing): O.C.S. 83 Y(Northing):

(South Zone) X(Easting): (South Zone) X(Easting):

Precision: Agency: Proj: Date:

Approx. O.C.S. 27 Geographic Position: Latitude: 42°52'09" Longitude: 122°52'54"

Approx. O.C.S. 83 Geographic Position: Latitude: Longitude:

Found: A 2 7/8" diameter BPR disk stamped "16 D 18 1928" set in a 8" diameter concrete post flush with ground.

To reach: From the intersection of Tiller Trail Hwy. (Co. Rd. #1) and South Umpqua Hwy. (Co. Rd. #46) in T30S R2W Sec. 33 proceed southeasterly along Tiller Trail Hwy. 6.7 miles to monument on right. Monument is 1.5 miles southeast of Drew.

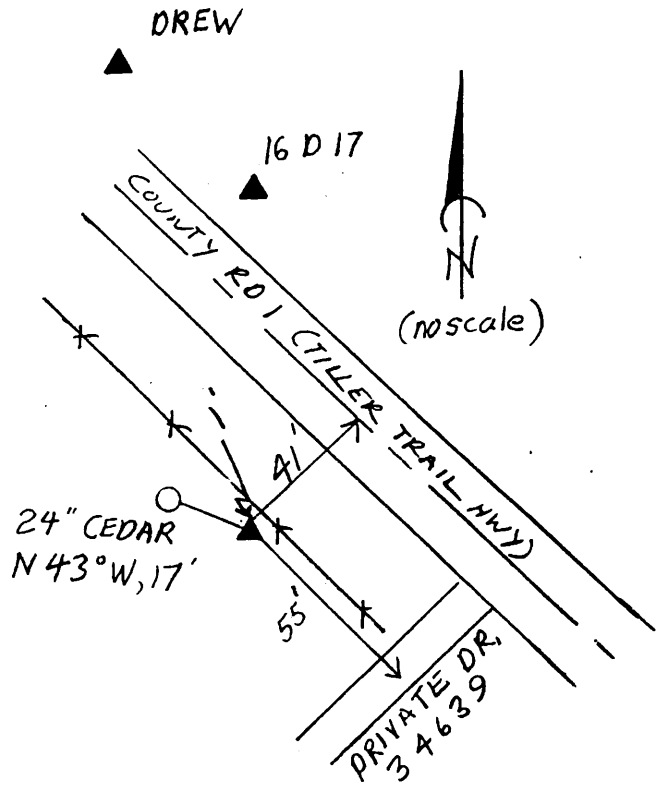

Note: For further information contact the Douglas County Surveyors Office, Room 205 Douglas County Justice Building, Roseburg, OR 97470. Phone 440-4272. Douglas County Residents outside Roseburg calling area, dial toll free 1-800-477-0991.