DOUGLAS COUNTY SURVEYOR'S OFFICE

Designation: #-152 Station: 28S2W1 ECC1 1986 1995 T 28S R 2W S 1 ¼ A

Date Set: 1986 Set by (Agency): U S FS

Date Recovered: 11/13/97 Recovered by: DCSO

☒ Found ☐ New ☐ Reset

☐ Not Found ☐ Referenced ☐ Destroyed

VERTICAL CONTROL

NGVD 29 Elevation: _____ Feet File # _____

Precision: _____ Agency: _____ Project: _____ Date: _____

NAVD 88 Elevation: _____ Meters File # _____

Precision: _____ Agency: _____ Project: _____ Date: _____

HORIZONTAL CONTROL - south zone

N _____ E _____ Datum/Adj.: 1927 Precision: SCALED

Lat: 43° 09' 55" Long: 122° 52' 47" Agency: _____ File # _____ Date: _____

N _____ E _____ Datum/Adj.: _____ Precision: _____

Lat: _____ Long: _____ Agency: _____ File # _____ Date: _____

N _____ E _____ Datum/Adj.: _____ Precision: _____

Lat: _____ Long: _____ Agency: _____ File # _____ Date: _____

N _____ E _____ Datum/Adj.: _____ Precision: _____

Lat: _____ Long: _____ Agency: _____ File # _____ Date: _____

DESCRIPTION AND TO REACH
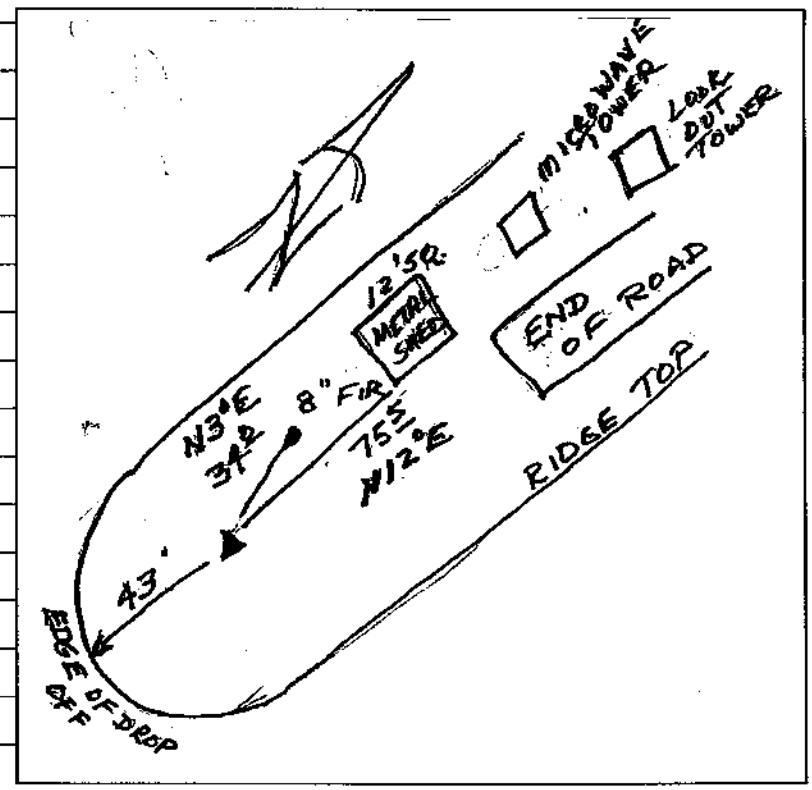
SEE NGS WEBSITE