

Field Book # 59

DOUGLAS-COUNTY

1911

Date

F.B., 59.

No 4

FIELD BOOK

59

505

W. H. ...  
New ...  
and ...

Pays for Mrs Barry

1085  
185  
202  
332  
151

2655  
1327

29  
54  
15

522  
495  
27

522  
443  
79  
4  
2  
5-4  
27  
495

From Mrs South 635  
" " 511412 524

109160  
1085

9924  
9924  
77

859  
484  
375

Index. Book No. A.

| Name               | Sec. or DLC | Twp and Range | Cor. Sect. | date        | Page                |
|--------------------|-------------|---------------|------------|-------------|---------------------|
| Elliott, E.W.      | DLC. 51.    | 30-5          |            | Nov 7/1911  | 2-3-4               |
| Lorrigan W.S.      |             | 29-4          |            | Dec. 1911   | 13-14               |
| Puckett C.W.       | Sec. 34.    | 28-4          |            | Dec. 9/1911 | 7-8                 |
| Riddle Water Sply. |             |               |            |             | 17 - To end of book |
| School dist 127.   |             | 32-4          |            | Nov 21/1911 | 66                  |
| White, J.C.        | DLC 44      | 30-5          |            | Dec 8/1911  | 9-12                |





Nov 21 1911

Survey for School Dist - 127

Geo. Cheney and Ed Olinghouse - Chairman - Fairview Marker -

Beginning at a point <sup>613.8</sup> 405.5 ft East and 1326.4 South of the

Center of Sec 33 to 32.5 ft N

Thence East 573 ft to place of beginning

- 1 N 29° E 262 "
- 1 S 61° E 185 "
- 1 S 29° W 62 "
- 1 S 58° W 112 "
- 1 N 80° W 159 "
- 1 N 31 1/2° E 181 "
- 1 N 29° E 512 "

569  
 27  
 586  
 594

75

529  
 4.3  
 573.3

6

7 DEC 5 1911

Survey for C.W. Puckett

Beginning at a point 2018 chs. East and 6.54 chs North of the S.W. Cor' of Sec 34 T<sub>28</sub>S. R<sub>4</sub>N

Thence N82°E 1.37 chs.

" S88°E 2.43 "

" N41°E 2.78 "

" S. 81°45'E 1.69 "

" S. 55°30'E 3.64 "

" N38°45'E 2.65 "

" S81°30'E 2.33 "

" S57°30'E 3.92 "

" N74°45'E 1.58 "

" N25°E 1.52 "

" North 6.50 "

" S74°30'N 7.92 "

" S78°45'N 11.24 "

" N89°N 1.04 "

" South 3.55 "

to place of beginning Cont 8.98 chs.

Also for road purposes only A strip of land 10 feet wide on each side of the center line described as beginning at a point 2018 chs East and 10.24 chs North of the S.W. Cor' of Sec 34 T<sub>28</sub>S. R<sub>4</sub>N

Thence S89°E 1.04 chs

" N78°45'E 11.24 "

" N74°30'E 7.92 "

9

Dec 8 1911

Survey for John C. White

Beginning at a point in

Fence South Var 2/35E

N 29° 40'

1294.0

1200'

S 81° 58' E

1000'

N 71° 00' W

1423.5

S 87° 39' W

1379.8

N 83° 23' W

1507.5

1507.5

10

100  
100  
100

Center of Road

Var 2/35E

1000' to Green

1000' to Green

Cont 49.12 acs

to place of

of 351/2

187' West end of 1/2 SE cor

192' 20' 45" E

192' 20' 45" E

81.77  
10.22  
91.55

655 ft 8 in

Point  
Road  
100  
100  
100

7th Blue print 30-5 for 12

8810  
 $\frac{44}{57} = \frac{22}{28.5}$

Wilson - Cole Hydrograph

100 ft from left bank

13795  
 838  
 541.8  
 780  
 239.8

1368  
 315  
 1899.5

1348 + 315

to point 95 ft

100 ft from left bank

Point 400

570.25 E  
 75.05 N  
 584.25 E

South 1189.0  
 588.05 N  
 84.05 E  
 585.0 N

BC 9177.29 91-2 point

SE Cor of 17c N Preston Bl

There is 588.40 N 84.4 ft

11 N 83.23 N 160.7

11 North 140.1

11 East 995

11 S 70.06 E 234.1

11 S 75.5 E 401.0

11 South 1220 to place of

Cont 3 1/2 acc

533.5 West end 23.0 South of the  
 42.770 30.575 N 104.2111 E

13

Dec

Survey of 40 acs for NW 5<sup>th</sup> Longitude

Beginning 914 point West of the corners 78.17, 18.76, 29-4

Thence S 25° 45' N 12.36 chs

" EAST 37.15 "

" NORTH 10.48 "

" WEST 32.57 " to

place of beginning Cont 40.019

Correction for above

S 25° 45' N 12.86 chs

East 37.65 "

North 11.58 "

West 32.07 Cont 40.3 acs

$$\begin{array}{r} 26 \\ 6.4 \\ \hline 32.4 \\ 2.4 \\ \hline 34.8 \end{array}$$

14

South 1/2 Sec 17-18 29-4  
 170' at NW corner 20 chs = 600  
 550' with 1/2 section toward  
 4000 1/4 part  
 1/2 section 10" 560' 26  
 " " 6 1737 29

15

Dec

1911

Survey for ETP Messer  
Beginning at a point  
between sections

1500 chs west of  $\frac{1}{4}$  sec cor  
T10 R29 S. R. 21 N

16

17

Riddle Water Supply

| Sta  | +     | +      | -     | R     | E      |   |
|------|-------|--------|-------|-------|--------|---|
| B.M. | 2.07  | 707.07 |       |       | 705.00 | U.S.S. B.M. Riddle, Ore                           |
| Δ    |       |        | 7.63  | 4.62  | 702.45 | Top of curb at E. line of Bank                    |
| ○    | 0.96  | 700.40 |       |       | 699.44 |   |
| Δ    |       |        | 9.67  | 3.95  | 696.45 | Top of curb at Harness Shop                       |
| ○    | 6.13  | 696.86 |       |       | 699.73 |   |
| Δ    |       |        | 11.93 | 3.31  | 693.55 | Top of sidewalk curb 10' E. of Concrete gate post |
| ○    | 1.48  | 686.58 | 11.76 |       | 685.10 |   |
| ○    | -0.02 | 674.63 | 11.93 |       | 674.65 |   |
| B.M. |       |        |       | 4.56  | 670.07 | On East. Approach of Sew. Cr. Bridge              |
| ○    | 5.32  | 677.26 | 2.69  |       | 671.94 |   |
| ○    | 5.48  | 678.14 | 4.60  |       | 672.66 |   |
| ○    | 8.84  | 686.98 | 0.00  | 11.82 | 678.14 |   |
| Δ    |       |        | 0.00  |       | 675.16 | At 17 Road  |
| ○    | 11.06 | 698.04 | 0.00  |       | 686.98 |   |
| ○    | 11.77 | 709.81 | 0.00  |       | 698.04 | At 7th Road                                       |
| ○    | 11.60 | 721.41 | 0.00  |       | 709.81 |   |
| ○    | 11.44 | 732.85 | 0.00  |       | 721.41 |   |
| ○    | 11.34 | 744.19 | 0.00  |       | 732.85 |   |
| ○    | 8.17  | 752.36 | 0.00  |       | 744.19 |   |
| ○    | 11.26 | 763.62 | 0.00  |       | 752.36 |   |
| ○    | 11.49 | 775.11 | 0.00  |       | 763.62 |   |
| ○    | 11.67 | 786.78 | 0.00  |       | 775.11 |   |
| ○    | 11.98 | 798.76 | 0.00  |       |        |   |
| ○    | 11.99 | 810.75 | 0.00  |       |        |   |
| ○    | 11.89 | 822.64 | 0.00  |       |        |   |

778.2  
700.27  
777.97

19

722

| Sta  | +     | I      | -    | R    | E      |
|------|-------|--------|------|------|--------|
| 0    | 11.70 | 822.64 | 0.00 |      | 822.64 |
| 0    | 11.01 | 834.34 | 0.00 |      | 832.34 |
| 0    | 10.79 | 845.35 | 0.00 |      | 843.35 |
| 0    | 11.15 | 856.14 | 0.00 |      | 854.14 |
| 0    | 11.92 | 867.29 | 0.00 |      | 865.29 |
| 0    | 11.84 | 879.21 | 0.00 |      | 877.21 |
| 0    | 11.45 | 891    | 0.00 |      | 889.05 |
| 0    | 10.69 | 897.05 | 0.00 |      | 909.50 |
| 0    | 11.96 | 908.50 | 0.00 |      | 911.19 |
| 0    | 7.82  | 917.19 | 0.00 | 3.06 | 922.09 |
| 0    | 7.87  | 925.15 | 0.00 |      | 919.00 |
| 0    | 3.36  | 928.82 | 6.65 |      | 923.15 |
| 0    | 5.54  | 929.22 | 7.47 |      | 924.35 |
| 0    | 4.55  | 929.50 | 3.08 |      | 926.14 |
| 0    |       | 928.66 | 6.38 |      | 923.18 |
| B.M. |       | 929.46 | 1.75 | 4.13 | 926.91 |
|      |       |        |      |      | 927.33 |

B.M. B. 4' diam

Level Reservoir Site

21

22

| S/A   | T    | -    | R   | E      |
|-------|------|------|-----|--------|
| 0     | 3.02 |      |     | 675.16 |
| 0     | 7.56 | 5.84 |     | 672.34 |
| 5+39  |      |      | 6.7 | 673.2  |
| 6     |      |      | 5.9 | 674.0  |
| 7     |      |      | 5.4 | 674.5  |
| 8     |      |      | 6.1 | 673.8  |
| 9     |      |      | 6.2 | 673.7  |
| 10    |      |      | 7.5 | 672.4  |
| 10+88 |      |      | 6.2 | 673.7  |
| 11    |      |      | 6.3 | 673.6  |
| 12    |      |      | 4.4 | 675.5  |
| 13    |      |      | 2.1 | 677.8  |
| 14    |      |      | 5.0 | 674.9  |
| 15    |      |      | 5.0 | 674.9  |
| 16    | 6.12 | 3.47 |     | 676.43 |
| 16    |      |      | 5.8 | 676.7  |
| 17    |      |      | 7.0 | 675.5  |
| 18    |      |      | 6.9 | 675.6  |
| 19    |      |      | 6.7 | 675.8  |
| 20    |      |      | 5.7 | 676.8  |
| 21    |      |      | 5.2 | 677.3  |
| 22    |      |      | 2.6 | 677.9  |
| 440   |      |      | 3.6 | 678.9  |
| 0     | 9.16 | 0.76 |     | 681.79 |
| 23    | 4.75 |      | 7.9 | 683.0  |

= 2483

Mouth small creek

23

| Sta     | t      | -    | R     | E      |
|---------|--------|------|-------|--------|
| 24      | 690.95 |      | 4.9   | 686.0  |
| 25      |        |      | 1.7   | 689.2  |
| 26      |        |      | 4.4   | 686.5  |
| 27      |        |      | 1.2   | 689.7  |
| 27 + 20 |        |      | 4.9   | 686.0  |
| 28      | 700.19 | 0.68 |       | 690.27 |
| 29      |        |      | 7.9   | 692.9  |
| 30      |        |      | 4.7   | 695.5  |
| 30      |        |      | 1.8   | 698.4  |
| 31      | 706.75 | 0.55 |       | 699.64 |
| B.M.    |        |      | 7.33  | 699.42 |
| 31      |        |      | 6.1   | 700.6  |
| 32      |        |      | 6.2   | 700.5  |
| 33      |        |      | 5.0   | 701.7  |
| 34      |        |      | 3.5   | 703.2  |
| 35      |        |      | 2.4   | 704.3  |
| 36      |        |      | 3.7   | 703.0  |
| 37      |        |      | 8.1   | 698.6  |
| 37      |        |      | 7.3   | 699.43 |
| 38      | 701.52 | 7.32 | 10.00 | 691.5  |
| + 90    |        |      | 12.2  | 689.3  |
| 39      |        |      | 19.0  | 690.5  |
| 40      |        |      | 1.8   | 699.7  |
| 41      |        |      | 1.0   | 700.5  |
| 41      | 707.29 | 0.97 |       | 700.55 |

Bottom Small Creek

On B.O. 26' diam 14' L of Sta 30 + 17

Sta 33 + 50 opposite Cains House

Bottom of small Creek

24

2.5

26

|      | T      | -     | R    | E      |
|------|--------|-------|------|--------|
| 5/2  |        |       |      |        |
| 42   | 707.29 |       | 5.7  | 701.6  |
| 43   |        |       | 3.4  | 703.9  |
| 44   |        |       | 3.1  | 704.2  |
| 45   |        |       | 3.6  | 703.7  |
| 46   |        |       | 7.9  | 699.4  |
| 47+  |        |       | 11.6 | 695.7  |
| 48   |        |       | 5.0  | 702.3  |
| 0    | 422    | 5.02  |      | 703.27 |
| 49   |        |       | 1.8  | 704.7  |
| 50   |        |       | 6.8  | 699.8  |
| 0    | 488    | 11.64 |      | 694.85 |
| 51   |        |       | 8.1  | 691.65 |
| + 30 |        |       | 12.5 | 687.15 |
| 52   |        |       | 10.4 | 689.3  |
| 53   |        |       | 6.9  | 692.8  |
| 54   |        |       | 2.1  | 697.6  |
| 55   |        |       | 1.8  | 697.9  |
| 0    | 10.33  | 1.13  |      | 698.60 |
| 56   |        |       | 5.0  | 703.9  |
| 57   |        |       | 3.1  | 705.8  |
| 58   |        |       | 4.5  | 704.4  |
| 59   |        |       | 6.9  | 702.10 |
| + 75 |        |       | 9.5  | 699.4  |
| 60   |        |       | 7.4  | 701.5  |
| 0    | 9.12   | 0.80  |      | 708.13 |

Bottom small Creek

DRAW

27

Sta

|      | +    | x      | -    | R   | F      |
|------|------|--------|------|-----|--------|
| 61   |      | 717.25 |      | 7.5 | 709.7  |
| + 01 |      |        |      | 7.0 | 710.2  |
| 62   |      |        |      | 4.9 | 712.3  |
| 63   |      |        |      | 3.9 | 713.3  |
| 64   |      |        |      | 2.5 | 714.7  |
| 0    | 9.32 | 724.36 | 2.21 |     | 715.04 |
| 65   |      |        |      | 7.4 | 717.0  |
| 66   |      |        |      | 6.1 | 718.3  |
| B.M. |      |        |      | 4.2 | 720.24 |
| 67   |      |        |      | 4.7 | 719.7  |
| 68   |      |        |      | 1.9 | 721.5  |
| X    |      |        | 1.72 |     |        |
| B.M. | 8.36 | 728.60 |      |     | 720.24 |
| 69   |      |        |      | 4.7 | 723.9  |
| 70   |      |        |      | 4.4 | 724.2  |
| 71   |      |        |      | 2.2 | 726.4  |
| 72   |      |        |      | 0.9 | 727.7  |
| 0    | 5.00 | 732.95 | 0.65 |     | 727.95 |
| 73   |      |        |      | 3.5 | 729.4  |
| 74   |      |        |      | 4.4 | 728.56 |
| 75   |      |        |      | 7.0 | 725.9  |
| 76   |      |        |      | 7.1 | 725.8  |
| 77   |      |        |      | 5.1 | 727.8  |
| 78   |      |        |      | 2.4 | 730.5  |

On Laurel 10' R Sta 66+66

28

| Sta     | +     | +                | -    | R    | E      |
|---------|-------|------------------|------|------|--------|
| 0       | 11.73 | 732.95<br>742.55 | 2.13 |      | 730.82 |
| 79      |       |                  |      | 9.6  | 733.0  |
| 80      |       |                  |      | 7.3  | 735.3  |
| 81      |       |                  |      | 4.7  | 737.9  |
| 82      |       |                  |      | 3.1  | 739.5  |
| 83      |       |                  |      | 1.8  | 740.8  |
| 84      | 10.23 | 751.56           | 1.22 |      | 741.33 |
| 85      |       |                  |      | 8.6  | 743.0  |
| 86      |       |                  |      | 5.6  | 746.0  |
| 87      | 11.32 | 761.75           | 1.13 | 2.1  | 749.5  |
| 88      |       |                  |      | 8.5  | 753.2  |
| 89      | 10.65 | 772.40           | 0.00 | 2.9  | 758.8  |
| 90      | 11.30 | 783.70           | 0.00 | 4.7  | 761.75 |
| 91      | 7.92  | 791.62           | 0.00 | 5.1  | 767.7  |
| 92      |       |                  |      | 4.8  | 772.40 |
| 93 + 50 |       |                  |      | 3.4  | 778.6  |
| 94      |       |                  |      | 4.8  | 783.70 |
| BM      |       |                  |      | 7.8  | 786.8  |
| 95      |       |                  |      | 6.6  | 788.2  |
| 96      |       |                  |      | 1.92 | 789.7  |
|         |       |                  |      | 6.5  | 785.1  |
|         |       |                  |      | 0.2  | 791.4  |

DRAW

80.6" 15' 1 5/8 92 + 60

31

32

|     | +     | T                  | -    | R    | E               |
|-----|-------|--------------------|------|------|-----------------|
| 96  | 11.57 | 791.62<br>803.19 ✓ | 0.00 |      | 791.62<br>800.8 |
| 97  |       |                    |      | 2.4  |                 |
| 98  | 5.08  | 808.27 ✓           | 0.00 | 2.7  | 803.19<br>805.6 |
| 99  |       |                    |      | 2.2  | 806.1           |
| 100 |       |                    |      | 7.2  | 801.1           |
| 101 |       |                    |      | 4.1  | 804.2           |
| 102 |       |                    |      | 3.6  | 804.7           |
| 103 |       |                    |      | 1.6  | 806.7           |
| 104 | 11.29 | 819.56 ✓           | 0.00 |      | 808.27          |
| 105 |       |                    |      | 10.9 | 808.8           |
| 106 |       |                    |      | 8.7  | 810.9           |
| 107 |       |                    |      | 3.4  | 816.2           |
| 108 | 11.71 | 831.27 ✓           | 0.00 |      | 819.56          |
| 109 |       |                    |      | 5.6  | 825.7           |
| 110 | 7.67  | 838.94 ✓           | 0.00 |      | 831.27          |
| 111 |       |                    |      | 5.6  | 833.3           |
| 112 |       |                    |      | 1.0  | 837.9           |
| 113 |       |                    |      | 6.1  | 832.8           |
| 114 |       |                    |      | 7.5  | 831.4           |
| 115 | 2.77  | 837.14 ✓           | 4.57 | 9.4  | 829.5<br>834.37 |
|     |       |                    |      | 2.0  | 835.1           |
|     |       |                    |      | 6.9  | 830.21          |
|     |       |                    |      | 9.5  | 827.6           |

Drain

32

33

|      | +     | +      | -     | R    | E      |
|------|-------|--------|-------|------|--------|
| Sta  |       | 837.14 |       |      | 825.95 |
| 0    | 1.85  | 827.20 | 11.79 |      |        |
| 116  |       |        |       | 4.3  | 822.9  |
| 117  |       |        |       | 12.6 | 814.6  |
| 0    | 0.35  | 815.57 | 11.98 |      | 815.22 |
| 118  |       |        |       | 6.2  | 809.4  |
| B.M. |       |        |       | 6.75 | 808.82 |
| 119  |       |        |       | 9.4  | 806.2  |
| 120  |       |        |       | 9.2  | 806.4  |
| 121  |       |        |       | 5.4  | 810.2  |
| 0    | 8.27  | 823.84 | 0.00  |      | 815.57 |
| 122  |       |        |       | 8.0  | 815.8  |
| 123  |       |        |       | 5.8  | 818.0  |
|      |       |        |       | 11.5 |        |
|      |       |        |       | 12.5 | 812.3  |
| 124  |       |        |       | 5.1  | 818.7  |
|      |       |        |       | 3.0  | 820.8  |
| +47  |       |        |       | 4.9  | 818.7  |
| 125  |       |        |       | 9.0  | 814.8  |
| +25  |       |        |       | 0.3  | 823.5  |
| 126  |       |        |       |      | 823.84 |
| 0    | 11.28 | 835.12 | 0.00  |      |        |
| 127  |       |        |       | 10.4 | 824.7  |
| 128  |       |        |       | 8.4  | 826.7  |
| 129  |       |        |       | 2.9  | 832.2  |
| 0    | 9.52  | 844.64 | 0.00  |      | 834.12 |
| 130  |       |        |       | 7.7  | 836.9  |
| 131  |       |        |       | 6.7  | 837.9  |

M.O. 16" 5/8 117 + 60

DREN

34

|        | T      | -     | R    | F      |
|--------|--------|-------|------|--------|
| 132    | 844.64 |       | 4.1  | 840.5  |
| 133    |        |       | 1.6  | 843.0  |
| 0      | 8.23   | 0.00  |      | 844.64 |
| 134    |        |       | 6.6  | 846.3  |
| 135    |        |       | 4.4  | 848.5  |
| + 61   |        |       | 7.4  | 845.5  |
| 0      | 0.99   | 7.27  |      | 845.60 |
| 136    |        |       | 9.8  | 836.8  |
| + 25   |        |       | 12.3 | 834.3  |
| + 30   |        |       | 17.0 | 827.6  |
| + 35   |        |       | 12.4 | 834.2  |
| 137    |        |       | 1.0  | 845.6  |
| B.M.   | 5.90   | 0.80  |      | 845.79 |
| 138    |        |       | 5.0  | 846.7  |
| + 50   |        |       | 3.6  | 848.1  |
| 0      | 8.32   | 0.00  |      | 851.69 |
| 139    |        |       | 3.0  | 857.0  |
| 0      | 0.58   | 10.30 |      | 849.71 |
| 139+60 |        |       | 5.1  | 845.2  |
| 140    |        |       | 5.5  | 844.8  |
| 141    |        |       | 3.0  | 847.3  |
| 0      | 11.34  | 0.00  |      | 850.29 |
| 142    |        |       | 9.5  | 852.1  |
| 143    |        |       | 4.8  | 855.8  |
| 144    |        |       | 1.5  | 860.1  |
| 0      | 11.71  | 0.00  |      | 861.63 |
| 145    |        |       | 10.2 | 863.1  |

Bank of Draw  
10 DRAW  
Bank of Draw

4" W.O. DEAR 852.137+65 (18'R)

Conglomerate footit

139+60

|     | T      | -    | R    | F      |
|-----|--------|------|------|--------|
| 512 | 873.34 |      | 7.7  | 865.4  |
| 146 |        |      | 11.2 | 862.1  |
| +15 |        |      |      | Draw   |
| 147 |        |      | 4.0  | 869.3  |
| +60 |        |      | 6.9  | 866.4  |
| 148 |        |      | 4.2  | 869.1  |
| 149 |        |      | 3.4  | 869.9  |
| 150 |        |      | 0.1  | 873.2  |
| 0   | 9.50   | 0.00 |      | 873.34 |
| 151 |        |      | 7.3  | 875.5  |
| 152 |        |      | 4.9  | 877.9  |
| 153 |        |      | 2.1  | 880.7  |
| 0   | 10.94  | 0.00 |      | 882.84 |
| 154 |        |      | 10.8 | 883.0  |
| 155 |        |      | 5.5  | 888.3  |
| +26 |        |      | 4.1  | 889.7  |
| 156 |        |      | 4.9  | 888.9  |
| 157 |        |      | 1.7  | 891.9  |
| 0   |        |      |      |        |
| 0   | 7.32   | 0.00 |      | 893.78 |
| 158 |        |      | 6.1  | 895.0  |
| 159 |        |      | 0.9  | 900.2  |
| 0   | 8.70   | 0.00 |      | 909.10 |
| 160 |        |      | 6.1  | 903.7  |
| 161 |        |      | 8.2  | 901.6  |
| 162 |        |      | 7.6  | 902.2  |

39

Sta

+

909.80  
910.99

7.86

R

901.94

B.M

163

9.97

920.96

0.00

0.3

910.7

Alder 20"

10'R 5/8 162785

4.03

922.06

2.93

918.03

10.98

933.04

0.00

922.06

11.88

940.97

3.95

929.99

IF in bed of creek

7.99

948.96

0.00

940.97

6.72

955.68

0.00

948.96

947.5

B.M

947.87

✓ 24" Alder

40

Cross Section of Creek at Dam

41

| Sta    | +    | -      | R    | E      |                     |
|--------|------|--------|------|--------|---------------------|
| B.M    | 7.00 | 956.87 |      | 947.87 | Alder near Dam site |
| 0      |      |        | 4.6  | 952.3  | Sta 178+31          |
| 0+13 R |      |        | 7.0  | 949.9  |                     |
| 0+27 R |      |        | 9.45 | 947.42 | Water Edge          |
| 0+38 R |      |        | 10.2 | 946.7  | In Water on Bottom  |
| 0+47 R |      |        | 11.8 | 945.1  |                     |
| 0+50 R |      |        | 5.35 | 951.57 | High Water          |
| 0+57 R |      |        | 0.00 | 956.9  |                     |
| 0+45 L |      |        | 4.00 | 952.9  |                     |
| 0+52 L |      |        | 0.00 | 956.9  |                     |

| Sta    | +    | x      | -     | R    | F      |
|--------|------|--------|-------|------|--------|
| 43     |      |        |       |      |        |
| BM     | 900  | 956.87 |       |      | 947.87 |
| 178+31 |      |        |       | 4.6  | 952.3  |
| 178    |      |        |       | 5.9  | 951.0  |
| 177    |      |        |       | 9.9  | 947.0  |
| o      | 8.13 | 947.42 | 11.58 |      | 945.29 |
| 176    |      |        |       | 2.4  | 945.0  |
| 175+31 |      |        |       | 5.0  | 942.4  |
| 175    |      |        |       | 6.4  | 941.0  |
| 174    |      |        |       | 7.8  | 939.6  |
| 173    |      |        |       | 11.6 | 935.8  |
| o      | 4.86 | 946.57 | 11.71 |      | 935.71 |
| 172    |      |        |       | 8.8  | 931.8  |
| 171    |      |        |       | 11.3 | 929.3  |
| 170+77 |      |        |       | 12.0 | 928.6  |
| 170    |      |        |       | 10.7 | 929.9  |
| 169+67 |      |        |       | 11.5 | 929.1  |
| 169    |      |        |       | 11.3 | 929.3  |
| o      | 2.18 | 932.16 | 10.59 |      | 929.98 |
| 168    |      |        |       | 6.0  | 926.2  |
| o      | 4.59 | 924.93 | 11.82 |      | 920.34 |
| 167    |      |        |       | 9.2  | 915.7  |
| 166+80 |      |        |       | 15.0 | 909.9  |
| 166+44 |      |        |       | 8.5  | 916.4  |
| 166    |      |        |       | 9.7  | 915.2  |
| 165    |      |        |       | 6.0  | 918.9  |
|        | 2.76 | 457.0  | 15.70 |      |        |
|        |      | 22.9   |       |      |        |
|        |      | 22.9   |       |      |        |

L Bank of Creek  
 Bottom "  
 R Bank "

45  
Sta


|          | T                | -                     | R    | E      |
|----------|------------------|-----------------------|------|--------|
| 163      | 924.93<br>921.05 | 6.01                  | 4.8  | 918.92 |
| 164 + RR |                  |                       | 6.0  | 916.2  |
| 164      |                  |                       | 10.1 | 915.0  |
| 163      |                  |                       |      | 910.9  |
| 162      | 1.79 913.42      | 9.42                  | 59   | 911.63 |
| 161      |                  |                       | 96   | 907.5  |
| E.M.     |                  | 6.41                  |      | 903.8  |
|          | 3.92             | 2084<br>3.92<br>16.92 |      | 907.01 |

Alder old Sta 162 + 85 10' R


| Sta    | Hub  | Def      | C.C.      | M.C.      | To Cabin |
|--------|------|----------|-----------|-----------|----------|
| 170+77 | 110  | 10       | 567°45' W | 75'       |          |
| 172    | 1.23 | 28°53' L | N43°56' W | N44° W    |          |
| 173    |      | 13°15' L | N15°03' W | N15° W    |          |
| 174+55 | 331  |          |           |           |          |
| 175+31 |      | 43°46' R | N1°48' W  | N1°45' W  |          |
| 177+00 | 1.29 | 8°06' R  | N45°34' W | N45°30' W |          |
| 178+31 |      | 0°00'    | N53°40' W | N53°40' W |          |

Variation 2015 E

-0+00 of 2014

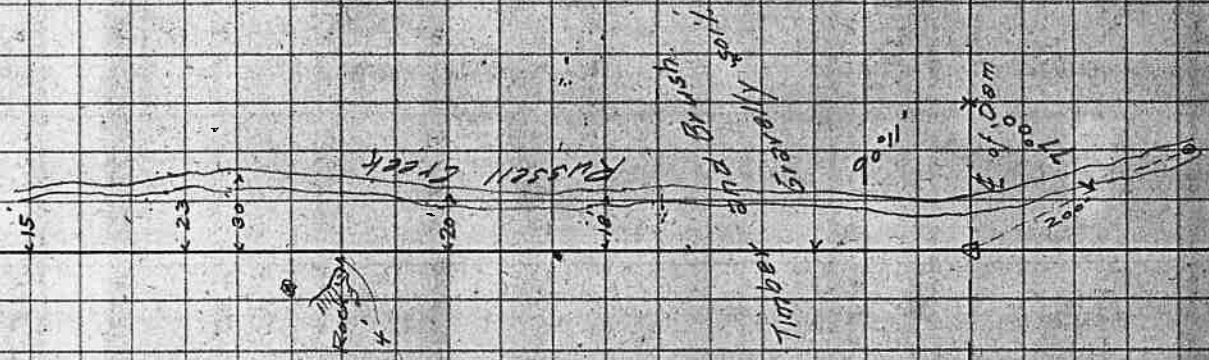

| Sta    | Hub | Def      | CC         | MC        |
|--------|-----|----------|------------|-----------|
| 158+03 | Δ   | 31'39" R | N8°17'24"  | N83°50' W |
| 159    | Δ   | 8'08" L  | N39°50'24" | N40°30' W |
| 160    | Δ   | 1'18" L  | N37°54'24" | N39° W    |
| 161    | Δ   | 9'09" L  | N36°36'24" | N37°45' W |
| 163    | Δ   | 13'56" L | N27°33'54" | N28°50' W |
| 164+22 | Δ   | 5'49" R  | N3°37'24"  | N14°45' W |
| 166+44 | Δ   | 38'24" L | N19°20'24" | N20°30' W |
| 167    | Δ   | 4'01" R  | N18°54'24" | N18°20' E |
| 168    | Δ   | 14'12" R | N22°07'24" | N23°05' W |
| 169+67 | Δ   | 6'37" R  | N36°19'24" | N37°30' W |

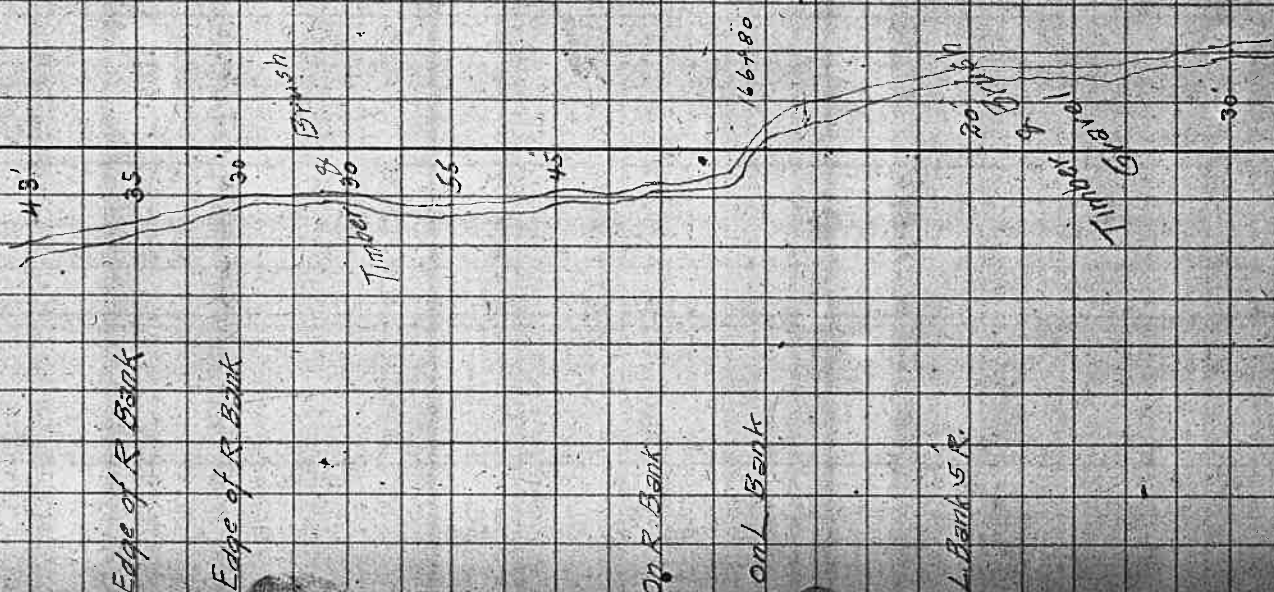



53

98

200

Δ

0°38'R

N0°38'W

N1°15'W

↙

394

↙

101+94

1/4 Cor. bet 34-35 7' West

Holiday

2

Winner

706

109

Δ

0°12'L

N1°16'W

N1°55'W

176 (Winner)  
108+85

49'

No Charing

400

113

Δ

1°44'R

N1°54'W

N1°45'W

112+90

13410

200

Grant

112+90

200

115

Δ

2°36'R

N2°48'W

N3°30'W

Holiday (?) 15x20

56x10

15x20

56x10

947

124+47

Δ

82°19'R

N28°24'W

N28°55'W

Oliver

117+13

117+13

117+13

54

55

56

1731

61731

Δ

65°52' R N65°42'E N65°40'E

749

69

Δ

0°16' L N0°10'E N0°10'W

1400

88

Δ

0°10' R N0°31'E N0°05'E



89490

●

91

Δ

1°04' R N0°26'E N0°15'W

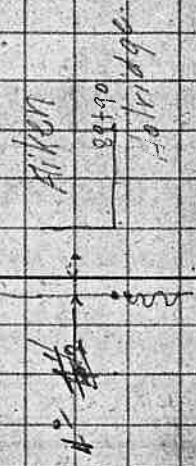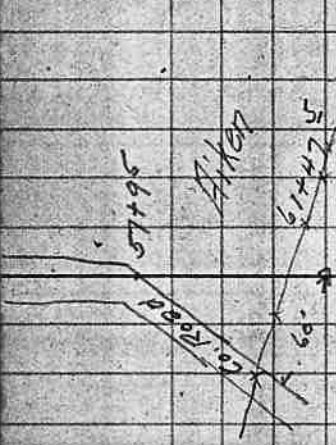

90+770 81980

57

Sta

Hub

Def

C.S.

M.C.

2+83

Δ

74'14" R

581'28E

= 11787

5+39

25 L

Δ

27°29' L

N24°18'E N24°00'E

10+82

Δ

19°57' L

N51°47'E N51°25'E

13

Δ

10°30' R

N71°44'E N71°20'E

Opposite Wilson's Gate

16

Δ

14°10' L

N61°14'E N61°0'E

26

Δ

2°07' L

N75°24'E N75°0'E

26+93

500

31

Δ

0°00'


N77°31' N77°15'E

44

Δ

11°49' R

N77°31'E N77°15'E

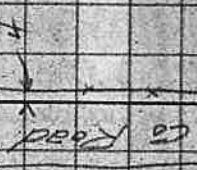

59

From Reservoir Site to Supply Line Survey  
Sta Hub. Def C.C. M.C.


11+27

74°14' N 74°14' W

68+54



7+51

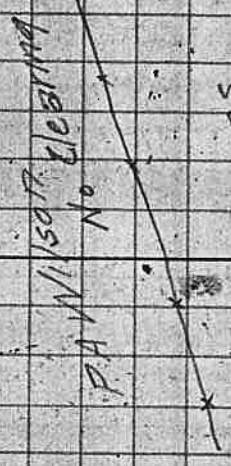

TRIPPS

50

4

TRIPPS

0+00

0°00' N 81°28' W N 81°45' W

60

61

Line to Town

Sta      Hub      Def      C.C.      M.C.

36+13

Δ

52° 18' R N 51° 54' E N 57° 40' E

1912

Temp 20.5 R 6W

Road  
36+08

Land 10' 5"

W 10' 15"

26 24'

0° 56' L N 0° 24' W N 0° 30' W

34' 36

1069'

18+52

CHIPS

No Clearing

6+00

BRUSH

11M

0+00

Δ

78° 00' L N 0° 22' E N 0° 14' E

= 0+00 of Supply Line.  
B.S. on 11+74'

63

57+655

57

52+645

44+44

55 20

43+465

5 46

38

57+58

36 12  
5 746

5°08' R N33°39' W N34° W

97

3°58' L N38°27' W N39° W


546

18°38' L N44°19' W

68°05' L N16°11' W

64

NW Line of Bank Bldg  
N " Logsdon Store  
E Line of Street (30' 54')

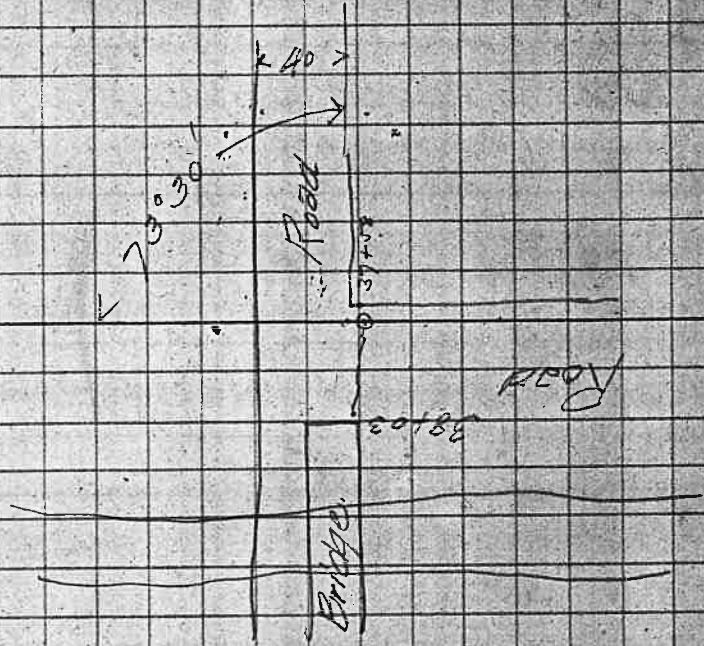

66

65

67

68

|       | +      | -    | x      | / | R    | E      |
|-------|--------|------|--------|---|------|--------|
| 0     | 10.78  |      | 685.94 |   |      | 675.16 |
| 11+27 |        |      |        |   | 14.8 | 671.1  |
| 11+00 |        |      |        |   | 16.5 | 669.4  |
| 10+83 |        |      |        |   | 14.5 | 671.4  |
| 10    |        |      |        |   | 0.0  | 685.9  |
| 0     | 11.79  | 0.00 | 697.73 |   |      | 885.94 |
| 0     | 11.11  | 0.00 | 708.84 |   |      | 697.73 |
| 9     |        |      |        |   | 4.7  | 704.1  |
| 0     | 11.96  | 0.00 | 720.80 |   |      | 708.84 |
| 8+35  |        |      |        |   | 6.6  | 714.2  |
| 0     | 12.05  | 0.00 | 732.85 |   |      | 720.80 |
| 8     |        |      |        |   | 4.1  | 728.7  |
| 0     | 11.97  | 0.00 | 744.82 |   |      | 732.85 |
| 7+50  |        |      |        |   | 5.2  | 739.6  |
| 0     | 12.05  | 0.00 | 756.87 |   |      | 744.82 |
| 7     |        |      |        |   | 3.9  | 753.0  |
| 0     | 11.18  | 0.00 | 768.05 |   |      | 756.87 |
| 6+75  |        |      |        |   | 10.1 | 758.0  |
| 0     | 11.41  | 0.00 | 779.46 |   |      | 768.05 |
| 6     |        |      |        |   | 3.5  | 776.0  |
| 0     | 10.50  | 0.00 | 789.96 |   |      | 779.46 |
| 5     |        |      |        |   | 0.9  | 789.1  |
| 0     | 11.55  | 0.00 | 801.51 |   |      | 789.96 |
| 0     | 11.60  | 0.00 | 813.11 |   |      | 801.51 |
| 4     |        |      |        |   | 9.0  | 804.1  |
| 0     | 11.67  | 0.00 | 824.78 |   |      | 813.11 |
|       | 149.62 |      |        |   |      |        |

= 2483

903.87 H46

922.5  
18.8  
903.7  
8.5  
912.2

104.20  
149.62  
253.82  
927.83  
675.16  
252.17  
1.65  
253.82

883.67  
196  
885.63  
5.43  
880.2

883.67  
11.31  
894.98  
0.31

894.67  
11.33  
906.00  
2.24  
903.76  
2.24

909.23  
4.98  
903.86  
872.6  
903.86

| Sta      | +     | T                | -     | R    | E                |
|----------|-------|------------------|-------|------|------------------|
| 0        | 11.62 | 824.78<br>836.40 | 0.00  | 44.4 | 824.78<br>832.00 |
| 0        | 11.44 | 847.84           | 0.00  |      | 836.40<br>847.84 |
| 0        | 12.02 | 859.86           | 0.00  |      | 859.86           |
| 0        | 11.44 | 871.30           | 0.00  |      | 869.2            |
| R        |       |                  |       | 11.1 | 871.30           |
| 0        | 11.36 | 887.66           | 0.00  |      | 887.66           |
| 0        | 11.98 | 894.64           | 0.00  |      | 887.5            |
| 0        | 11.88 | 906.52           | 0.00  |      | 894.64           |
| 0        | 11.32 | 914.84           | 0.00  |      | 906.52           |
| 0        | 11.14 | 928.98           | 0.00  |      | 917.84           |
| 0 + 100. |       |                  |       | 8.4  | 920.6            |
| B.M.     |       |                  |       | 1.65 | 927.33           |
| 0        | 0.76  | 917.77           | 11.97 |      | 917.01           |
| 0        | 0.29  | 906.14           | 11.92 |      | 905.85           |
| 0        | 1.12  | 895.40           | 11.86 |      | 894.28           |
| 0        | 0.72  | 884.39           | 11.73 |      | 883.67           |
| 1        |       |                  |       | 4.2  | 880.2            |
| 0        | 0.07  | 872.67           | 11.79 |      | 872.60           |
| 0        | 0.00  | 860.87           | 11.80 |      | 860.87           |
| R        |       |                  |       | 3.3  | 857.6            |
| 0        | 0.17  | 849.11           | 11.93 |      | 848.94           |
| 2 + 175  |       |                  |       | 4.8  | 844.3            |
| 0        | 0.43  | 837.60           | 11.94 |      | 837.17           |

Level at Reservoir 5572

920.6  
880.2  
48.4  
903.7  
880.2  
23.5

X = 23.5  
100  
40.4

404 / 23.5 = 17.2  
23.5  
330.76

872.6  
872.6  
872.6

71

| Sta  | T    | A      | -     | R     | E      |
|------|------|--------|-------|-------|--------|
| 3    |      | 837.60 |       | 4.4   | 833.2  |
| 4    |      |        |       | 13.0  | 824.6  |
| 0    | 0.44 | 826.19 | 11.85 |       | 825.75 |
| 0    | 1.62 | 816.00 | 11.81 |       | 814.38 |
| 5    |      |        |       | 6.0   | 810.00 |
| 0    | 1.25 | 805.49 | 11.76 |       | 804.24 |
| 0    | 0.04 | 793.96 | 11.63 | 12.63 | 792.9  |
| 0    | 0.01 | 782.04 | 11.93 |       | 793.86 |
| 7    |      |        |       | 5.4   | 782.03 |
| +20  |      |        |       | 8.8   | 776.6  |
| +30  |      |        |       | 6.7   | 773.2  |
| +60  |      |        |       | 7.1   | 775.3  |
| 7+97 |      |        |       | 11.2  | 774.9  |
| 8    |      |        |       | 10.4  | 770.8  |
| +10  |      |        |       | 7.5   | 771.6  |
| +50  |      |        |       | 6.5   | 774.5  |
| 9    |      |        |       | 10.1  | 775.5  |
| 0    | 0.32 | 770.48 | 11.88 |       | 771.9  |
| 10   |      |        |       | 1.9   | 770.16 |
| 0    | 1.79 | 760.34 | 11.93 |       | 768.6  |
| 0    | 1.48 | 749.85 | 11.97 |       | 758.55 |
| 0    | 0.33 | 738.34 | 11.84 |       | 748.37 |
| 11   |      |        |       | 4.1   | 738.01 |
| 0    | 0.77 | 727.18 | 11.93 |       | 734.2  |
| 12   |      |        |       | 8.6   | 726.41 |
|      |      |        |       |       | 718.6  |

73

Sta

|       | +    | X      | -     | R    | E      |
|-------|------|--------|-------|------|--------|
| 12+18 | 0.36 | 727.18 | 12.00 |      | 715.18 |
| 13    | 1.56 | 715.54 | 11.84 |      | 703.70 |
| 14    | 1.49 | 705.26 | 11.90 |      | 693.36 |
| 15    | 1.12 | 694.85 | 11.79 |      | 683.06 |
| 16    |      | 684.18 |       | 6.2  | 678.0  |
| 17    | 2.92 | 675.22 | 11.88 |      | 672.30 |
| 18    |      |        |       | 8.0  | 667.2  |
| 18+15 |      |        |       | 5.6  | 669.6  |
| 19    |      |        |       | 4.9  | 670.3  |
| 19+85 |      |        |       | 7.1  | 668.1  |
| 20    |      |        |       | 7.4  | 667.8  |
| 21    |      |        |       | 9.8  | 665.4  |
| 22    |      |        |       | 10.2 | 665.0  |
| 23    | 3.26 | 673.95 | 4.53  | 5.3  | 669.6  |
| 24    |      |        |       | 4.4  | 670.8  |
| 25    |      |        |       | 5.2  | 670.69 |
| 26    |      |        |       | 4.2  | 668.7  |
| 27    |      |        |       | 5.5  | 669.7  |
| 28    |      |        |       | 4.9  | 668.4  |
| 29    |      |        |       | 4.7  | 669.0  |
| 30    |      |        |       | 5.2  | 669.2  |
| 31    |      |        |       | 4.1  | 668.7  |
| 32    |      |        |       | 5.5  | 669.8  |
| 33    |      |        |       | 7.7  | 668.4  |
| 34    |      |        |       | 8.0  | 666.2  |
| 35    |      |        |       |      | 665.9  |

74

| Sta | +   | T      | -    | R    | E      |
|-----|-----|--------|------|------|--------|
| 27  | +60 | 673.95 |      | 4.6  | 669.3  |
| 28  |     |        |      | 4.3  | 669.6  |
| 29  |     |        |      | 4.5  | 669.4  |
| 30  | +98 | 673.71 | 4.22 | 5.7  | 669.73 |
|     | +80 |        |      | 4.2  | 668.0  |
| 31  |     |        |      | 10.2 | 669.5  |
|     | +45 |        |      |      | 663.5  |
| 32  | +90 |        |      | 4.8  | 668.9  |
|     |     |        |      | 4.7  | 669.0  |
| 33  | +30 |        |      | 4.4  | 669.3  |
|     | +60 |        |      | 10.2 | 663.5  |
| 34  |     |        |      | 6.9  | 666.8  |
| 35  |     |        |      | 6.6  | 667.1  |
| 36  |     |        |      | 8.4  | 665.3  |
|     | +12 |        |      | 8.1  | 665.6  |
| 37  |     |        |      | 5.8  | 667.9  |
|     | +58 |        |      | 5.1  | 668.6  |
| 38  |     |        |      |      | 668.58 |
| 39  |     |        |      | 7.2  | 667.7  |
| 40  |     |        |      | 7.0  | 667.9  |
| 41  |     |        |      | 5.3  | 669.6  |
|     |     |        |      |      | 674.30 |
|     |     |        |      | 9.5  | 676.0  |
|     |     |        |      | 8.9  | 676.6  |
|     |     |        |      | 8.5  | 677.0  |

38+0.3 End of E Approach  
 39+0.3 East end of Brg  
 41+90 West " "  
 42+10 " of HPP

38+75 12' Lower to Ground

77

Sta

42  
43 + 46

44

44 + 44

45

46

47

48

49

50

51

52

53

54

55

56

57

B.M.

+

x

-

R

E

685.53

696.81

677.8

684.94

689.5

691.8

692.4

693.0

693.0

691.8

690.4

689.4

690.3

692.2

703.66

693.49

694.1

695.4

696.8

698.4

700.4

701.9

702.43

702.45

11.87

10.17

3.32

9.6

8.3

6.9

5.3

3.3

1.8

1.23

Top of curb 5. Line of Bank

| Sta     | +      | x      | -     | R   | E      | Grade                             | Distance<br>+<br>Sta 0+00 |
|---------|--------|--------|-------|-----|--------|-----------------------------------|---------------------------|
| B.M.    |        |        |       |     | 927.93 | On Laurel near Sta 0+00           |                           |
| o       | 8.67   | 868.53 |       | 8.5 | 859.86 | T.P. near Sta 2+00 of Survey Line |                           |
| 3+92    |        |        |       |     | 860.00 |                                   | 192                       |
| o       | 9.11   | 869.09 | 8.55  |     | 859.98 |                                   | 186                       |
| Δ 8+20  |        |        |       |     | 857.18 |                                   | 142                       |
| o       | 0.29   | 857.47 | 11.91 |     | 847.52 |                                   |                           |
| o       | 0.40   | 847.92 | 11.95 |     | 836.00 |                                   |                           |
| o       | 0.06   | 836.06 | 11.92 |     | 824.99 |                                   |                           |
| o       | 10.03  | 835.02 | 11.07 |     | 825.00 |                                   | 184                       |
| o       | 8.71   | 833.71 | 10.02 |     | 825.00 |                                   | 441                       |
| o       | 3.38   | 828.38 | 8.71  |     | 825.00 |                                   | 463                       |
| o       | 8.67   | 833.67 | 3.38  |     | 825.00 |                                   | 388                       |
| Δ 32+03 |        |        |       |     | 825.00 |                                   | 420                       |
| Δ 38+28 |        |        |       |     | 825.00 |                                   | 175                       |
| Δ 39+50 |        |        |       |     | 825.00 |                                   | 255                       |
| o       | 11.60  | 836.60 | 6.98  |     | 825.00 |                                   | 135                       |
| Δ 49+65 |        |        |       |     | 825.00 |                                   |                           |
| Δ 53+25 |        |        |       |     | 825.00 |                                   |                           |
| Δ 55+80 |        |        |       |     | 825.00 |                                   |                           |
| o       | 8.52   | 823.52 | 11.60 |     | 823.52 |                                   |                           |
| o       | 10.43  | 843.97 | 0.00  |     | 843.97 |                                   |                           |
| o       | 11.63  | 855.60 | 0.00  |     | 855.60 |                                   |                           |
| Δ 62+00 |        |        |       |     | 860.75 |                                   |                           |
| o       | 8.36   | 863.96 | 0.00  |     | 870.00 |                                   |                           |
| Δ 72+00 |        |        |       |     | 881.39 |                                   |                           |
| Δ 73+05 |        |        |       |     | 881.39 |                                   |                           |
| o       | 11.67  | 872.42 | 3.21  |     | 881.39 |                                   |                           |
| Δ 78+10 |        |        |       |     | 893.21 |                                   |                           |
| Δ 78+60 |        |        |       |     | 905.07 |                                   |                           |
| o       | 11.39  | 881.39 | R.42  |     | 916.66 |                                   |                           |
| o       | 11.82  | 893.21 | 0.00  |     | 905.07 |                                   |                           |
| o       | 11.86  | 905.07 | 0.00  |     | 916.66 |                                   |                           |
| o       | 11.659 | 916.66 | 0.00  |     | 928.48 |                                   |                           |
| o       | 11.82  | 928.48 | 0.00  |     | 916.66 |                                   |                           |

8.00 per mile.  
0.15 " 510.

Survey Line

81

BM  
86+00

7.13

X  
928.48  
935.61

0.00

0.00

of Line A.

Sta 95+00 = Sta 98+90

Memo.

Line 400' S of SW Cor }

" 550' S of N.E. "

J.C.N.

82

176  
374  
550

182  
372

Top of Peg

928.48

935.61



85

Sta

Hub

Def

C.C.

M.C.

44+50<sup>S</sup> PT

Δ

44+50

44

49+50

43

42+50 P.C.

Δ

S22°40'W S.22°40'W

6°10'

6°00'

4°30'

3°00'

1°30'

6°00' C.L.

R. 12°20'

T =

86

Small Oak Grove Stumps.

W+555 PT


10V

96.

4' (Few Stumps)

Oaks Field


E. Holdridge

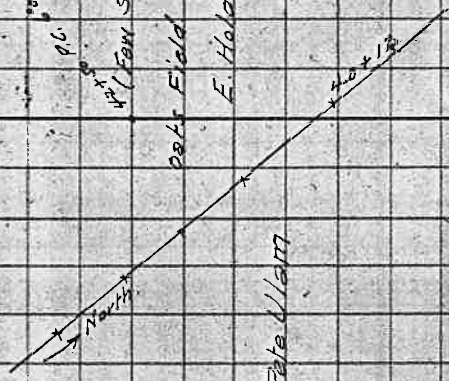

Pete Williams

88  
88

| Sta | Hub | Def    | C.C. | M.C. |
|-----|-----|--------|------|------|
| 87  |     |        |      |      |

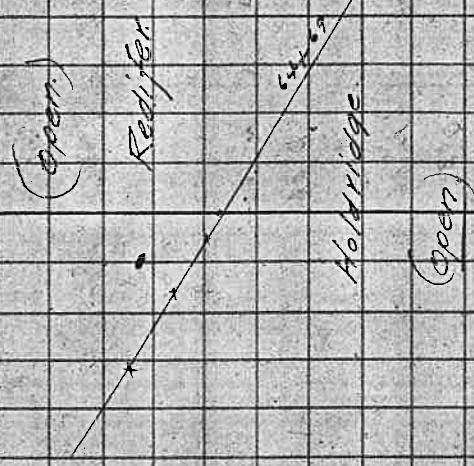

5°00' CL  
Δ = 61°15'  
T =

1192  
1-21-6

90



Sta 81+68 Intersect Twp Line  
between Twp 30/31, 6 1210' W of  
S.M. cor Sec 35

Redifer.

27+00

Timber & Grubbs  
Light Grubbing  
VERY

70+00

C.C. M.C.

S 43° 05' E 543.05' E

S 38° 35' E 538.35' E

1000' C.R.  
A = 32° 30'  
T =  
R =

200' C.L.  
A = 4° 30'  
T = 0-112.55  
b = 2.21  
R =

| Sta        | Hub | Def         | C.C. | M.C. |
|------------|-----|-------------|------|------|
| 89         |     |             |      |      |
| 82         |     | 3° 21'      |      |      |
| 81+50      |     | 0° 51'      |      |      |
| 81+33 P.C. | A   |             |      |      |
| 78+15 P.T. | A   | 2° 15'      |      |      |
| 78         |     | 2° 06'      |      |      |
| +50        |     | 1° 36'      |      |      |
| 77         | A   | 2° 06'      |      |      |
| +50        |     | 0° 36'      |      |      |
| 76         |     | 0° 06'      |      |      |
| 75+90 P.C. | A   |             |      |      |
| 69+25      | A   |             |      |      |
| 69         |     | 30° 37 1/2' |      |      |
| +50        |     | 20° 00'     |      |      |
| 68         |     | 28° 45'     |      |      |
| 67+50      |     | 27° 30'     |      |      |



C.C. M.C.

Ref

Hub

Sta

+55<sup>3</sup> PT  
 109  
 +50  
 108

107+52 PC  
 A  
 500' C.R.  
 A = 10°10'  
 T = 101.9  
 R =

106+48<sup>5</sup>  
 - 725  
 106  
 +75  
 +50  
 +25  
 105  
 104+93<sup>5</sup> PC  
 A

20°00' C.L.  
 A = 31°00'  
 T = 79.5  
 R =

102.0  
 200

1016  
 200

102 + 20  
 106 + 28

58°30' E

31  
 589.00' E

10 10

529 20 E

11 20

340 45 E

18

58° 40'

18  
 18

C.C. - M.C.

53535' E

BRUSH

or

Till 6' or

95  
Sta

Hub

Def

|          |   |       |
|----------|---|-------|
| 115 + 28 | Δ | 9°00' |
| 115      |   | 8°10' |
| + 50     |   | 6°40' |
| 114      |   | 5°10' |
| + 50     | Δ | 3°40' |
| 113      |   | 2°10' |
| + 50     |   | 0°40' |

600' C.L.  
 $\Delta = 18^{\circ}00'$   
 $T = 151.2$

|      |   |       |
|------|---|-------|
| 111  | Δ | 6°40' |
| + 50 |   | 3°10' |
| 110  |   | 0°40' |

(R)  
 1000' C.L.  
 $\Delta = 11^{\circ}20'$   
 $T = 77.3$   
 $R =$

109+86.7 PG


| Sta                      | Hub | Def  | CC | M.G. |
|--------------------------|-----|--|----|------|
| 97                       |     |  |    |      |
| +75                      | Δ   | 19°43'1/2"                                 |    |      |
| +50                      |     | 15°58'1/2"                                 |    |      |
| +25                      |     | 12°13'1/2"                                 |    |      |
| 123                      |     | 8°28'1/2"                                  |    |      |
| +75                      |     | 4°43'1/2"                                  |    |      |
| +50                      |     | 0°58'1/2"                                  |    |      |
| 122+49 <sup>5</sup> P.C. | Δ   | 0°58'1/2"                                  |    |      |
|                          |     | 3000' C.L.<br>Δ = 52.00<br>T = 93.1<br>R = |    |      |
| 119+87 <sup>3</sup> P.T. | Δ   | 9°35'                                      |    |      |
| +75                      |     | 8°21'                                      |    |      |
| +50                      |     | 5°51'                                      |    |      |
| +25                      |     | 3°21'                                      |    |      |
| 119                      |     | 0°51'                                      |    |      |
| 118+91 <sup>5</sup> P.C. | Δ   |  |    |      |
|                          |     | 2000' C.R.<br>Δ = 19.10<br>T = 48.4<br>R = |    |      |
| 118+70                   | Δ   | 45°00' L                                   |    |      |
| 118                      | Δ   | 60°00' R                                   |    |      |

of  
T.M.  
6'1  
Brush

51046' E

52040' E

52420' W

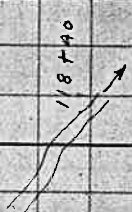

100

E of Proposed Dam

90.11' →  
90.11' × 0.11"

553° 40' E

66

125+99

△

124+16<sup>8</sup> PT

△

26° 00'

124

73° 28' 1/2

101  
5/8

102

B.M. 7.71 955.58 24" Alder near Proposed Dam

|        | +     | x      | -     | R    | E      |
|--------|-------|--------|-------|------|--------|
| 125+99 | 7.71  | 955.58 |       | 3.8  | 947.87 |
| 125    |       |        |       | 7.1  | 952.4  |
| 124    |       |        |       | 11.2 | 948.5  |
| 0      | 2.03  | 946.30 | 11.31 |      | 944.4  |
| 123+75 |       |        |       | 2.3  | 944.27 |
| 123+50 |       |        |       | 2.3  | 944.0  |
| 123+25 |       |        |       | 1.2  | 945.1  |
| 123    |       |        |       | 4.2  | 942.1  |
| 122+75 |       |        |       | 5.0  | 941.3  |
| 122+50 |       |        |       | 5.7  | 940.6  |
| 122    |       |        |       | 6.8  | 939.5  |
| 121    |       |        |       | 9.3  | 937.0  |
| 0      | 1.69  | 936.53 | 11.46 |      | 934.84 |
| 120    |       |        |       | 3.6  | 932.9  |
| 119+75 |       |        |       | 4.6  | 931.9  |
| 119+50 |       |        |       | 5.7  | 930.8  |
| 119+25 |       |        |       | 6.8  | 929.7  |
| 119    |       |        |       | 7.7  | 928.8  |
| 118+70 |       |        |       | 7.4  | 929.1  |
| 118+60 |       |        |       | 10.2 | 926.3  |
| 118+50 |       |        |       | 12.5 | 924.0  |
| 118+40 |       |        |       | 14.5 | 922.0  |
| 118+30 |       |        |       | 13.2 | 925.3  |
| 118+20 | 11.43 |        | 22.77 | 12.5 | 924.0  |

122 to 122+50 No ditch

Wilson Creek  
Water Surface

103

Sta

T

X

-

R

E

118

936.53

7.0

929.5

A

10.2

High Water Mark

117

9.2

927.3

0

7.68

928.85

117+25

3.56

932.41

7.4

925.0

116+75

4.5

927.9

116+50

7.9

924.5

116

9.0

923.4

115+28

9.3

923.1

115

9.9

922.5

0

11.85

920.56

114+50

2.43

922.99

3.8

918.2

114

5.7

916.3

113+50

7.5

915.5

113

4.3

918.7

112+50

3.4

918.6

112+28

4.6

918.4

112

5.1

918.9

0

9.06

913.93

111

5.1

911.7

110+50

7.0

909.8

110

7.9

908.9

0

8.10

908.74

109+55.2

0.89

909.63

109

3.1

906.5

9.79

36.69

903.8

104

105

106

|        | +    | TA     | -     | R    | E      |
|--------|------|--------|-------|------|--------|
| Sta    |      |        |       |      |        |
| 108+50 |      | 909.63 |       | 7.9  | 901.7  |
| 108    |      |        |       | 7.8  | 901.8  |
| 107+52 |      |        |       | 6.0  | 903.6  |
| 107    |      |        |       | 7.5  | 902.1  |
| 106+48 |      |        |       | 11.4 | 898.2  |
| o      | 0.99 | 899.98 | 10.64 |      | 898.99 |
| 106+25 |      |        |       | 3.6  | 896.4  |
| 106    |      |        |       | 4.5  | 895.5  |
| 105+75 |      |        |       | 3.9  | 896.1  |
| 105+50 |      |        |       | 5.0  | 895.0  |
| 105+25 |      |        |       | 6.2  | 893.8  |
| 105    |      |        |       | 7.3  | 892.7  |
| 104    |      |        |       | 10.1 | 889.1  |
| 103+30 |      |        |       | 11.9 | 888.1  |
| 103    |      |        |       | 10.4 | 889.6  |
| 102+50 |      |        |       | 13.5 | 886.5  |
| o      | 1.46 | 889.55 | 11.89 |      | 888.09 |
| B.M.   |      |        |       | 4.38 | 885.17 |
| 102    |      |        |       | 5.2  | 884.4  |
| 101    |      |        |       | 7.8  | 881.8  |
| 100    |      |        |       | 10.9 | 878.7  |
| o      | 1.15 | 879.38 | 11.32 |      | 878.23 |
| 99     |      |        |       | 3.1  | 876.3  |
| 98     |      |        |       | 5.2  | 874.2  |
| 97     | 3.60 |        | 33.85 | 8.1  | 871.3  |

W. Oak 12" diam. 40' R. of Sta 102+10

107

S/A

|       |       |        |       |  |      |        |
|-------|-------|--------|-------|--|------|--------|
| 96    |       | 879.38 |       |  | R    | E      |
| 95+50 |       |        |       |  | 10.8 | 868.6  |
| 95+30 |       |        |       |  | 9.8  | 869.6  |
| 95    |       |        |       |  | 12.6 | 866.8  |
| 0     |       |        |       |  | 9.4  | 870.0  |
| 94+53 | 2.52  | 873.21 | 8.69  |  |      | 870.69 |
| 94    |       |        |       |  | 3.4  | 869.8  |
| 93+88 |       |        |       |  | 7.9  | 865.3  |
| 93    |       |        |       |  | 10.2 | 863.0  |
| 92    |       |        |       |  | 8.8  | 864.4  |
| 0     |       |        |       |  | 11.8 | 861.4  |
| 91    | 0.31  | 866.79 | 11.73 |  |      | 861.48 |
| 90    |       |        |       |  | 4.2  | 857.6  |
| 89    |       |        |       |  | 7.8  | 854.0  |
| 0     |       |        |       |  | 12.7 | 849.1  |
| 88    | 2.14  | 851.99 | 11.94 |  |      | 849.25 |
| 87+74 |       |        |       |  | 6.3  | 845.7  |
| 87+50 |       |        |       |  | 7.0  | 845.0  |
| 87+25 |       |        |       |  | 7.6  | 844.4  |
| 87    |       |        |       |  | 7.2  | 844.8  |
| 0     |       |        |       |  | 1.8  | 850.2  |
| 86+75 | 8.01  | 859.53 | 0.47  |  |      | 851.52 |
| 86+50 |       |        |       |  | 5.8  | 853.9  |
| 86+25 |       |        |       |  | 3.7  | 855.8  |
| 86    | 12.98 |        | 32.83 |  | 11.6 | 847.9  |
|       |       |        |       |  | 12.5 | 847.0  |

108

12.5+99 to 87+25  
Gravelly & Rock (Loose)

86+25 to 87+25  
Solid Rock

In Draw 7' wide

In Draw 4' wide

109

| Sta   | +     | T                | -     | R    | E      |
|-------|-------|------------------|-------|------|--------|
| 0     | 5.60  | 859.53<br>853.27 | 11.86 |      | 847.67 |
| 85+60 |       |                  |       | 5.5  | 847.8  |
| 85+50 |       |                  |       | 2.5  | 850.8  |
| 85    |       |                  |       | 3.3  | 850.0  |
| 84+50 |       |                  |       | 6.5  | 846.8  |
| 0     | 2.59  | 844.05           | 11.81 |      | 841.46 |
| 84    |       |                  |       | 8.6  | 835.4  |
| 83+85 |       |                  |       | 12.9 | 831.1  |
| 83+70 |       |                  |       | 7.7  | 836.3  |
| 83+50 |       |                  |       | 1.7  | 842.3  |
| 0     | 11.47 | 855.52           | 0.00  |      | 844.05 |
| 83+20 |       |                  |       | 9.6  | 845.9  |
| 83    |       |                  |       | 8.0  | 847.5  |
| 82+50 |       |                  |       | 5.6  | 849.9  |
| 82    |       |                  |       | 4.6  | 850.9  |
| 81+50 |       |                  |       | 3.9  | 851.6  |
| 81    |       |                  |       | 4.6  | 850.9  |
| 80    |       |                  |       | 3.2  | 852.3  |
| 0     | 8.65  | 861.20           | 2.97  |      | 852.55 |
| 79    |       |                  |       | 5.3  | 855.9  |
| 0     | 7.25  | 868.45           | 0.00  |      |        |
| 78    |       |                  |       | 6.4  | 862.0  |
| 77+50 |       |                  |       | 6.3  | 862.1  |
| 77    |       |                  |       | 5.9  | 862.5  |
| 76+50 |       |                  |       | 6.8  | 861.6  |

10' Draw 10' wide

111  
512

|       | T      | -     | R     | E      |
|-------|--------|-------|-------|--------|
| 76    | 868.45 |       | 11.00 | 857.4  |
| 75+90 |        |       | 11.5  | 856.9  |
| 0     | 859.09 | 11.46 |       | 856.99 |
| B.M.  |        |       | 4.53  | 854.56 |
| 75    |        |       | 7.3   | 851.8  |
| 74    |        |       | 12.6  | 846.5  |
| 0     | 848.65 | 11.56 |       | 847.53 |
| 73+50 |        |       | 5.1   | 849.5  |
| 73    |        |       | 12.0  | 836.6  |
| 72+95 |        |       | 10.1  | 838.5  |
| 72    |        |       | 7.7   | 840.9  |
| 0     | 855.47 | 0.00  |       | 848.65 |
| 71    | 6.82   |       | 6.5   | 849.0  |
| 70    |        |       | 4.9   | 850.6  |
| 69    |        |       | 8.0   | 847.5  |
| 68    |        |       | 7.1   | 848.4  |
| 67    |        |       | 3.4   | 852.1  |
| 0     | 866.87 | 0.00  |       | 855.47 |
| 66+50 |        |       | 11.00 | 855.9  |
| 66    |        |       | 7.4   | 859.5  |
| 65+50 |        |       | 7.9   | 859.0  |
| 65    |        |       | 6.9   | 860.0  |
| 64+50 |        |       | 3.7   | 863.2  |
| 64    |        |       | 3.0   | 863.9  |
| 63+50 |        |       | 1.3   | 865.6  |
|       | 21.44  | 23.02 |       |        |

17 DRAIN

M.O. 8' 5" L. 512 75+15

114

113

| Sta   | +     | +                | -     | R    | E      |
|-------|-------|------------------|-------|------|--------|
| 0     | 11.66 | 866.87<br>877.62 | 0.91  |      | 865.96 |
| 63    |       |                  |       | 8.3  | 869.3  |
| 62+50 |       |                  |       | 3.8  | 873.8  |
| 62    |       |                  |       | 4.2  | 873.4  |
| 61+50 |       |                  |       | 0.7  | 876.9  |
| 61    |       |                  |       | 7.8  | 869.8  |
| 60+50 |       |                  |       | 6.0  | 871.6  |
| 60    |       |                  |       | 5.4  | 872.2  |
| 59+50 |       |                  |       | 5.3  | 872.3  |
| 59    |       |                  |       | 3.5  | 874.1  |
| 0     | 11.86 | 889.48           | 0.00  |      | 877.62 |
| 58+50 |       |                  |       | 10.3 | 879.2  |
| 58    |       |                  |       | 2.8  | 886.7  |
| 0     | 11.56 | 900.25           | 0.79  |      | 888.69 |
| 57+50 |       |                  |       | 7.4  | 892.9  |
| 57    |       |                  |       | 3.5  | 896.8  |
| 56+50 |       |                  |       | 0.1  | 900.2  |
| 0     | 1.68  | 890.91           | 11.02 |      | 889.23 |
| 55    |       |                  |       | 2.8  | 888.1  |
| 54+50 |       |                  |       | 6.8  | 884.1  |
| 0     | 2.97  | 881.98           | 11.90 |      | 899.01 |
| 54    |       |                  |       | 4.9  | 877.1  |
| 53    |       |                  |       | 12.8 | 869.2  |
| B.M.  |       |                  |       | 5.20 | 876.78 |
| 0     | 3.11  | 873.53           | 11.56 |      | 870.42 |

W Oak 12" diam 50' Sta 52+10

11.00

115

|       | +     | +      | -     | R    | F      |
|-------|-------|--------|-------|------|--------|
| 52    |       | 873.53 |       | 9.2  | 864.3  |
| 51+50 |       |        |       | 7.8  | 865.7  |
| 51    |       |        |       | 6.1  | 867.4  |
| 50+50 |       |        |       | 7.9  | 865.6  |
| 50    |       |        |       | 15.8 | 857.7  |
| 49+50 |       |        |       | 14.0 | 859.5  |
| 49    |       |        |       | 8.6  | 864.9  |
| 0     | 11.90 | 885.43 | 0.00  |      | 875.53 |
| 48    |       |        |       | 4.2  | 881.2  |
| 0     | 11.91 | 897.34 | 0.00  |      | 885.43 |
| 47    |       |        |       | 1.8  | 895.5  |
| 0     | 11.18 | 908.52 | 0.00  |      | 897.34 |
| 46    |       |        |       | 0.8  | 907.7  |
| 0     | 11.85 | 920.37 | 0.00  |      | 908.52 |
| 45    |       |        |       | 0.5  | 914.9  |
| 0     | 11.31 | 931.68 | 0.00  |      | 920.37 |
| 44+50 |       |        |       | 6.4  | 925.3  |
| 44    |       |        |       | 2.0  | 929.7  |
| 43+50 |       |        |       | 5.1  | 926.6  |
| 0     | 0.50  | 920.31 | 11.87 |      | 919.81 |
| 43    |       |        |       | 3.8  | 916.5  |
| 0     | 0.41  | 908.89 | 11.83 |      | 908.48 |
| 42+50 |       |        |       | 3.6  | 905.3  |
| 0     | 0.25  | 897.39 | 11.75 |      | 897.14 |
| 42    | 59.31 |        | 35.45 | 3.5  | 893.9  |

116

|       | +     | X      | -      | K    | E      |
|-------|-------|--------|--------|------|--------|
| 0     | 0.36  | 897.39 | 11.84  |      | 885.55 |
| 41    |       | 885.91 |        | 10.7 | 875.2  |
| 0     | 1.16  | 875.16 | 11.91  |      | 874.00 |
| 0     | 0.64  | 863.94 | 11.86  |      | 863.30 |
| 40    |       |        |        | 3.2  | 860.7  |
| 0     | 0.45  | 852.52 | 11.87  |      | 852.07 |
| 39    |       |        |        | 2.9  | 849.6  |
| 0     | 0.84  | 841.40 | 11.96  |      | 840.56 |
| 38    |       |        |        | 2.7  | 838.7  |
| 0     | 1.57  | 831.00 | 11.97  |      | 829.42 |
| 37    |       |        |        | 3.8  | 827.2  |
| 0     | 0.86  | 819.87 | 11.99  |      | 819.01 |
| 36    |       |        |        | 7.4  | 812.5  |
| 0     | 1.36  | 809.23 | 12.00  |      | 807.87 |
| 35    |       |        |        | 13.1 | 796.1  |
| 0     | 0.85  | 798.08 | 12.00  |      | 797.23 |
| 0     | 0.95  | 787.36 | 11.67  |      | 786.41 |
| 34+40 |       |        |        | 4.8  | 782.6  |
| 34+25 |       |        |        | 6.5  | 780.9  |
| 34+10 |       |        |        | 14.5 | 772.9  |
| 34    |       |        |        | 7.7  | 779.7  |
| 33    | 6.91  | 794.27 | 0.00   |      | 787.36 |
| 32+50 |       |        |        | 2.4  | 791.9  |
| 32    |       |        |        | 2.1  | 792.2  |
| 31+50 |       |        |        | 7.3  | 787.0  |
| 0     | 0.63  | 783.01 | 11.89  |      | 782.5  |
| 0     |       |        |        | 11.8 | 782.38 |
| 0     |       |        |        | 5.4  | 777.6  |
| 30+50 |       |        |        | 11.6 | 771.4  |
| 0     | 1.11  | 778.16 | 11.96  |      | 776.05 |
| 30    |       |        |        | 8.7  | 765.2  |
| 29+50 | 0.19  | 760.44 | 11.91  |      | 760.25 |
| 29    |       |        |        | 3.2  | 757.2  |
| 28    |       |        |        | 7.6  | 752.8  |
| 0     | 1.68  | 750.18 | 11.94  |      | 748.0  |
| 0     |       |        |        | 12.4 | 748.50 |
| 27    |       |        |        | 5.8  | 744.4  |
| 26    |       |        |        | 8.2  | 742.0  |
| 25    |       |        |        | 9.2  | 741.0  |
| 24    |       |        |        | 11.3 | 738.9  |
| 0     | 1.28  | 739.50 | 11.96  |      | 738.22 |
| 23    |       |        |        | 3.2  | 736.3  |
| 22    |       |        |        | 4.6  | 734.9  |
| 21    |       |        |        | 6.0  | 733.5  |
| 20    |       |        |        | 7.5  | 732.0  |
| 19    |       |        |        | 9.3  | 730.2  |
|       | 20.84 |        | 178.73 |      |        |

L. Bank  
17. Draw  
R. Bank

119  
Sta

Hub

Def

C.C. M.C.

120

18+77 Δ 10°00'

+50 7°18'

+25 4°48'

18' 2°18'

17+77 P.C. Δ  
20°00' C.R.  
Δ = 20°00'  
T = 50.5

11+00 Δ 23°25'

+75 21°25'

+50 19°25'

+25 17°25'

10 15°25'

+75 13°25'

+50 11°25'

+25 9°25'

9 7°25'


+75 5°25'

+50 3°25'

+25 1°25'

8+07<sup>3</sup> P.C. Δ  
16°00' C.I.  
Δ = 46°50'  
T = 155'

0+00 Δ

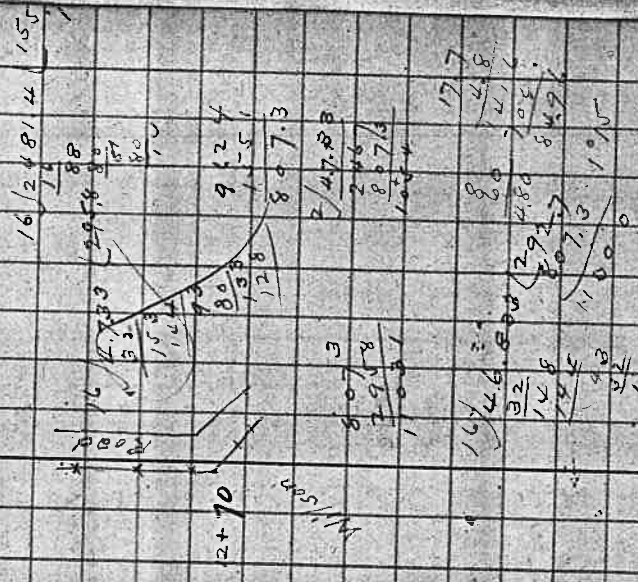

122

121  
Sta

Hub

Def

S.C

~~57+25.4~~

M.C  
577+30W

+46.4 P.T. Δ

100 2 1/2'

7°00' C.R.  
Δ = 200.5'  
T = 104.2'

34

+50

0° 33 1/2'

34x42.3  
38x42.2  
32x42.1

33

32+50

0° 18 1/2'

34x42.3  
38x42.2  
32x42.1

32+98' P.C. Δ

0° 3 1/2'

34x42.3  
38x42.2  
32x42.1

24

+14 1/2 P.T. Δ

7°06'

23x42.2

24

+75

6°22'

23x42.2

24

+50

5°07'

23x42.2

24

+25

3°52'

23x42.2

23

+25

2°37'

23x42.2

22+72' P.C. Δ

1°22'

23x42.2

20+96' P.T. Δ

5°15'

23x42.2

175

4°10'

23x42.2

150

2°55'

23x42.2

+25

1°40'

23x42.2

20

0°25'

23x42.2

19+91' P.C. Δ

10°00' C.L.  
Δ = 100.30'  
T = 52.6'

23x42.2






125  
518

|       | +     | X      | -     | R    | E      |
|-------|-------|--------|-------|------|--------|
| 34+70 |       |        |       | 90   | 689.5  |
| 34+60 |       | 698.49 |       | 120  | 686.5  |
| 34+50 |       |        |       | 93   | 689.2  |
| 34    |       |        |       | 10.3 | 688.2  |
| 33+50 |       |        |       | 11.5 | 687.0  |
| 33    |       |        |       | 10.3 | 688.2  |
| 32+50 |       |        |       | 8.5  | 690.0  |
| 32    | 1.29  | 689.06 | 10.72 | 9.8  | 688.7  |
| 32    |       |        |       | 4.7  | 687.77 |
| 30    |       |        |       | 7.5  | 684.4  |
| 29+85 |       |        |       | 7.6  |        |
| 29+80 |       |        |       | 8.6  |        |
| 29    |       |        |       | 10.5 |        |
| 28    |       |        |       | 11.9 |        |
| 28    | 4.30  | 681.86 | 11.50 |      | 677.56 |
| 27    |       |        |       | 5.2  |        |
| 26    |       |        |       | 6.5  |        |
| 25    |       |        |       | 5.9  |        |
| 24    |       |        |       | 6.5  |        |
| 23    |       |        |       | 6.9  |        |
| 22    |       |        |       | 6.7  |        |
| 21    |       |        |       | 5.3  |        |
| 20    |       |        |       | 4.5  |        |
| 20    | 2.84  | 680.32 | 4.38  |      | 677.48 |
| 19    |       |        |       | 5.7  |        |
| 18    |       |        |       | 6.7  |        |
| 17    |       |        |       | 7.0  |        |
| 16    |       |        |       | 6.3  |        |
| 15    |       |        |       | 6.5  |        |
| 14    |       |        |       | 5.9  |        |
| 13    |       |        |       | 6.5  |        |
| 12    |       |        |       | 8.1  |        |
| 11+70 |       |        |       | 7.9  |        |
| 11    | 10.89 | 691.21 | 0.00  |      |        |
| 11    |       |        |       | 9.7  |        |
| 10+75 |       |        |       | 7.3  |        |
| 10+50 |       |        |       | 3.3  |        |
| 10+25 |       |        |       | 1.6  |        |
| 10    | 11.32 | 702.53 | 0.00  |      |        |
| 10    |       |        |       | 10.7 |        |
| 9+75  |       |        |       | 6.8  |        |
| 9+50  |       |        |       | 4.1  |        |
| 9+25  |       |        |       | 0.7  |        |
| 9     | 11.64 | 714.08 | 0.09  |      | 702.44 |
| 9     |       |        |       | 8.7  |        |
| 8+75  |       |        |       | 4.7  |        |
| 8     | 11.90 | 725.98 | 0.00  |      |        |
| 8+50  |       |        |       | 9.0  |        |
| 8+30  |       |        |       | 10.8 |        |

In Draw

127

8+25

0

8

B.M.

5.61

T

725.98

731.59

-

0.00

R

4.9

2.6

729.0


4.30 727.29

B. 004 25 R. of Sta 8+10

128

$$\begin{array}{r} 60 \\ \hline 30 \\ \hline 90 \\ \hline 6.5 \\ \hline 56.2 \end{array}$$

$$\begin{array}{r} 156 \\ \hline 9 \\ \hline 508 \\ \hline 828 \\ \hline 168 \\ \hline 1512 \\ \hline 231 \end{array}$$

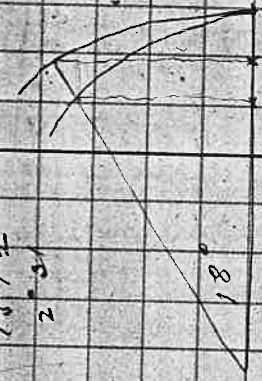

$$\begin{array}{r} 4 \\ \hline 173 \\ \hline 143 \end{array}$$

$$\begin{array}{r} 1846 \\ \hline 287 \\ \hline 88 \end{array}$$

$$\begin{array}{r} 122435 \\ \hline 1738 \\ \hline 821448 \end{array}$$

$$\begin{array}{r} 828 \\ \hline 345 \\ \hline 1210 \\ \hline 1500 \\ \hline 2000 \\ \hline 1940 \\ \hline 828 \end{array}$$

$50 + 06 = 29 + 1 + 1 + 1$

131

92881 / 15000 (12, 3  
 92881  
 221190  
 185242  
 354280  
 278643  
 756370

4.58  
 7.57  
 25.00  
 3 7.15-  
 3 2.57  
 129.72  
 3486  
 11.5-  
 17450  
 3486  
 3486  
 40890

37720  
 1916

132

37052  
 1238  
 296448  
 111168  
 74012  
 32056  
 45874328

92881  
 1236  
 566886  
 278643  
 185742  
 92881  
 114809516

1236  
 7416  
 2416  
 81572  
 22  
 818.3  





| S   | +   | X      | -    | TP  | E | G      |  |     |   |     |       |      |
|-----|-----|--------|------|-----|---|--------|--|-----|---|-----|-------|------|
| 435 |     | 10370  |      | 499 | ✓ | 198 71 |  | 499 | ✓ | 111 | 10272 | 9428 |
| 436 |     |        |      | 500 | ✓ | 20     |  | 500 | ✓ | 111 | 9428  | 9428 |
| 37  |     |        |      | 101 | ✓ | 69     |  | 101 | ✓ |     |       |      |
| 38  |     |        |      | 102 | ✓ | 68     |  | 102 | ✓ |     |       |      |
| 39  |     |        |      | 103 | ✓ | 67     |  | 103 | ✓ |     |       |      |
| 440 |     |        |      | 104 | ✓ | 66     |  | 104 | ✓ |     |       |      |
| 441 | 372 | 102107 | 5105 | 105 | ✓ | 65     |  | 105 | ✓ |     |       |      |
| 42  |     |        |      | 343 | ✓ | 64     |  | 343 | ✓ |     |       |      |
| 43  |     |        |      | 44  | ✓ | 63     |  | 44  | ✓ |     |       |      |
| 44  |     |        |      | 45  | ✓ | 62     |  | 45  | ✓ |     |       |      |
| 45  |     |        |      | 46  | ✓ | 61     |  | 46  | ✓ |     |       |      |
| 46  |     |        |      | 47  | ✓ | 60     |  | 47  | ✓ |     |       |      |
| 47  | 433 | 10292  | 348  | 848 | ✓ | 59     |  | 848 | ✓ |     |       |      |
| 48  |     |        |      | 49  | ✓ | 58     |  | 49  | ✓ |     |       |      |
| 49  |     |        |      | 435 | ✓ | 57     |  | 435 | ✓ |     |       |      |

10272  
9428  
9428

10272  
9428  
9428

|     |    |        |     |        |    |    |   |     |   |      |         |
|-----|----|--------|-----|--------|----|----|---|-----|---|------|---------|
| 461 | X  | 102,92 | 435 | ✓ 9857 | 98 | 45 | ✓ | 447 | ✓ | 12   |         |
| 62  |    |        | 525 | ✓ 9727 | 44 | 44 |   | 45  |   | 1.17 | ✓       |
| 63  |    |        | 570 | ✓ 9752 | 43 | 43 |   | 49  |   | 61   | ✓       |
| 64  |    |        | 641 | ✓ 9651 | 42 | 42 |   | 50  |   | 1.91 | ✓       |
| 65  |    |        | 530 | ✓ 9762 | 41 | 41 |   | 57  |   | 79   | ✓       |
| 66  |    |        | 500 | ✓ 9792 | 40 | 40 |   | 52  |   | 1.15 | ✓       |
| 67  |    |        | 458 | ✓ 9839 | 39 | 39 |   | 53  |   |      | ✓       |
| 68  |    |        | 522 | ✓ 9898 | 38 | 38 |   | 54  |   |      | ✓       |
| 69  |    |        | 535 | ✓ 9837 | 37 | 37 |   | 55  |   |      | ✓       |
| 470 |    |        | 526 | ✓ 9826 | 36 | 36 |   | 56  |   |      | ✓       |
| 71  | TA | 427    | 57  | ✓ 9835 | 35 | 35 |   | 57  |   |      | ✓       |
| 72  |    |        | 520 | ✓ 9742 | 34 | 34 |   | 428 |   | 92   | ✓       |
| 73  |    |        | 515 | ✓ 9747 | 33 | 33 |   | 29  |   | 86   | ✓       |
| 74  |    |        | 444 | ✓ 9798 | 32 | 32 |   | 30  |   | 94   | ✓       |
| 75  |    |        | 404 | ✓ 9858 | 31 | 31 |   | 31  |   | 34   | ✓       |
| 76  |    |        | 390 | ✓ 9842 | 30 | 30 |   | 32  |   | 42   | ✓       |
| 77  |    |        | 352 | ✓ 9915 | 29 | 29 |   | 35  |   | 89   | ✓       |
| 78  |    |        | 371 | ✓ 9891 | 28 | 28 |   | 34  |   | 63   | ✓       |
| 79  |    |        | 406 | ✓ 9860 | 27 | 27 |   | 38  |   | 35   | ✓       |
| 80  |    |        | 388 | ✓ 9824 | 26 | 26 |   | 36  |   |      | (92) ✓  |
| 81  |    |        | 582 | ✓ 9680 | 25 | 25 |   | 34  |   |      | (103) ✓ |
| 82  |    |        | 496 | ✓ 9766 | 24 | 24 |   | 35  |   |      | (101) ✓ |
| 83  |    |        | 480 | ✓ 9782 | 23 | 23 |   | 39  |   |      | (102) ✓ |
| 84  |    |        | 442 | ✓ 9890 | 22 | 22 |   | 41  |   |      | (102) ✓ |
| 85  |    |        | 443 | ✓ 9819 | 21 | 21 |   | 44  |   |      | (102) ✓ |
| 86  |    |        | 444 | ✓ 9818 | 20 | 20 |   | 47  |   |      | (102) ✓ |

487

88

89

907P

102.62

4.45

.46

.47

.48

98.17

98.75

98.15

98.14

98.79

.18

.17

.16

445

46

47

48

(02)

(02)

(02)

(02) 5.307m

M0613 1911

|      |   |
|------|---|
| 150  |   |
| 1562 | + |
| 300  |   |
| 720  |   |
| 60   |   |
| 120  |   |
| 502  |   |
| 5    |   |

|     |  |
|-----|--|
| 150 |  |
| 48  |  |
| 120 |  |
| 72  |  |

|    |     |    |     |    |     |    |     |     |     |     |     |     |      |     |     |     |
|----|-----|----|-----|----|-----|----|-----|-----|-----|-----|-----|-----|------|-----|-----|-----|
| 1  | 494 | 24 | 449 | 48 | 524 | 72 | 383 | 96  | 287 | 120 | 439 | 438 | 4415 | 632 | 635 | 723 |
| 2  | 93  | 25 | 48  | 49 | 12  | 73 | 81  | 97  | 82  | 121 | 371 | 145 | 168  | 125 | 192 | 215 |
| 3  | 98  | 26 | 47  | 50 | 20  | 74 | 79  | 98  | 84  | 122 | 376 | 142 | 169  | 15  | 143 | 20  |
| 4  | 97  | 27 | 46  | 57 | 18  | 75 | 77  | 99  | 83  | 124 | 374 | 147 | 170  | 135 | 194 | 185 |
| 5  | 96  | 28 | 45  | 52 | 16  | 76 | 75  | 100 | 81  | 123 | 372 | 148 | 171  | 12  | 195 | 17  |
| 6  | 95  | 29 | 44  | 53 | 14  | 77 | 73  | 101 | 80  | 124 | 371 | 149 | 172  | 105 | 196 | 155 |

Nov 24 1911

085 5707

07 05722

945









|     |     |     |       |     |       |      |     |            |       |      |       |      |      |
|-----|-----|-----|-------|-----|-------|------|-----|------------|-------|------|-------|------|------|
| 212 | 995 | 256 | 5.789 | 360 | 6.23  | 4.98 | 284 | 5.275      | 4.78  | 8.21 | 5.10  | 8.19 | 5.18 |
| 213 | 935 | 520 |       | 24  | 2.5   | 4.95 | 285 | 26         | 4.32  | 6.95 | 2.95  | 6.20 | 5.12 |
| 214 | 92  | 237 | 4.98  | 262 | 2.0   | 4.00 | 286 | 2458       | 3.82  | 1.22 | 8.15  | 5.12 | 5.28 |
| 215 | 905 | 238 | 87    | 263 | 1.05  | 4.85 | 287 | 252 + 1.42 | 8.24  | 5.13 | 5.20  | 5.28 |      |
| 216 | 89  | 239 | 955   | 264 | 1.78  |      | 288 | 8.225      | 7.13  | 3.08 | 8.335 | 3.22 | 3.40 |
| 217 | 875 | 240 | 94    | 265 | 1.2   | 7.17 | 289 | 1.21       | 6.25  | 3.09 | 1.32  | 3.40 |      |
| 218 | 86  | 241 | 925   | 266 | 5.00  |      | 290 | 1.18       | 6.15  | 3.10 | 3.05  | 3.50 |      |
| 219 | 845 | 242 | 91    | 267 | 5.985 |      | 291 | 1.165      | 5.78  | 3.11 | 2.9   | 3.40 |      |

495  
 355  
 85

| 1/2 | *    | 14     | 11 | R    | E       | G     | G7  | CUT    |
|-----|------|--------|----|------|---------|-------|-----|--------|
| 0   | 6.45 | 106.45 |    | 6.45 | 100     | 100   | 645 |        |
| 1   |      |        |    | 5.68 | 100.7   | 99.99 | 646 | 78     |
| 2   |      |        |    | 5.99 | 101.3-6 | 98    | 647 | 1,38   |
| 3   |      |        |    | 5.21 | 101.2-4 | 97    | 648 | 1,27 ✓ |
| 4   |      |        |    | 5.13 | 101.3-2 | 96    | 649 | 1,34 ✓ |
| 5   |      |        |    | 4.95 | 101.5-0 | 95    | 650 | 1,45 ✓ |
| 6   |      |        |    | 5.65 | 100.8-0 | 94    | 651 | 89 ✓   |
| 7   |      |        |    | 5.78 | 100.2-9 | 93    | 652 | 74 ✓   |
| 8   |      |        |    | 5.04 | 101.4-1 | 92    | 653 | 1,49 ✓ |
| 9   |      |        |    | 5.14 | 101.3-1 | 91    | 654 | 1,40 ✓ |
| 10  |      |        |    | 4.69 | 101.7-6 | 90    | 655 | 1,86 ✓ |
| 11  |      |        |    | 5.14 | 101.3-1 | 89    | 656 | 1,82 ✓ |
| 12  |      |        |    | 4.68 | 101.7-7 | 88    | 657 | 1,89 ✓ |
| 13  |      |        |    | 5.15 | 101.3-0 | 87    | 658 | 1,43 ✓ |
| 14  |      |        |    | 5.32 | 101.1-5 | 86    | 659 | 1,27 ✓ |
| 15  |      |        |    | 5.22 | 101.2-3 | 85    | 660 | 1,38 ✓ |
| 16  |      |        |    | 5.40 | 101.0-5 | 84    | 661 | 1,21 ✓ |
| 17  |      |        |    | 5.41 | 101.0-2 | 83    | 662 | 1,21 ✓ |
| 18  |      |        |    | 5.25 | 101.2-0 | 82    | 663 | 1,38 ✓ |
| 19  |      |        |    | 5.98 | 100.4-7 | 81    | 664 | 44     |
| 20  |      |        |    | 5.82 | 100.6-3 | 80    | 665 | 83     |
| 21  |      |        |    | 5.92 | 100.8-3 | 79    | 666 | 84     |
| 22  |      |        |    | 6.10 | 101.3-5 | 78    | 667 | 57     |
| 23  |      |        |    | 6.68 | 99.7-7  | 77    | 668 |        |
| 24  |      |        |    | 6.69 | 99.7-6  | 76    | 669 |        |

23  
138  
24  
163

23  
600  
141.00  
3.21

|    | +  | X      | -   | R   | E    | G    | GTR | CAT |
|----|----|--------|-----|-----|------|------|-----|-----|
| 25 |    | X      |     | 670 | 8925 | 9975 | 670 |     |
| 26 |    |        |     | 671 | 9974 | 74   | 71  |     |
| 27 |    |        |     | 672 | 73   | 73   | 72  |     |
| 28 |    |        |     | 23  | 72   | 72   | 73  |     |
| 29 |    |        |     | 74  | 71   | 71   | 74  |     |
| 30 |    |        |     | 25  | 70   | 70   | 75  |     |
| 31 | TR | 431    | 624 |     |      |      |     |     |
| 32 |    | 104,00 |     |     | 8969 | 69   | 626 |     |
| 33 |    |        |     | 432 | 1    | 68   | 432 |     |

| S   | T | F | E     | R   | T     | T  | S   |
|-----|---|---|-------|-----|-------|----|-----|
| 5   | ✓ | ✓ | 10400 | 457 | 88,49 | 88 | 457 |
| 557 |   |   | 457   | 52  | 48    | 48 | 4   |
| 85  |   |   | 52    | 53  | 44    | 44 | 53  |
| 68  |   |   | 45    | 44  | 44    | 44 | 45  |
| 69  |   |   | 44    | 44  | 44    | 44 | 45  |
| 70  |   |   | 44    | 44  | 44    | 44 | 45  |
20x442  
52.6  
1949.6

1010  
20x966

84  
25  
216  
648

✓

77  
041-

84  
148




$$\frac{13.55}{99.08} = 14.9$$

$$\frac{2.5}{3.87} = 8.4$$

$$\frac{20}{967.4} = 48.37$$

|     | T      | -      | R     | E       | D  | S  | C   | U      |
|-----|--------|--------|-------|---------|----|----|-----|--------|
| 383 | 100    |        | ✓ 467 | 100,100 | 99 | 23 | 579 | 87 ✓   |
| 384 | 104,72 |        | ✓ 420 | 100,02  |    | 22 | 100 | 80 ✓   |
| 385 |        |        | ✓ 448 | 100,24  |    | 21 | 7   | 1,08 ✓ |
| 386 |        |        | ✓ 438 | 100,34  |    | 20 | 52  | 1,14 ✓ |
| 387 |        |        | ✓ 421 | 100,51  |    | 19 | 53  | 1,82 ✓ |
| 388 |        |        | ✓ 430 | 100,42  |    | 18 | 54  | 1,24 ✓ |
| 389 |        |        | ✓ 442 | 100,30  |    | 17 | 55  | 1,13 ✓ |
| 390 |        |        | ✓ 420 | 100,52  |    | 16 | 56  | 1,34 ✓ |
| 391 |        |        | ✓ 430 | 100,42  |    | 15 | 57  | 1,24 ✓ |
| 392 |        |        | ✓ 444 | 100,27  |    | 14 | 58  | 1,13 ✓ |
| 393 |        |        | ✓ 435 | 100,37  |    | 13 | 59  | 1,24 ✓ |
| 394 |        |        | ✓ 483 | 99,89   |    | 12 | 60  | 77 ✓   |
| 395 |        |        | ✓ 485 | 99,87   |    | 11 | 61  | 76 ✓   |
| 396 |        |        | ✓ 482 | 99,90   |    | 10 | 62  | 80 ✓   |
| 397 |        |        | ✓ 530 | 99,42   |    | 09 | 63  | 83 ✓   |
| 398 | 3.87   | 100,53 | ✓ 505 | 99,18   |    | 8  | 64  | 84 ✓   |
| 399 |        |        | ✓ 420 | 99,35   |    | 7  | 65  | 85 ✓   |
| 400 |        |        | ✓ 430 | 99,25   |    | 6  | 66  | 86 ✓   |
| 1   |        |        | ✓ 445 | 99,10   |    | 5  | 67  | 87 ✓   |
| 2   |        |        | ✓ 485 | 99,20   |    | 4  | 68  | 88 ✓   |
| 3   |        |        | ✓ 419 | 99,36   |    | 3  | 69  | 89 ✓   |
| 4   |        |        | ✓ 453 | 99,02   |    | 2  | 70  | 90 ✓   |
| 5   |        |        | ✓ 447 | 99,08   |    | 1  | 71  | 91 ✓   |
| 6   |        |        | ✓ 429 | 99,26   |    | 00 | 72  | 92 ✓   |
| 7   |        |        | ✓ 436 | 99,19   |    | 99 | 73  | 93 ✓   |
| 8   |        |        | ✓ 425 | 99,30   |    | 98 | 74  | 94 ✓   |

$$8 \int \frac{509.7}{6.37}$$

see XX

|    |     |    |    |    |       |     |     |     |     |     |     |     |     |     |     |     |
|----|-----|----|----|----|-------|-----|-----|-----|-----|-----|-----|-----|-----|-----|-----|-----|
| 0  | 493 | 25 | 1  | 50 | 57    | 442 | 498 | 482 | 410 | 174 | 523 | 520 | 424 | 568 | 271 | 402 |
| 1  | 74  | 56 | 17 | 51 | 2174  | 43  | 99  | 83  | 134 | 105 | 24  | 441 | 125 | 179 | 449 | 68  |
| 2  | 95  | 27 | 18 | 52 | 20975 | 44  | 100 | 84  | 125 | 104 | 200 | 24  | 226 | 20  | 250 | 69  |

52.8  
52.8  
-1.67

442  
442  
-48

1.74  
1.74

1.74  
1.74

Jan 21 34 1522.32












































