

Field Book # 93

93

W. S. Briggs

Filed

X
Survey of a Quarry
Mining, Oct 20 1897
for a Pool and The
Wilson.

Beginning at a post 4 1/2
ft long 4 in square 15
mch in the ground
scribed N.S. for center
post on S. West end
of cl. since post is set
on the East boundary of
Jackson Reynolds Donation
claim 1900 ft South on
122 mat from car to 500
26.27.34.436 305 N 5-M
From which Dr cones
tunnel bears N 43° E 175 ft
Thence S 43° E 300 ft

644

Set post No 1, Scriber MS. 1.

Thence ^{face of} discovery turned

N 45° E. 747 - 644 East

of 9 m. cor of a heavier fence

Set post for center of

N. Post - center post

Thence S 45° E. 300 ft

Set post for N & cor

2

Survey made for
Lovelady & Jane Orr
street - Oct 16th 1899.

Beginning at post set
for N. E. Cor of Eugene
Common

Hence N $70\frac{1}{2}^{\circ}$ E.

2.60 ch set post No 1.

Hence South

25.70 ch set post No 2

Hence West 6.07 ch

Hence North 10.65 ch

Hence East 3.60 ch and

Hence North 14.18 ch to

place of begin - Cont 10.07 ch

Survey for P & O B by
Oct 28th 99

Beginning at S. E. cor of
Joseph Roberts Donation cl
No 59, Sec 34, T30S12, 5W,

Thence West 19.19 ch cor 1

Thence South 15.89 " " 2

Thence East 19.19 " " 3

Thence North 15.89 " " 4

19

Canyonville
Oregon

Dec 15 / 1899

Mr. Cid

Dear Friend

I will take the pleasure
of answering your kind
letter this leaves both
well hoping you the same

20 Jan 10th 1900

Survey of the Isable
consolidated Quarry Claim
Beginning at cor No 1 of the
Dis cover claim. Identical
with location claim
which is a post 4 in square 4¹/₂
ft long 18 in in ground with
stone mound alongside Scribe
N. S. 383. C 1. from which
Pine 30 in dia bears S 69^o W 34 ft
" 24 " " " N 8^o W 50
1/4 S cor bet 27 & 28 T 32 S R 7 R
bears N.

Thence N 75^o W.

300 feet center post. in North
end of cl.


Dis cover shot bears N 79^o E 20

14 X 4 X 14 ft deep

4 X 4 5 ft deep

5 x 4 3 ft ditch

cut 4 x 8 ft 8 ft dups.

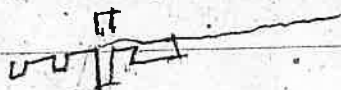

N 75° W 53. Ditch

125 "

* 214 Creek C 8
298 Ditch
300 to Car No 2

Identical with location
just from which

Lavel 8 in dia bear S 29° E, 16 ft

Live Cup 8 " " N 54° E, 34 "

* Mouth of Tunnel

bears S 16 1/2° E, 88 ft from point on creek

Corner of Tunnel N 82° E to 285

11 long 577 ft

at 102 from face cross cut

33 long angle to L

21

Set post no 3 for S^m
Cor. which is a square
4 in square 4 1/2 feet long
Set 18 inches in the ground
with 8 lb iron mound along
side. - from which

A Pine 30 in diam bears $29^{\circ} 12' 42''$
Then Mar 19th 8

S $75^{\circ} 2'$ E. 300 feet Center South
End of Tis covers claim
4 in square 4 1/2 ft long 4 lb

Then

S $83^{\circ} 4'$ 300 feet Set post no 4
which is a post 4 inches square
4 1/2 ft long 18 in in ground
4 lb

Cedar 24 in diam $12^{\circ} 8'$ 160 ft

Thence N 12 1/4 E
N 12 1/4 E. 365 ft Board house
on low 88 ft long
32 ft wide two story house
with a porch added 20 x 16
one story
900 ft House 30 x 50
161 feet E of line
1000 Ditch
1260 "
1460 ft Set post no 4 which
is 4 in square 4 1/2 ft long
18 in in the ground with
stone mound alongside
marked M S 383 - C1,
from which
Pine 30 in dia bears S 67 1/2 W 34

22

Gold Standard cor 4
Pine 24 in dia N $7\frac{1}{2}^{\circ}$ W 50 ft

Hence N 23° E
1500 feet post identical
from which
Pine 20 in dia S $86\frac{1}{2}^{\circ}$ W 105 ft
Laural 10 " North 23 ft

Hence N 75° W
300 feet center post of N
end of Gold Standard
Identical
300 feet cor No 2, identical
with locations
from which

Laural 18 in dia S 20° E 15 ft
Laural 16 in dia N $85\frac{1}{2}^{\circ}$ E 56

Beck

Thence N 26 1/2° E
1500. to cor 2. Identical
with location.

Alder 18 in dia N 81° W, 57
Laural 6 in dia N 26° E, 15 in

Thence N 75° W, 300 feet center
part of N end of the Beck
cl. Identical with location
600. Set post identical with

location cor 3;
Law 10 in N 62° E, 17
do " 6 " N 82° E

Thence S 26 1/2° W, 1500 feet
No 4.

Thence S 75° E, 300 feet to cor
south end of cl.

Thence S 75° E, 300 feet to
place of log

place of log

23

Hoozie Lock

Beginning at cor No 1

The same being cor No 2
of the Buck Lock. post
whence an

Laurus 6 in dia N 26° E. 15 ft.

Alder 18 in N 81° W 57 "

Bar 20° E

Thence N 32½° E

15-00 ft to cor 2, identical
with location cor
from which

7 in 6 in dia bar S 52° W 37

Pine 10 " " " N 24° E 42

Thence N 75° W

300 feet to center post

600 to cor No 3, identical
with location in

Laurel 10 in mid bear S 18° E 76

Laurel 8 " " " N 71° E 44

Cor to Sec 21, 22, 27 & 28

bear N 30° E, 25 ft and West

1440 feet

Thence from cor 3

S 32 1/2° W 1500 ft to cor 4

Thence S 75° E 300 feet corner
post. Identical at 600 feet
to place of begin

24

Brown Bear

Beginning at Car No 1.

The same being c 2. of

The Hoosier Lode

from which

Pine 10 in dia. bears $N 24^{\circ} E 42$

Fire 8 " " " " $S 52^{\circ} W 87$

Thence $N 30^{\circ} E$,

400 feet Summit of Ridge 872

1100. To Car No 2. Identical

with location car

R Fire 20 in dia bears $S 35^{\circ} W 20$ ft

Thence $N 75^{\circ} W 300$ feet

center point Identical

600 feet Car 3. Identical

Fire 10 in dia bears $S 75^{\circ} E 5-3$

Hence $S 30^{\circ} W$ 1172 ft to
cor 4 identical with
location on

• Hence $S 75^{\circ} E$ 300 ft center
part identical
600 ft to place of basin

Black Bear

cor No 4

7 in 14 in dia bear $S 30^{\circ} E$ 54

Black Bear

Begin at car no 1-
from which

Pine 10 in dia bears $N47^{\circ}E$ 55

Car No 2 of Brown Bear
bears $N39\frac{1}{2}^{\circ}E$ 224 ft

Thence $N58^{\circ}E$, down steep
hill

9.75- Small creek C. N.

12.25 " " C $N75^{\circ}W$

ascend steep hill.

1500 feet set new car 2

4 in square $4\frac{1}{2}$ ft - 18 in
in the ground with 8 line

marked along side - from where

Pine 12 in dia bears $N84^{\circ}W$ 91

original location car

bears $N67\frac{1}{2}^{\circ}E$ 180 ft

Thence $N 32^{\circ} W$, descend
300 ft a Cedar stub
12 in dia for center
post, Small Creek C $N 75^{\circ} W$
Down gradually

Center post of location
bears $N 67^{\circ} E$ 180 ft
600 ft Set post No 3. from which
Lay out 10 in dia $S 42^{\circ} E$ 32 ft
Thence $S 58^{\circ} W$, descend

210 ft Creek C N.
Ascend steep hill
1500 ft to an iron identification
with location on

Thence $S 32^{\circ} E$ ascend
275 ft top of hill
Descend
300 center post identification

26

600 ft place of base

From Discovery point

a shaft bears S 10° W

House 435 ft x 12

756 ft shaft 5 x 5 ft

34 ft deep

Survey made Jan 4th to 7th 1900
for S. W. Carter and Mrs. Rimmel
administrators of Estate of Paul
Rimmel

Beginning at a point 638 ch
West and S 19 $\frac{1}{2}$ ° E, 16.00 ch and
S 66 $\frac{1}{2}$ ° W, 1.17 ch from the N.E. cor of
James Catkins D. S. Co. No 43.

T 30 S 12 6° W, 100 ch
Var 19 $\frac{1}{4}$ ° E

Thence S 66 $\frac{1}{2}$ ° W, 15.83 ch S.W. cor of Sillman

" N 19 $\frac{1}{2}$ ° W, 12.50 " to left bank ^{Creek} Cow

" S 51° W, 6.50 "

" S 53° W, 5.00 "

" S 71 $\frac{1}{2}$ ° W, 2.30 "

" S 68° W, 3.30 "

" S 70 $\frac{1}{4}$ ° W, 2.30 "

" S 73 $\frac{1}{2}$ ° W, 2.30 "

" S 68 $\frac{1}{2}$ ° W, 4.50 "

" S 74 $\frac{1}{2}$ ° W, 13.79 " to point on

S 74° 12' W 1379 .. to point on

27

Left bank of Crow Creek Thence
South Crossing Crow Creek

South " 11.41 ch to S.E. cor of A. Nichols

West 12.45 "

South 52.90 "

East 15.89 "

South 10.80 "

East 8.58 "

South 20.00 "

East 40.00 "

North 43.40 " to S. bd of el 43.

East 4.91 " " S.E. cor " 43

South 35.00 "

to 2 1/4 W 5.21 " to place of begin

Cont 470 64 acres

From the above tract of land
there is to be 234.91 acres set
off on the East side to Percy Nelson

for this purpose I began at a
 point 6.38 ch West 1600 ch S 19 1/2 W
 and 1.17 ch S 66 1/2 W ^{from S 82 cur of cl 43} see beginning point
 Hence S 66 1/2 W 15.83 ch S W cur of Sillmore
 " N 19 1/2 W 12.50 " to point left bank ^{creek}
 " S 51 W 6.50 " " " " " "
 " S 53 W 5.00 " " " " " "
 " S 71 1/2 W 2.30 " " " " " "
 " S 68 W 3.30 " " " " " "
 " S 70 1/2 W 2.30 + 4.30 " " " " " "
 " ^{S 19 1/2 W 11.60 thru S 82 cur} South 66.93 - 12.85 " Crossing cow creek
 " East 31.83 "
 " North 31.45 " to S bd of cl 43
 " East 4.91 " " S 82 cur " 43
 " North 36.00 "
 " N 21 1/2 W 5.21 " to place of
 beginning East 234.91 acres

28

April 16 - 1900

$\frac{2}{7}$ of 234.91 to be cut off
of the west side
which makes a strip
9.63 $\frac{1}{2}$ ch wide 69.66 ch long
leaving a remainder of the
Purch. Wilson tract 167.76.00
with 1.60 a added to stating
the primum orchard so the
line will follow the rows
of orchard.

which is now barging to
Ball Botter, which is described
as follows

Beginning at a point - 6.33 ch
West and 16.00 ch S $19\frac{1}{2}$ E, and 1.17
ch S $66\frac{1}{2}$ W, of the N.E. corner of
James Catching Donation claim
No 43. in Sec 26. T 30 S R 6 W. 14th

Var $19\frac{3}{4}$ E

Thence S $66\frac{1}{2}^{\circ}$ W 15-83 ch to 8 m
corner Billmore tract

Thence N $19\frac{1}{2}^{\circ}$ W 12.50 ch to corner
on left bank of Coco Creek

Thence measure of left bank
of Coco Creek up stream

S 51° W 6.50 ch.

Thence S 53° W 5.00 ch

Thence S $71\frac{1}{2}^{\circ}$ W 45 links

Thence S 19° E 10.20 ch crossing
Coco Creek and through Prussia
meadow.

Thence South 60.08 ch. to south
boundary,

Thence East 22.19 ch. to east line

Thence North 31.45 ch. to south
boundary of cl 43.

Thence East 4.91 ch. to S.E. cor. cl 43

Thence East 4.91 ch. to S. E. corner

29

Thence North 35.00 ch. on 8 pages

Thence N 2 1/2 W 5.21 ch. to place
of beginning containing 169.36

acres

The part remaining and
not sold is now described
as follows

Beginning at a point - 15.89 ch
East and 62 links North of
quarter cor lot Secs 26 & 27

T 30 S R 6 W

Thence South 52.90 ch.

Thence East 15.89 ch.

Thence North 10.80 ch

Thence East 8.50 ch

Thence South 20.00 ch

Thence East 40.00 ch

Thence North 12.57 ch

Thence West 22.19 ch

Thence North 60.08 ch

Thence N 19° W 10.20 ch to

left bank of Cow Creek

left bank of Cow Creek

30

Thence $S 71^{\circ} \frac{1}{2} W$ 1.85 ch. (measured on
left bank)

Thence $S 68^{\circ} W$ 3.30 ch

Thence $S 70^{\circ} 15' W$ 2.30 ch

Thence $S 73^{\circ} 15' W$ 2.30 ch

Thence $S 68^{\circ} 30' W$ 4.50 ch

Thence $S 74^{\circ} 30' W$ 13.79 ch

Thence South 11.41 ch crossing
Cow Creek to S. 9, end of cl 44.

and Thence West 12.95 ch to
place of beginning.

Cont 301.28. Acres

S. W. Cor of Sec 34 T32S R79W

A Cedar 12 in diam N 65° E. 56 ft

Fir 28 " " N 75° W 34 "

Cedar 24 " S 20° E. 34 "

Field
Notes

1/4 Sec 34

C. S Oak 14 in diam North 14 ft

Fir 15 " " S 76° E. 23 "

S. W. Cor of Sec 35 + S. E. Cor 34

Fir 14 in diam bear N 30° E 43 ft

Larred 10 " " " N 26° W 30 "

Fir 40 " " " S 72° W 47 "

" 6 " " " S 10° W 23 "

1/4 Sec 33 + 34

Pine 24 in diam bear S 40° E. 8 ft

Cedar 20 " " " N 42° W 30 "

1/4 S 34 + 35

Fir 56 in diam N 30° E. 64 ft

Larred 18 " " N 18° W 34 "

From 56 m. down N 30° E 64 m
Loc 18 m. N 18° W 84 "

37 325 m

Survey made for Cha
Hickert. April 18-1900.

Beginning at the $\frac{1}{4}$ S cor
bet. See 33 & 34.

Then 20° E

Thence S 45° E 20.00 ch

Thence South 2.50 "

Thence S 45° E 8.29 "

Set post on left bank of
Cow Creek 2.50 ch north of
S. W. cor of N. E. $\frac{1}{4}$ of S. W. $\frac{1}{4}$
of Sec 34.

Thence South 7.25 ch Major
Road to Mound Reburbs
17.50, set post.

Thence East 11.50 Road

52.50 ch left bank of Cow
Creek offset to right bank

Thence East 350 ch
of post to true line
Thence 227 ch intersect 5.19 ch
South of S & Cor of Sec 34
Post & witness line S. T. J. J. J.
Thence South 10.00 set post
Thence S & Cor of Sec 34
West 10.00 set post on Right
bank of Cow Creek

Thence from post set on
left bank of Cow Creek
offset East to point on
Right bank, run North
8.00 ch offset ^{met} to true line
Thence West 173 ch to true
subdivision line.
Thence South 20.00 ch
Set post N. W. Cor of

Set Apart N. W. Cor of

32

W. C. Strooban - Hermetick

Over to Sec 27, 28, 34 & 36

230 S.R. 3 1/2

Pine 30 in dia N 35° W, 68 lbs

Fir 15 " " S 10° E, 150 "

Oak 15 " " N 20° E, 136 "

" 12 " " S 28° W, 163 "

Cornells House, bear N 14° W,

Var 15 1/2 E,

East bet Sec 26 & 35-

1.65-ch River

40.00 Set 1/4 S Cur

Pine 36 in bear N 76° E, 720 lbs

Oak 24 " " S 82° E, 700 "

8000 St Cur to Sec 25, 26, 35 & 36

Lavret 9 in dia S 60° E, 10 lbs

" 9 " " N 70° E, 50 "

Fir 6 " " S 80° W, 108,

" 15 " " N 2 1/2° W, 190

" 15 " N 2 1/4 190

33

North lot 8000 259-26

40.00 Set quarter sec corner

Feb 24 in day N 2° 9' 21 0

" 15 " " N 5 1/8 199

42.50 ch under River

Survey made May 29 - 1900
for Len Percum & Frank Fabel
Beginning at 1/48 cor. between
Secs 25 & 26 T 30 S R 3 W
Bar 19° 00 E

Thence East

15.50 ch to left bank of Sumpston

River

Thence measure of L bank
of River down stream

Calculating the true line to
be 100 links to the right
from the line run which
fixes the true line in the
river

Thence S. 66° W 15.6 ch

" " 78° W 193 "

" " 74 1/2° " 2.48 "

" " S. 83 1/2° W 1.23 "

to corner

5-

" 74 1/2 " 2.48 "
" S. 83 1/2 W 1.23 "

34
Thence S 82° W 2.03 ch
" N 77° W 3.14 "
" " 83 1/2 " 12.72 " 550 salt
" " 79° W 17.50
" S 79 1/2 W 9.90 to Baltimore
" S 81 1/2 W 7.80
" S 82° W 13.42
S 47 " ~~12.50~~
S 28 1/2 " 9.76
South 2.40 to a point

Left bank of Prudence
Thence S 57 1/2 W 4.50 ch to
double oak grove on right bank

Thence S 15° E 6.21
" S 28 1/2 W 5.00
" S 39 1/2 W 12.16 to site

• Cur 27, 28, 34 & 35

Thence North 2000 ch set pins
Thence East 922 ch Right bank
of River offset South

Thence East 950 ch to Right
bank of River took a point
North on Left bank of River
Thence East 50 ch intersect
paper line South of the
point set on Left bank
of River

Thence East 983 ch offset
to true course

Thence North 2000 ch
intersect meander line

Thence from the point set
on Right-bank 922 on East
and west line measured

Use ~~Project~~ ~~begin~~ ~~from~~ ~~at~~ ~~end~~
Use it west in ~~Mass~~ ~~shunt~~

35-
West 150 interest American
line S 15° to 35-~~th~~ form
origin in car

Thence from Sec car 27, 28, 34 & 35
run East 6000 ft
Thence North 2000 "
" East 2000 "
" North 2000 " to place of
Beginning Cont 268.21 acres

4 days Sur & Calculation
\$2000

Survey made for J. S.
Johnson & F. S. MacIntyre
August 27th 1900

Beginning at a rock 5+8
in county road leading
from Canyonville to Ricketts

Dec 19th 00

I hence West 4.00 ch

I hence South 5.00 ch

I hence West 11.00 ch

I hence South .59 "

To enter county road before
men found set rock 6x12 in
on west boundary of J. S. Johnson
land far starting point
of this survey.

36

Thence S 81 $\frac{1}{2}$ E 3.18 ch set
rock 8 x 10 in center of road
Thence South 3.19 $\frac{1}{2}$ ch set
post marked C.S. from which
N Oak 5 in dia bears S 63 $\frac{1}{2}$ W 25-45

Thence S 81 $\frac{1}{2}$ W 3.18 ch set
post, marked C.S. from which
N Oak 8 in dia bears East 3 1/2

Thence South 3.19 $\frac{1}{2}$ ch to
place of beginning
contains 1.00 acre
Deed from J. S. Yokum and
Maggie Yokum to F. S.
McIntyre Consideration \$12 $\frac{00}{100}$
\$ 5.00

Field Book No. 93

Pages 37 -45 Blank

$$\begin{array}{r} 9.22 \\ 90 \\ \hline 10.12 \end{array} \quad \begin{array}{r} 2000 \\ 10.12 \\ \hline 9.83 \end{array}$$

$$8 \overline{) 100000} \underline{13.16} \text{ ch}$$

$$\begin{array}{r} 61 \overline{) 100} \\ \underline{61} \\ 39 \text{ } 00 \\ \underline{37} \text{ } 52 \\ 1 \text{ } 44 \end{array}$$

$$\begin{array}{r} 385 \overline{) 100000} \underline{1317} \\ \underline{948} \\ 0520 \\ \underline{316} \\ 2040 \\ 12 \end{array}$$

$$\begin{array}{r} 8 \text{ } 11 \\ 81 \overline{) 81} \underline{3.16} \\ \underline{296} \text{ } 50 \\ \underline{16} \text{ } 3 \\ 3 \text{ } 2 \text{ } 5 \text{ } 3 \\ \underline{53} \\ 9 \text{ } 3 \text{ } 6 \\ \underline{156} \text{ } 0 \\ 2 \overline{) 6536} \\ \underline{82} \text{ } 6 \text{ } 8 \end{array}$$

$$\begin{array}{r} 100000 \\ 16526 \\ 2 \overline{) 834642} \\ \underline{4} \\ 434 \end{array}$$

$$\begin{array}{r} 1560 \\ 2 \overline{) 6536} \\ \underline{82} \text{ } 6 \text{ } 8 \end{array}$$

$$14085556$$

$$\begin{array}{r} 23181 \\ 1727 \\ 91819 \\ 18187 \\ \hline 23181 \\ 5818 \\ \hline 1727 \end{array}$$