D.C.S.O. F.B. # 121

CORNER RESTORATION RECORDS IN ELLIOTT STATE FOREST BY FEDERAL CIVILIAN CONSERVATION CORP (CCC)

PHOTOCOPIES RECEIVED AT D.C.S.O. 8/1/95
ORIGINAL RECORDS RETAINED BY
OREGON STATE DEPT. OF FORESTRY -
COOS BAY DIVISION

D.C.S.O. F.B.# 121

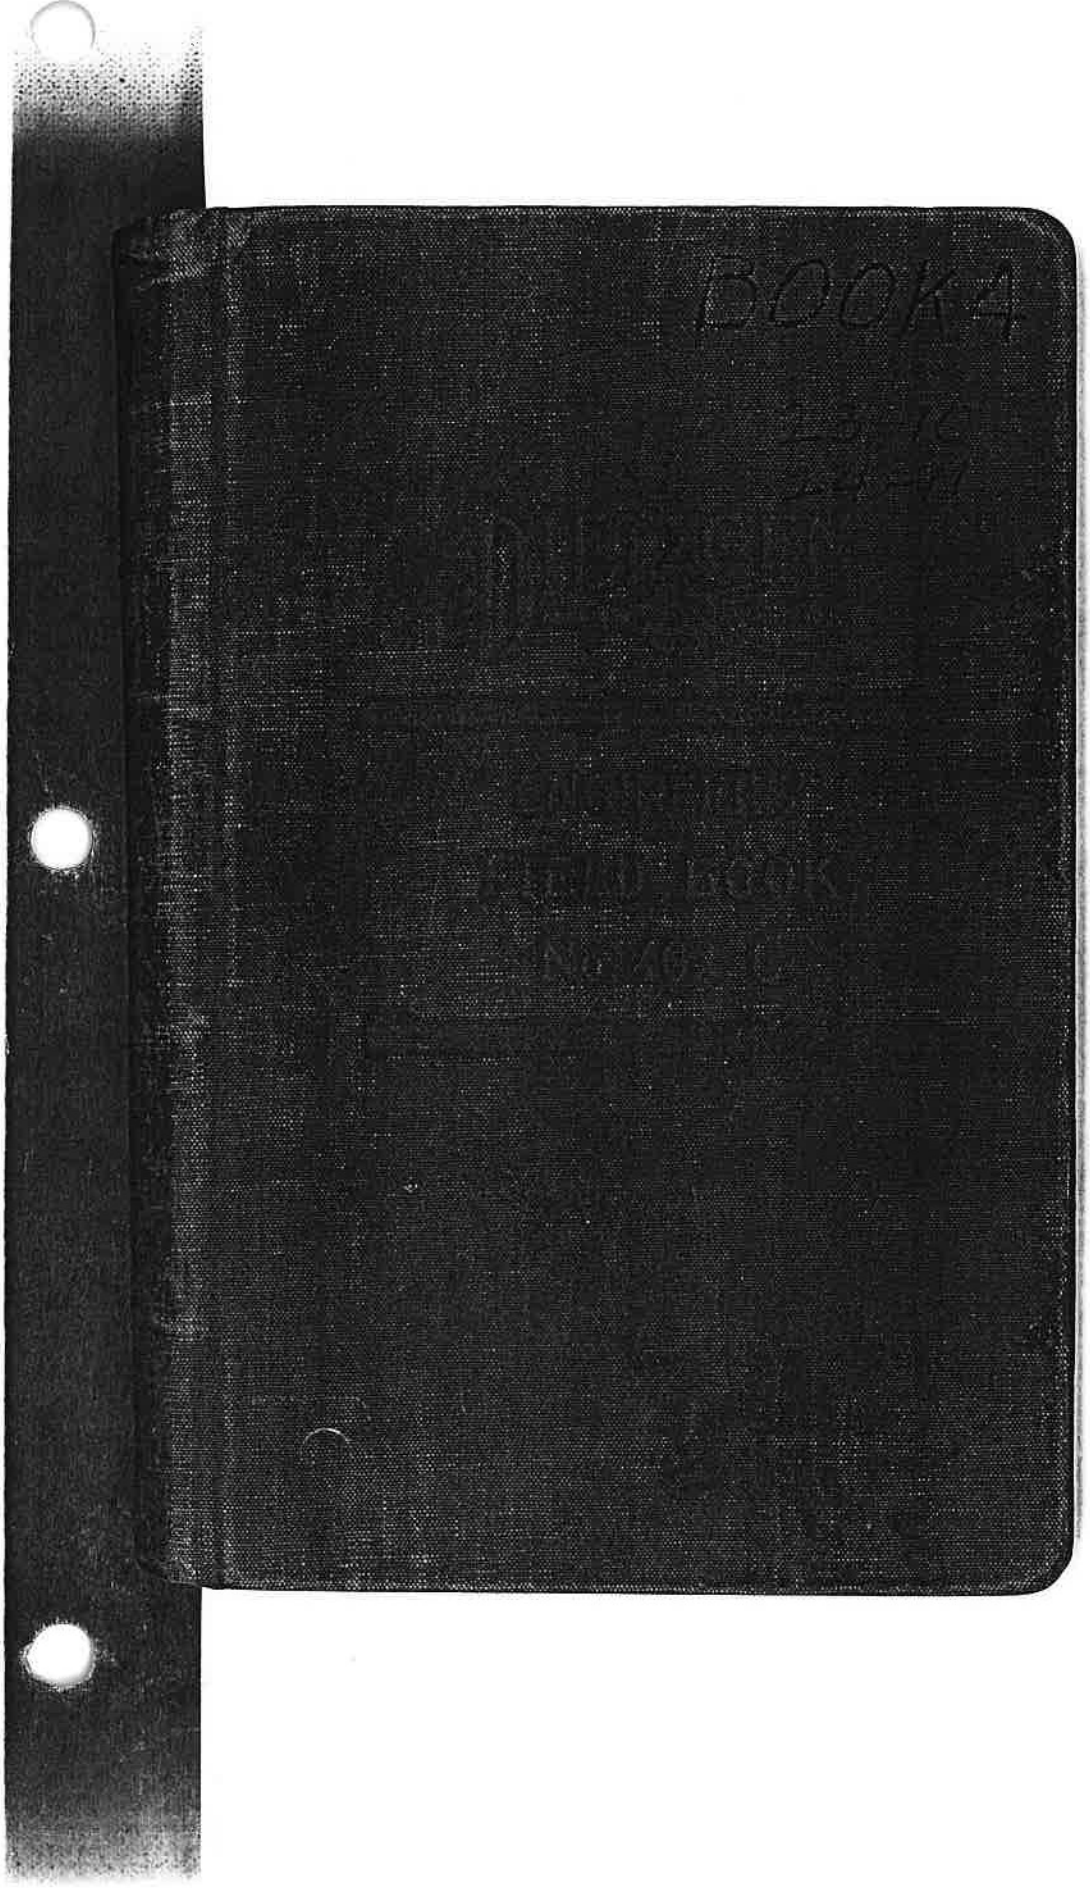

Book 4

23-10
24-11

Form T2—12-47—2M

County ..... Township 23S Range 10W Acreage .....

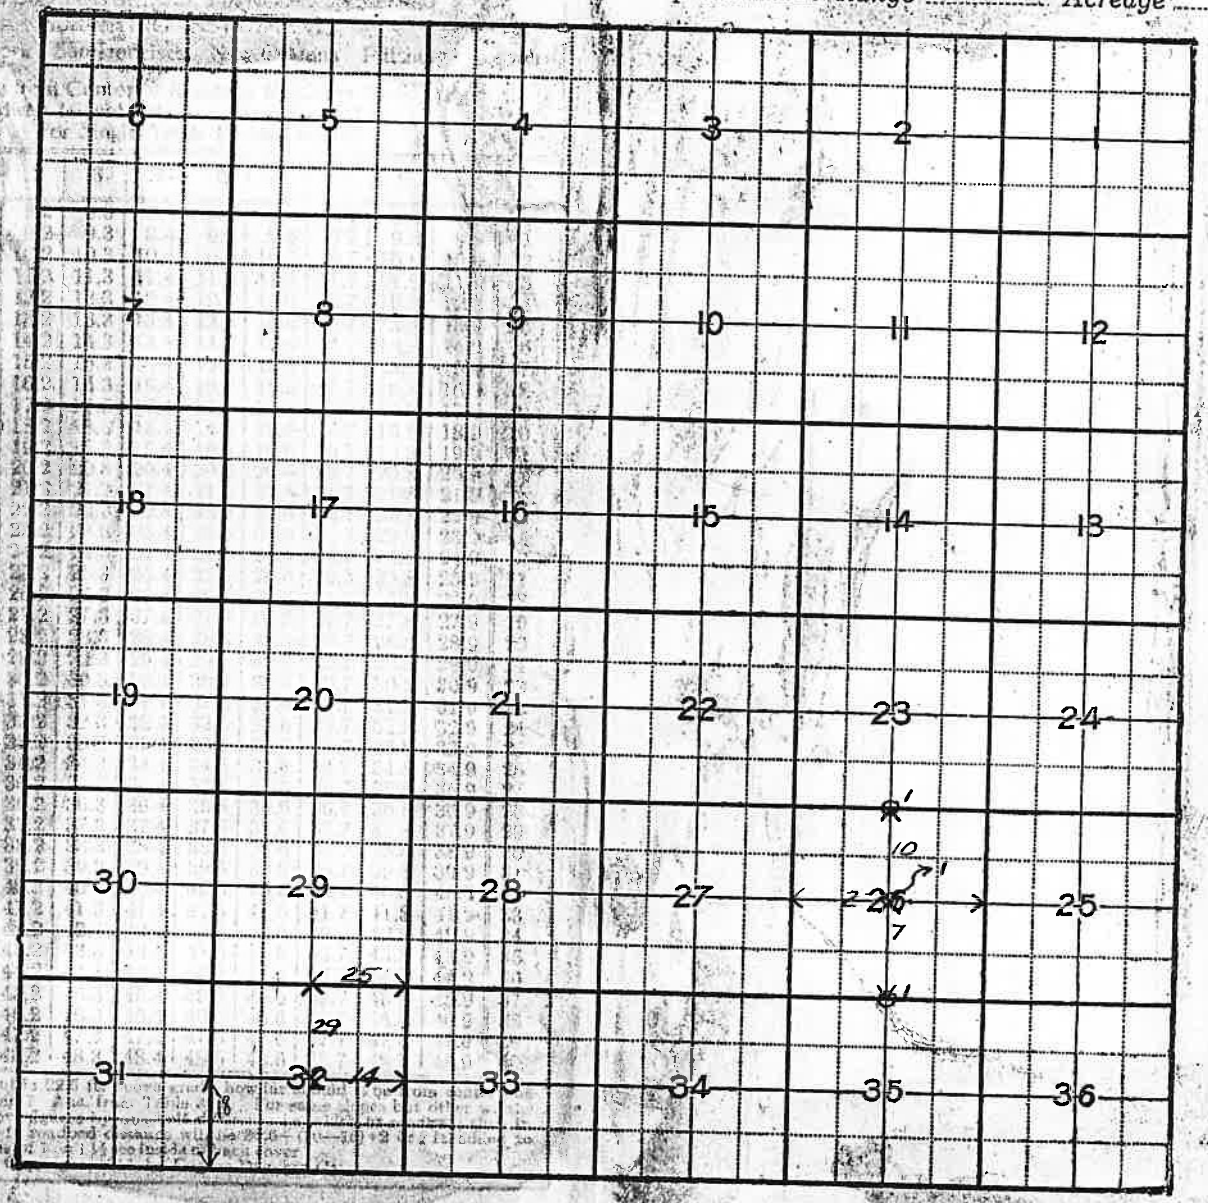

Chicag

H	
0	
1	
2	1
3	1
4	1
5	1
6	1
7	1
8	
9	
Ex
to be n
of road
exampl
30.6 =

1

 

Correction for 1/4 Cor. Sec. 26, 35

From corner established by our traverse go N 70°45'W - 1.09 ch. to true 1/4 Corner.

Correction for 1/4 Cor. 26, 25

From corner established by our traverse go N 72°E - 0.12 ch. to true 1/4 Corner.

First correction for center of section found by running E from 1/4 Cor. 26, 27 go N 24°E 10 lk.

Mostly T 24 S R 11 W
T 25 S R 11 W

Monday - Jan. 9 - 1939 23. (2 flow)

Beginning at 1/4 Cor. 26-27 going East through center section 26.

Poles 6" & 5" Piling - D.F. 60/A.
Heavy salal & Rhododendron
Heavy D.F. & H. Reprod. 10' high

1					
0.0		E	+	-	
	1.0		7		
1.0				36	x ridge down S
	1.0				
2.0				45	Stream
	1.0				
3.0				12	
	2.0				
5.0				8	
	2.0				
7.0			5		
	1.0				
8.0			~~8~~	12	
	1.5				
9.5				28	
	1.0				
10.5				30	
	1.0				
11.5				13	
	2.0				
13.5			13		
	1.0				
14.5			4		
	1.5				
16.0			5		
	2.0				
18.0			6		

X road at 9.5 — 6+27.

9.5
66
570
570
627

13.0 X dry draw C560E

←					
	2.0		T	—	
20.0				15	
	0.5				
20.5				36	
	1.0				
21.5				15	
	2.0				
23.5			12		
	2.0				
25.5			26		
	1.0				
26.5				4	
	0.57				
27.07			19		
	2.0				
29.07			42		
	0.93				
30.0			26		
	1.0				
31.0			12		
	1.0				
32.0			8		
	1.5				
33.5			0	0	
	1.0				
34.5			5		
	2.0				

(3)

40 Cor. on top of Spur ridge

22.5 x branch - 1 lk. W. C. S30°E

24.5 x branch - 1 lk. W. C. S20°W

26.5 x Spur ridge down S.
old gr. D.F. 9/A.
Poles + piling 8 = 16' 20/A.

28.10 x Cr 2 lks W. C. S 30°W
29.0 - W edge of road 0.5 ch.
E of str. Crossing on rd.

SE exp.

28.1
66
16 8 6
16 8 6
185 4 C

29
66
1.74
1.74
1914

			+	−
36.5				13
	2.0			
38.5			8	
	1.5			
40.0			33	
	2.0			
42.0			23	
	0.5			
42.5				15
	2.0			
44.5				25
	1.0			
45.5				14
	2.0			
47.5				27
	2.0			
49.5			38	
	2.0			
51.5			39	
	0.5			
52.0			15	
	1.0			
53.0				9
	0.5			
53.5				

④

39.0 x Str. Blks C S 50° W

Post - 4" Cedar - Center of Sec.

42.5 x ridge down S 50° W

Entering old burn - Alder Thicket

49.4 x Str. Blk. C. S—

5 Exposure - old burn

53.2 x main ridge Down S 60° E

end of days work 1/9/39

4

1-10-39

STA.	DIST	Dir.	AB +	AB −
		E		
53.5				50
	80			
54.3				
	1			75
55.3				
	2			43
57.3				
	1			32
58.3				
	2			40
60.3				
	2			55
62.3				
	2		14	
64.3				
	1.40		43	
65.7				
	.8		13	
66.5				
	.5			17
67.0				
	1.			43
68.0				

Old Burn - Fern - 4 snags, 4 Rotten yellow Fir - 50 Red Fir Reprod To Acre - Steep - EAST Aspect Rododendron

62.3 Dry DRAW West Aspect - Myrtle

66.5 Ridge Top E. Aspect Under Brush, Cedar, Fir Hemlock Alder

5

STAT.	DIST.	DIR.	A +	B. −
68		E		
	1			37
69				
	1			37
70				
	2			30
72				
	1			23
73				
	1			29
74				
	1			35
75				
	1			30
76				
	2			9
78				
	2	N 85° E		25
80				
	9 Links	To ¼ Co.		26 | 25

$\frac{26}{35} \mid \frac{25}{36}$

(5)

EAST Aspect - yellow Fir & snags
225 FT High - 36" DBH. - 6 To Acre
Bracken Fern

72. FLAT Bench - 12 year old Fir, Hemlock

72 / 46 / 43 2 / 43 2 / 43 5 2

Approaching creek 3 FT. Cedar

? 23 22 South 10 W

$\frac{26 \& 25}{35 \mid 36}$

Sec. 26 WED. — JAN. 11, 1939

⊕ STA	DIST	BEAR	ABNEY +	ABNEY −
0+00				
	1	S 2°30 E	16	
1+00				
	1.0		13	
2.0				
	1.0			3
3.0				
	1.0			22
4.0				
	1.0			35
5.0				
	1.0			42
6.0				
	1.0			42
7.0				
	1.0			35
8.0				
	1.0			37
9.0				
	1.0			31
10.0				
	1.0			17
11.0				
	1.0			20
12.0				
	1.0		3	

Running S 2° 30' E from center of Sec ⑧

60/d gr D F / A -

Heavy reprod D F + H. 10'-20'

SE exp.

7.5 crossing road

Piling D.F. 8-20" D.i
Very heavy hem. reprod
10-30'

8			4	-
13				
	0.5			3
13.5				
	1.0			31
14.5				
	1.0			36
15.5				
	0.5		21	
16.0				
	1.0		7	
17.0				
	1.0		1	
18.0				
	1.0		12	
19.0				
	0.57		10	
19.57				
	0.43			15
20.00				
	1.0		0	0
21.0				
	1.0			2
22.0				
	.95			22
22.95				
	1.05			3
24.0	1.			

(9)

Very heavy hemlock repro
10-30 feet high

D.F. Piling 60/A - 10"-20" DBH

13.0 Crossing trail at rt ang

15, 30 x str. - 2 lk. wide
Course S 30° W

W exposure

			+	−
	1.0		0	0
25.0				
	0.5		0	0
25.5				
	1.0			2
26.5				
	2.0			9
28.5				
	1.5			2
30.0				
	1.0			16
31.0				
	1.5			7
32.5				
	0.61		7	
33.11				
	1.0			20
34.11				
	1.0			20
35.11				
	2.0			15
37.11				
	1.49		0	0
38.60				
	0.40		0	0
39.0				
	1.0			1
40.				

Old gr. Fir 15/A.
Hemlock reprod.
Piling 20/+.
Rhododendron

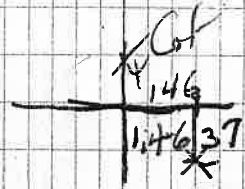

Line intersects sec. line 1.46 chs E of ¼ Cor. Dist. from center to intersection 7.9.63

Thursday, Jan. 12, '39

N2°30'W

		+	−
0.0			
	2.0	25	
2.0			
	2.0	34	
4.0			
	1.0	41	
5.0			
	1.0	36	
6.0			
	1.0	31	
7.0			
	1.0	21	
8.0			
	1.0	14	
9.0			
	.65		26
9.65			
	?		5
11.65			
	1	40	
12.65			
	.50	7	
13.15			
	1.		40
14.15			
	2		28

Running N2°30' W from center of [illegible] 26 — (11) 25/A

Large piling - 12" - 24" DBH -

Hemlock & D.F. repres. 10'-40 ft. h/t

2nd. gr D.F. 24" - 30" DBH h/L

Heavy rhododendron —

S W exp.

9.00 Ridge slope

11.xx dry draw

13.xx Ridge slope

STA	DIST	Direct N 2°00' W	+	ABney —
16.15				
	1			25
17.15				
	2			29
19.15				
	.85			56
20,00				
	1.			34
21.00				
	1		8	
22,00				
	1			12
23,00				
>	1.0			5
24.00				
	1.5			13
25.15				
	.72			10
26.22				
	1			45
27.22				
	1			34
28.22				

Running N 2°W From center see 26

(12)

West Exposure
10 Trees To Acre MAX 24" DBH

AT 20,00 on SCTA to corner using 2in Hazel - on steep slope
SW Exposure
Small Alder, Cedar, - MAX - 4FT Fir
Approximately 15 FT. D.B.H.

W Exposure - Steep West slope

W Exposure ABney 57
Sapling And Small Pole
Reprod. D.F. + Hemlock

EAST Exposure - 2 snags
Per Acre - Hazel Brush -
Rodedendron -

12

STA	DIST.	DIRC.	A +	B −
28.22				
	1			54
29.22				
	1			35
30.22				
	1.5			27
31.72				
	1			43
32.72				
	1			46
33.72				
	2			18
35.72				
	1.60			1
37.32				
	1			35
38.32				
	1			31
39.32				
	17 To sec Line			0
39.49				

(13)

EAST ASPECT

30.00 good graded Trail.
Running E + W.
old Rotten Fir 2 To Acre 4' DBH

16 Links N 72° W To True 1/4 Cor.
Creek Bottom - Alder patch
Fern snags + Cedar on
N slope

14		21.00' W	+	−
0 to				
	1.0		9	
1.0				
	1.0			21
2.0				
	2.0			16
4.0				
	1		11	
5.0				
	2			18
7.00				
	.5			0
7.50				
	2.0			30
9.50				
	.5			31
10.00				
	1.			41
11.00				
	1			44
12.00				
	1			15
13.00				
	1			20
14.00				
	1			17

N
W E
S

Monday - Jan. 16, 1939 (19)

Traverse W from 1/4 Cor - 32, 33

Second Gr. D.F. 30/A - 20-30 Dg

4.5 dry draw Running South

Tally STAKE

5.00 Ridge Running South

Copius Am. of Spiral

SW Exposure

12.5 Creek Running South

12.5

13.00

5.0 - S25°W

		DIG	+	−
15.00		W		
	2		8	
17.				
	1		40	
18				
	2		31	
20				
	1.5		35	
20.5				
	1.		35	
21.5				
	1		45	
22.5				
	1		41	
23.5				
	1.5		50	
25.00				
	1.0		47	
26.00				
	1.		40	
27.00				
	1		40	
28.00				
	1		21	
29.00				

START

31 32 33

EAST Aspect - 12" DBH Hemlock - DF 36" DBH 14" DBH Cedar - 15 Fir To Acre old stub snags - Lots of moss on Hem + cedar

¼ Cor, in open 25 ch ABOVE Creek

EAST Aspect steep slope

SMALL in copies AMOUNT

8 stubby snags To Acre Approaching ridge Top

	DIST.	DIR W	ABNEY +	ABNEY −	
29					
	1		14		
30					
	2		15		
32					
	1		10		
33					
	2		15		
35					
	2		19		
37					
	2		34		
39					
	1		23		
40					
	2		0		
42					
	2		19		
44+00				Ridge Top	
	.5		6		
44+50					
	.5			16	
45+00					
	1		~~5~~	38	
46+00					

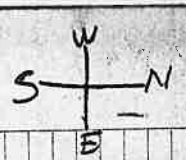

(17)

Broken Top Trees, Ac. Wind
To Dg stocked with DF
24" in DBH

SE. Aspect Break on
N. About 5 chains

SE. Aspect DF 24" To 30" in DBH
Slope closing in on The N.
EAST Aspect

Line

Deep dry draw Gch
To The N. To Another
Ridge

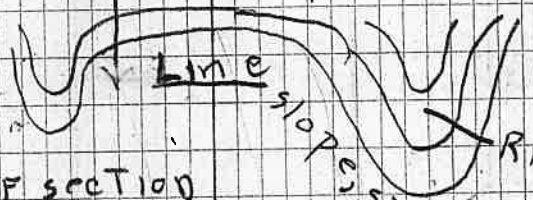

Center of section
Directly N 30 Links
From Big Fir 4' DBH
Blazed on 3 side N, S, & W.

17

STA.	DIST.	DIRECT	ABney +	ABney −
46+00	W	W		41
	1			
47+00				31
	1			
48+00				15
	2			
50+00				1
	2			
52+00				8
	2			
54+00				1
	1			
55+00		JAN 16-1939		

REFER TO PAGE 21

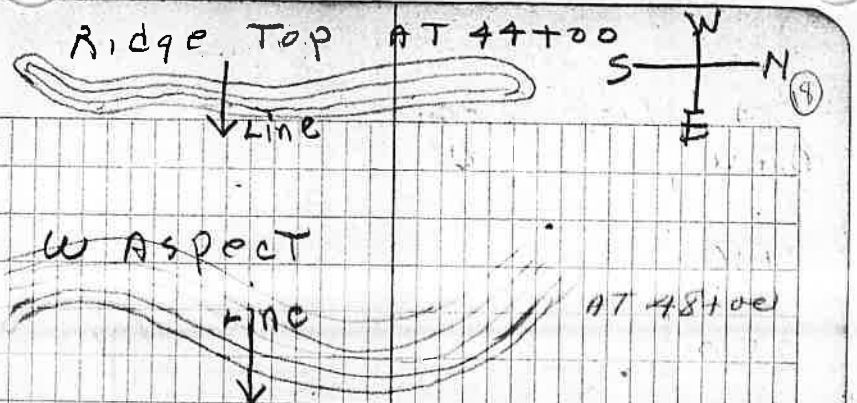

9

31 | 32

JAN 18 1939 HENEY

⑧ STA	DIST	BEAR N	+
0+00			
	15		31
1+50			
	1		46
2+50			
	15		40
3+00			
	1		38
4+00			
	2		13
6+00			
	2		22
8+00			
	1		28
9+00			
	1		22
10+00			
	2		16
12+00			
	1		4
13+00			
	1		10
14+00			
	1,5		8
15+50			

(19)

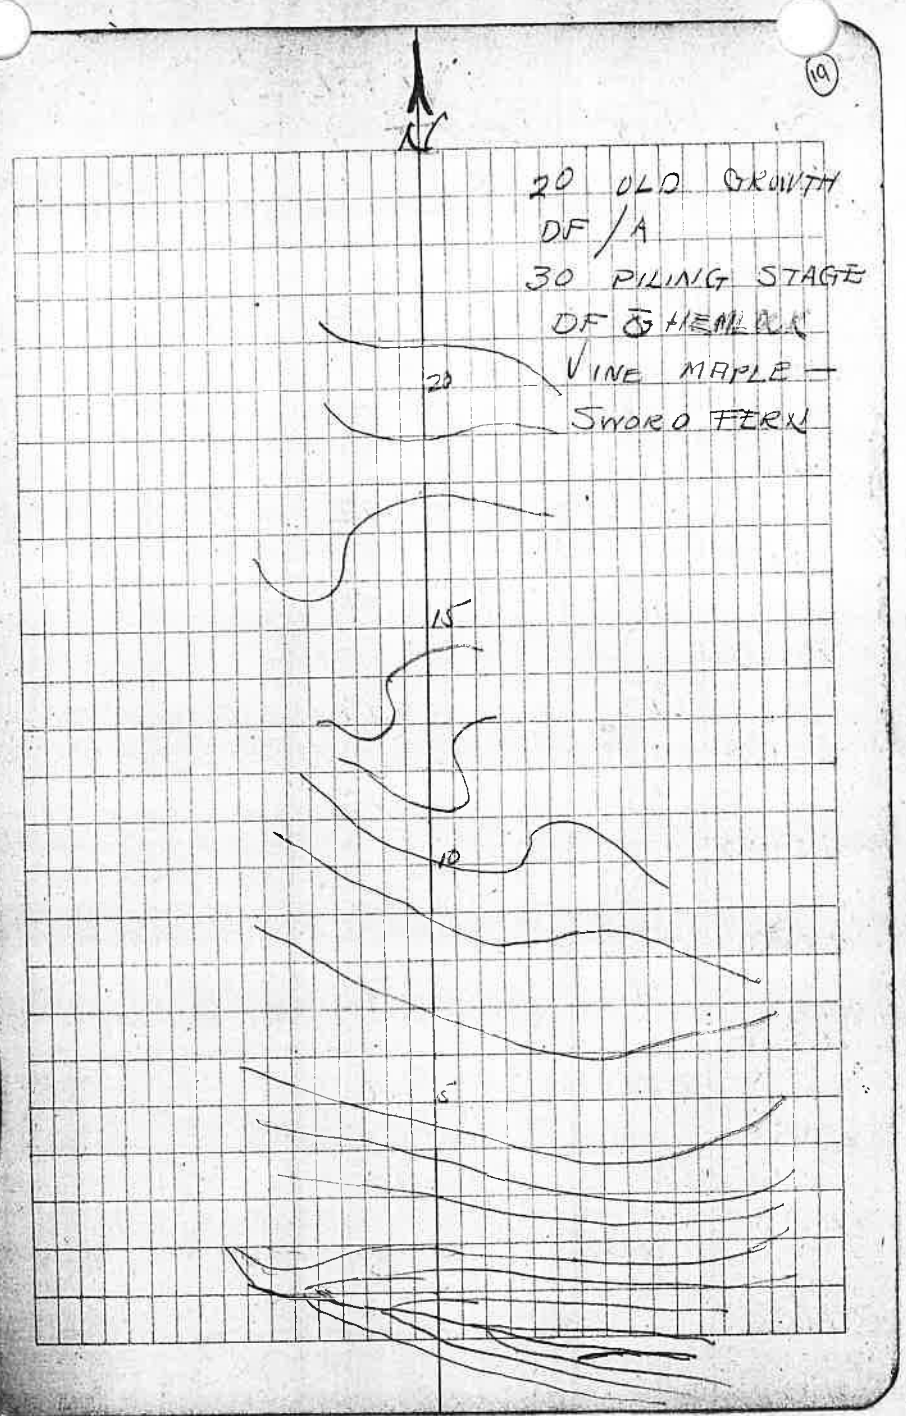

19

STA	DIST	BEAR	FIBMEN +	FIBMEN −
15+50				
	2		5	
17+50				
	1		17	
18+50				
	1½		30	
20+00				
	1½		22	
21+50				
	1		9	
22+50				
	1		17	
23+50				
	1½		17	
25+00				
	1½		21	
25+50				
	1		9	
26+50				
	1		10	
27+50				
	2		70	
29+50				
	1½		0	
30+00				

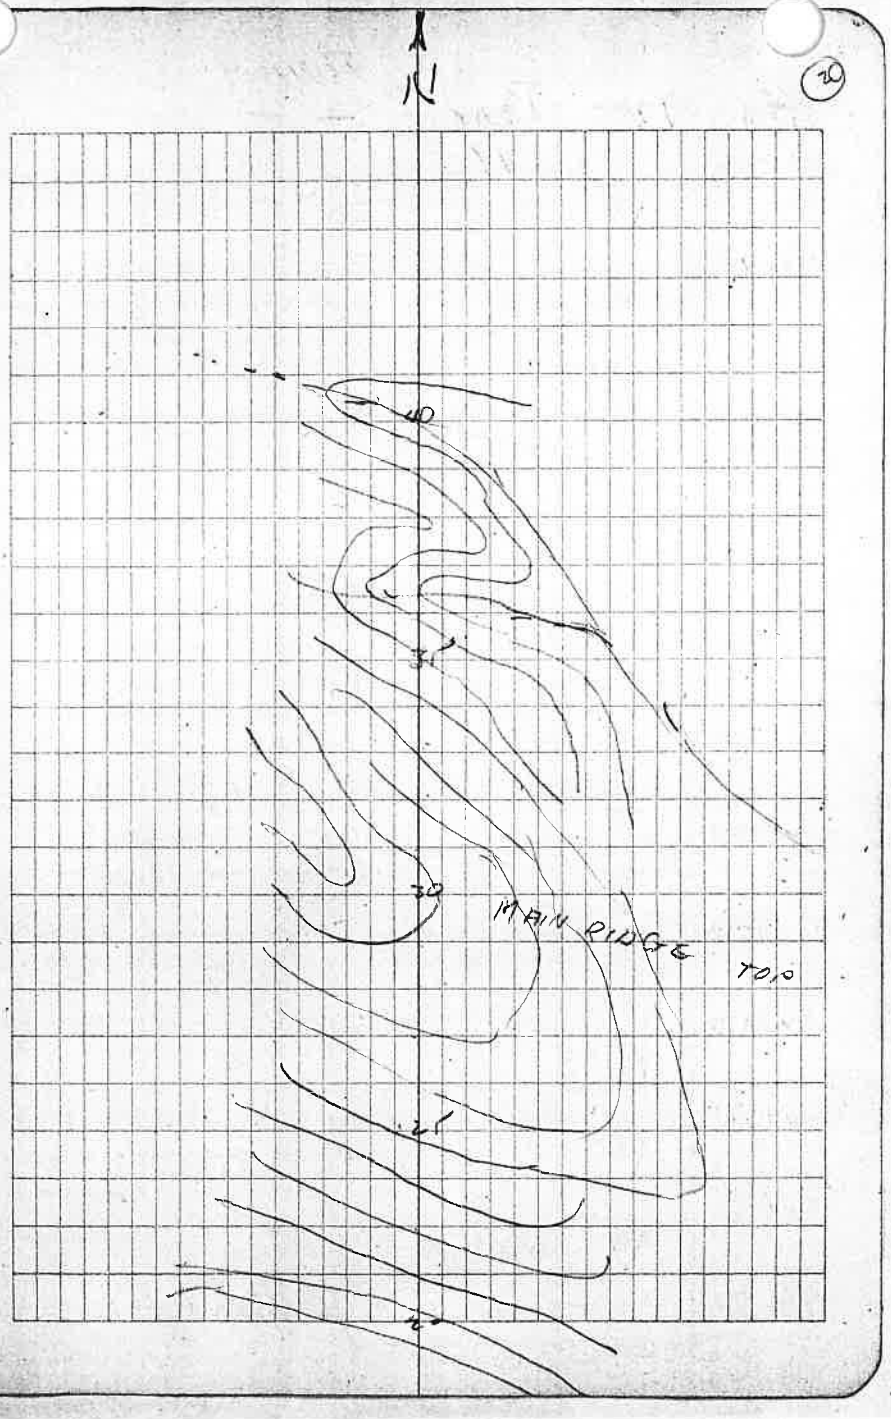

20

STA	DIST	BEAR N	ABNEY +	ABNEY −
32+00				
	15		20	
30+50				
	1		25	
31+50				
	1		3	
32+50				
	15		26	
33+00				
	1		45	
34+00				
	1		35	
35+00				
	1			16
36+00				
	2			24
38+00				
	15			7
38+15				
	2			9
40+50				
	16			20
41+10				
	41	N19°W		
41+57	TIED INTO 1/4 COR BETWEEN SEC 32 & 31			

(21)

21 Continued from page 17

STA	DIST	BEAR	ABNEY +	ABNEY −
55+00		W		
	15			√
57+00				
	2			20
57+50				
	72			√
58+22				
	78			2
60+00				
	2		20	
62+00				
	1			
63+00				
	2		20	
65+00				
	76			20
65+76				
	1			48
66+76				
	24		32	
68+06				
	1		28	
69+00				
	1		15	
70+00				

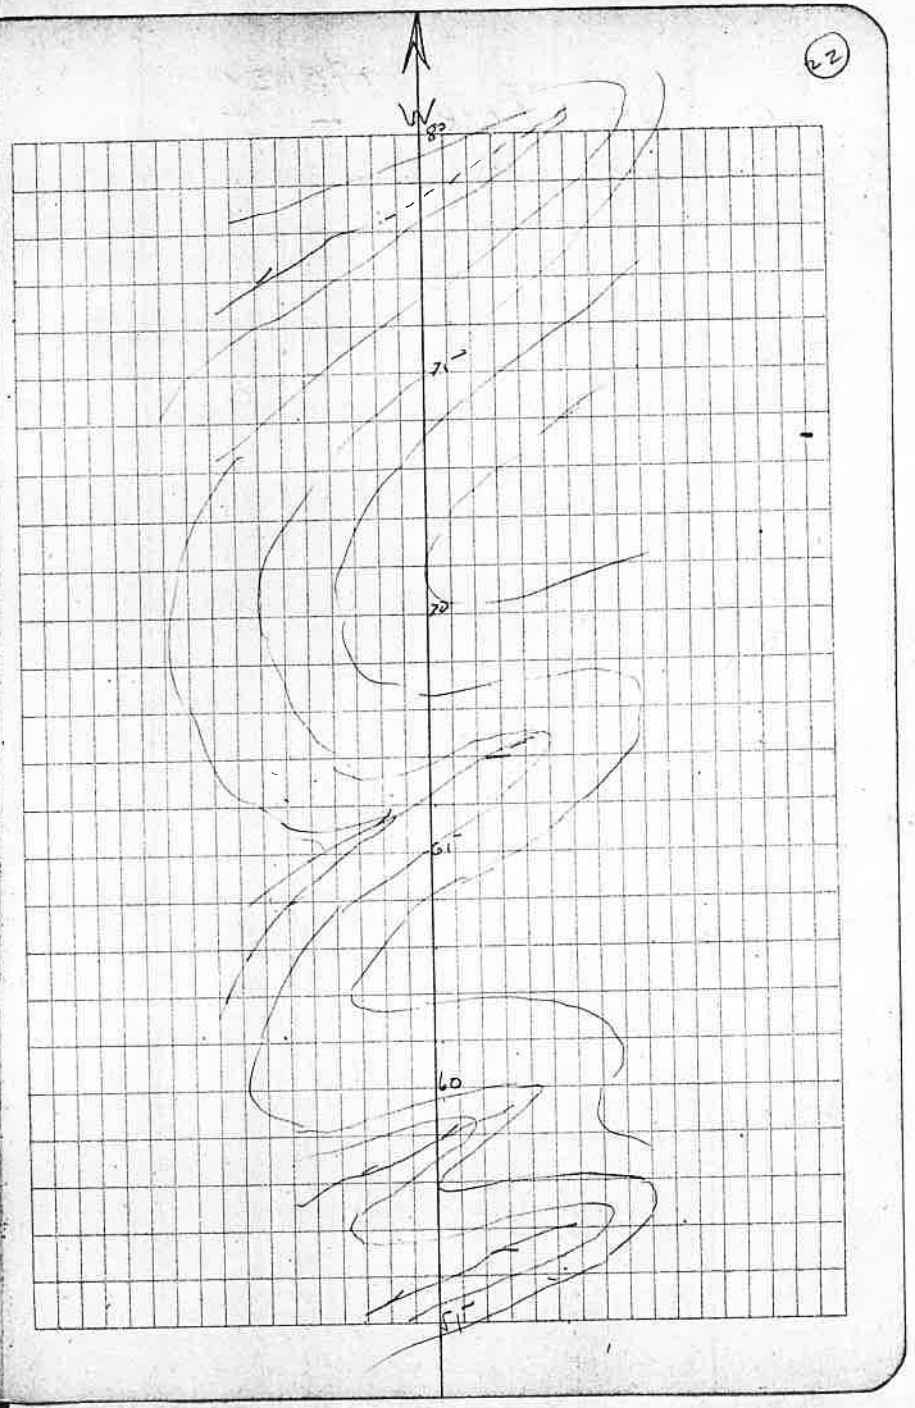

22

22

STA	DIST	BEAR W	FIBNEY +	FIBNEY −
70+00				
	180			9
70+80				
	120		5	
72+00				
	150			9
72+50				
	100			30
73+00				
	100			47
74+00				
	100			12
75+00				
	150			12
75+50				
	100			44
76+50				
	200			9
78+50				
	150		19	
80+00				

(23)

VEGETATION — 10 DF/A AVE. DBH 36"
15 HEM/A " " 30"
ABUNDANT SWORD FERN & SALAL — WITH OPE GRAPE UNDERCOVER — REPROD. SCARCE.

29 / 28 / 32 / 33		21° W	+	−	
0+00					
	2.0		48		
2+00					
	2		42		
4+00					
	1		52		
5+00					
	1		54		
6+00					
	1		44		
7+00					
	1		40		
8+00					
	1		1		
9+00					
	1		6		
10+00					
	2		12		
12+00					
	1		35		
13+00					
	1		15		
14+00					
				25	
	.74				
14+74					
	26			45	

January 24

(25)

Running W From 2 1/24/39

29 28 / 32 33

old snags / To AC. Pole cedar + Hemlock

Through D.Fir and Hemlock 2nd Growth - Ave. dia. 16" and 60 Trees per acre

Sta. 13+76 Top of Ridge Elk pk. trail Course N 35 W -

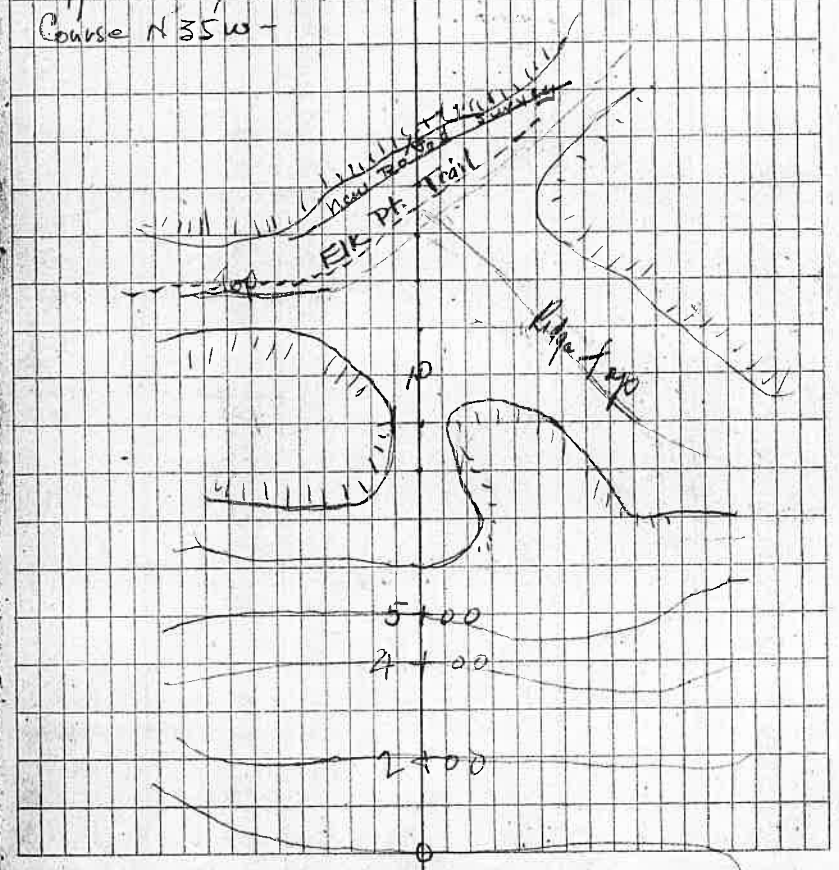

25

Sta.	Dist.	Beer. W	Abney +	—
15+00				
	2			32
17+00				
	1		0	
18+00				
	1			9
19				
	1			4
20				
	1			5
21				
	1			13
22				
	2			4
24				
	1			3
25				
	1			10
26				
	2			11
28				
	2			4
30				
	.60			4
30.60				
	1.10			16

1x4/39

North Line Sec. 32
Running W from Cor

29 | -8
32 | 33

(26)

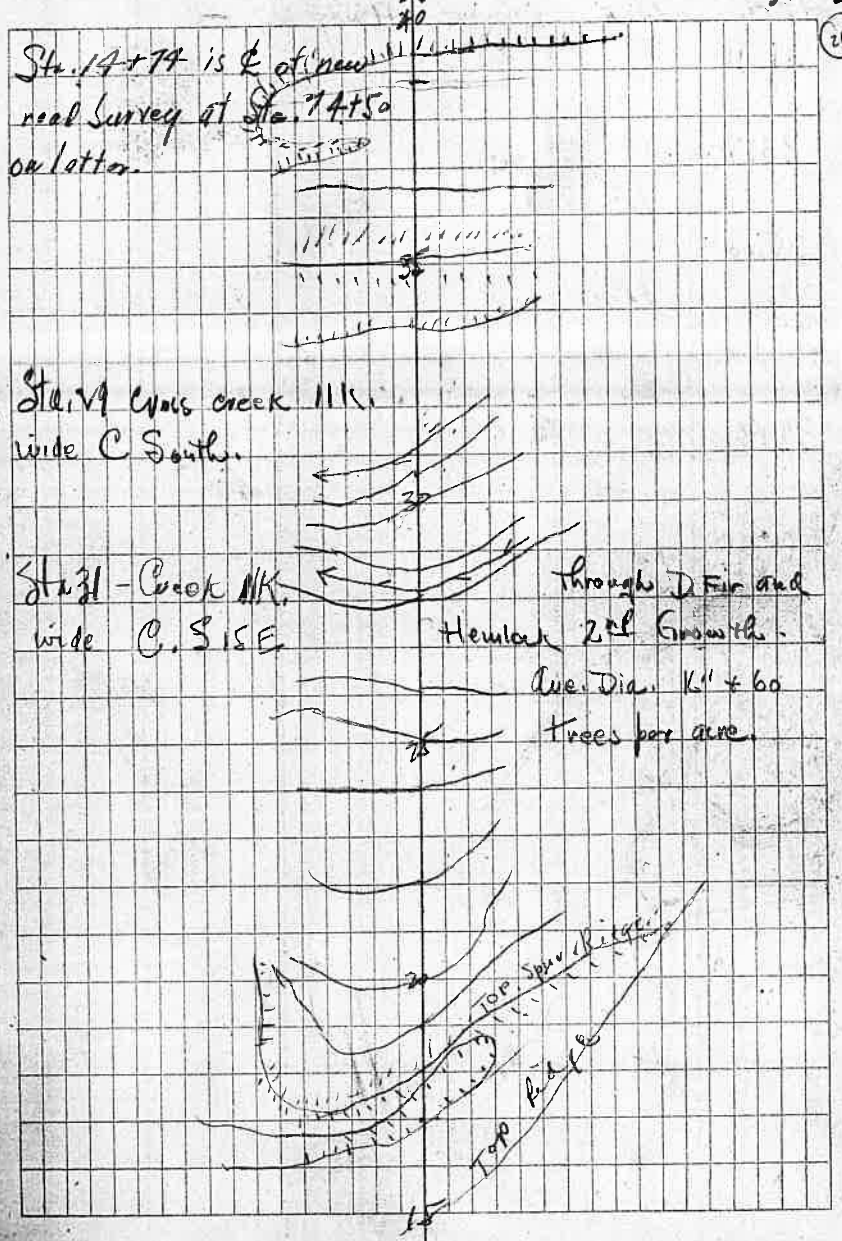

26

Sta.	Dist.	Bear	Money +	−
31.70		W		
	2		20	
33.70				
	1.30		12	
35.00				
	1.60			11
36+60				
	2.			25
38+60				
	1.40			48
40+00				

North Line Sec. 32
Running W from Cor. 29/28 / 32/33
11/9/39 (27)

Sta. 40 is 10 links E of 1/4 Corner 32/29
1/4 Stake not found.
Both Bearing trees found – 8" alder is dead & Broken off. 8" D.Fir is standing. Chopped Fir out & found scribe marks as follows:
"1/4 C 29. BT".

Set Hemlock stake 4" sq. & 3' high For 1/4 corner, marked in keel as follows: "S. 29" on N; "S. 32" on S; "1/4" on W; and "T 23S – R 10W" on E side.

29

STA	DIST	BEAR	HENLEY ↑	HENLEY →
0+00		S		
	15			8
0+50				
	2			18
2+50				
	2			20
4+50				
	15			23
5+00				
	1			27
6+00				
	2			22
8+00				
	1			18
9+00				
	1			19
10+00				
	1		34	
11+00				
	1		30	
12+00				
	1		38	
13+00				
	1		38	
14+00				
	1		17	
15+00				

39

BEGINNING AT 1/4 CORNER BETWEEN
SEC 32 & SEC 29

VEGETATION:—
HEMLOCK – AVE DBH 24" 12/A
DF " 48" 8/A.
SWORD FERN – VINE MAPLE

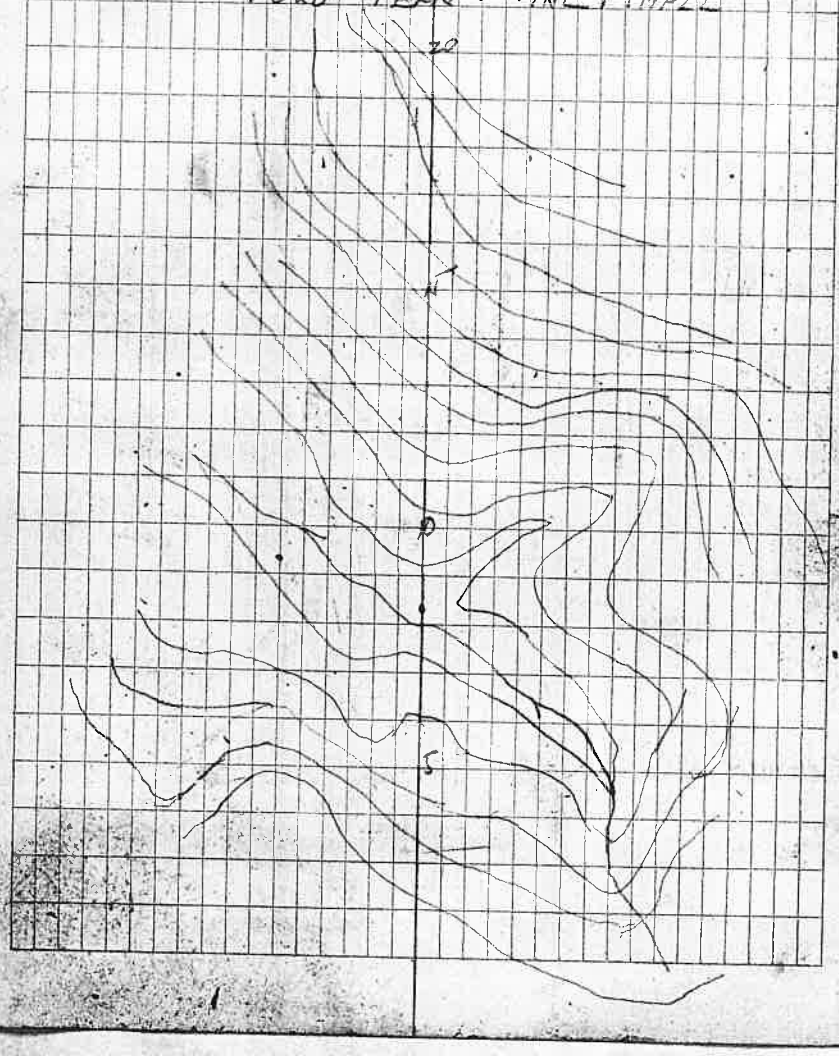

30

STA	BEAR	DIST	ABNEY +	ABNEY −
15+00	S			
		1	23	
16+00		1	30	
17+17		2	23	
19+17		183		
20+00		16	8	
20+50				
		2	28	
22+50		15	25	
23+00		1	18	
24+00		1	11	
25+00		1	34	
26+00		1	65	
27+00		1	55	
28+00				

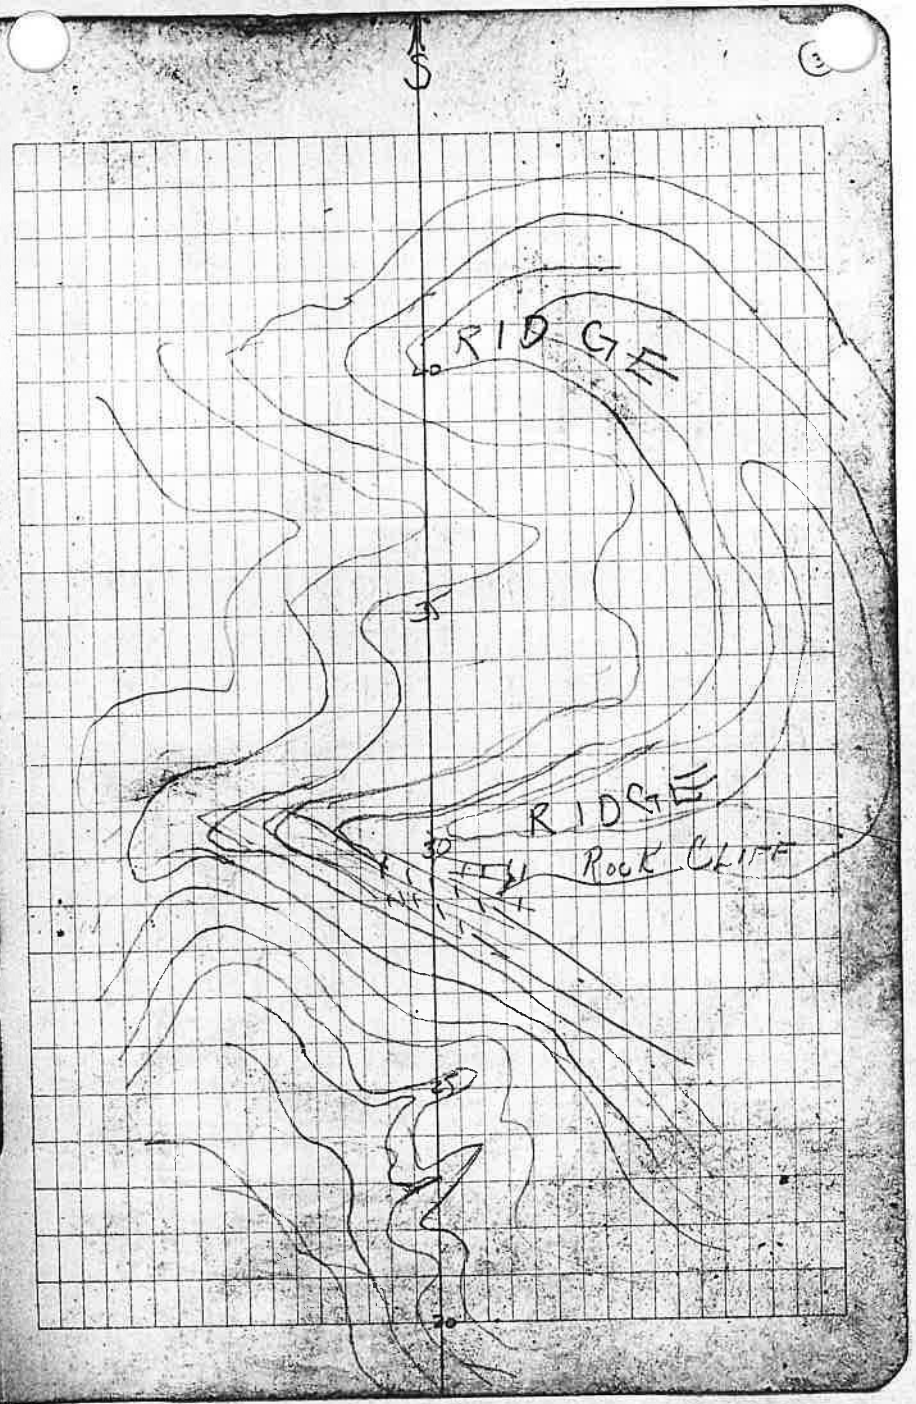

STA	BEAR	DIST	FILL +	FILL −
28+00	S		90	
		1		
29+00				
		15	52	
29+50				
		5	34	
30+00				
		5	15	
30+50				
		1	9	
31+50				
		1	1	
32+00				
		1		5
33+50				
		15		7
35+00				
		1		25
36+00				
		1		19
37+00				
		1	18	
38+00				
		1	41	
39+00				
		65		
39+65				

STA 39+65 IS 4 LKS E OF HUB OF Sec 32

32

STA	BEAR	DIST.	+	−
0+00				
	W	1 61		3
1+60				
		¼ CORNER ESTABLISHED		
0+00				
	W	1 15	32	
1+50				
		1	38	
2+50				
		2	31	
4+50				
		1 75		5
5+25				
		R 25		24
6+50				
		1		37
7+70				
		2		38
9+50				
		1 15		1
11+00				
		64		15
11+66				
		1 34		30
13+00				

FIBREY

33

RUNNING W ON 23° 30' DEG.
FROM TRAIL TO ¼ CORNER
BETWEEN Sec 18 & 19
T24S R11W

Random Line – NOT True ¼ Corner

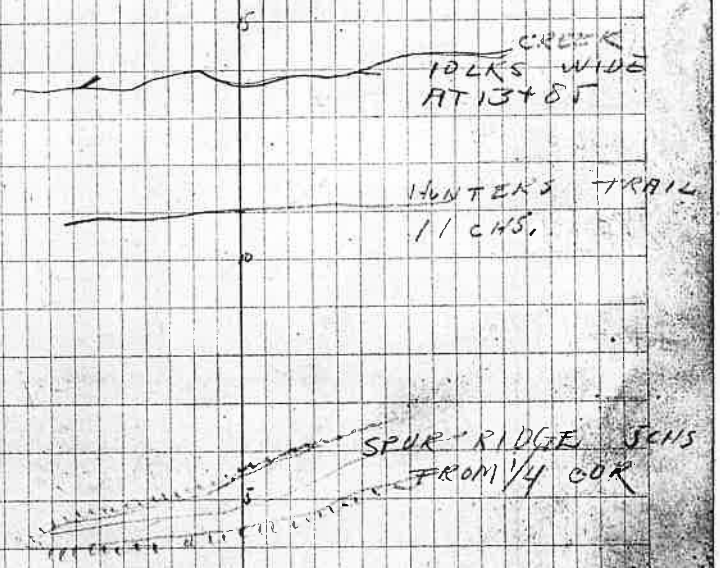

STA	BEAR	DIST.	ELEVATION +	ELEVATION −	
13+00					
	W	2	15		
15+00					
		1	60		
16+00					
		1	68		
17+00		1	48		
18+00					
		1	48		
19+00					
		1	47		
20+00					
		1 33	38		
21+33					
		38		2	
21+71					
		2		24	
23+71					
		2	27		
25+71					
		1	40		
26+71					
		1	18		
27+71					

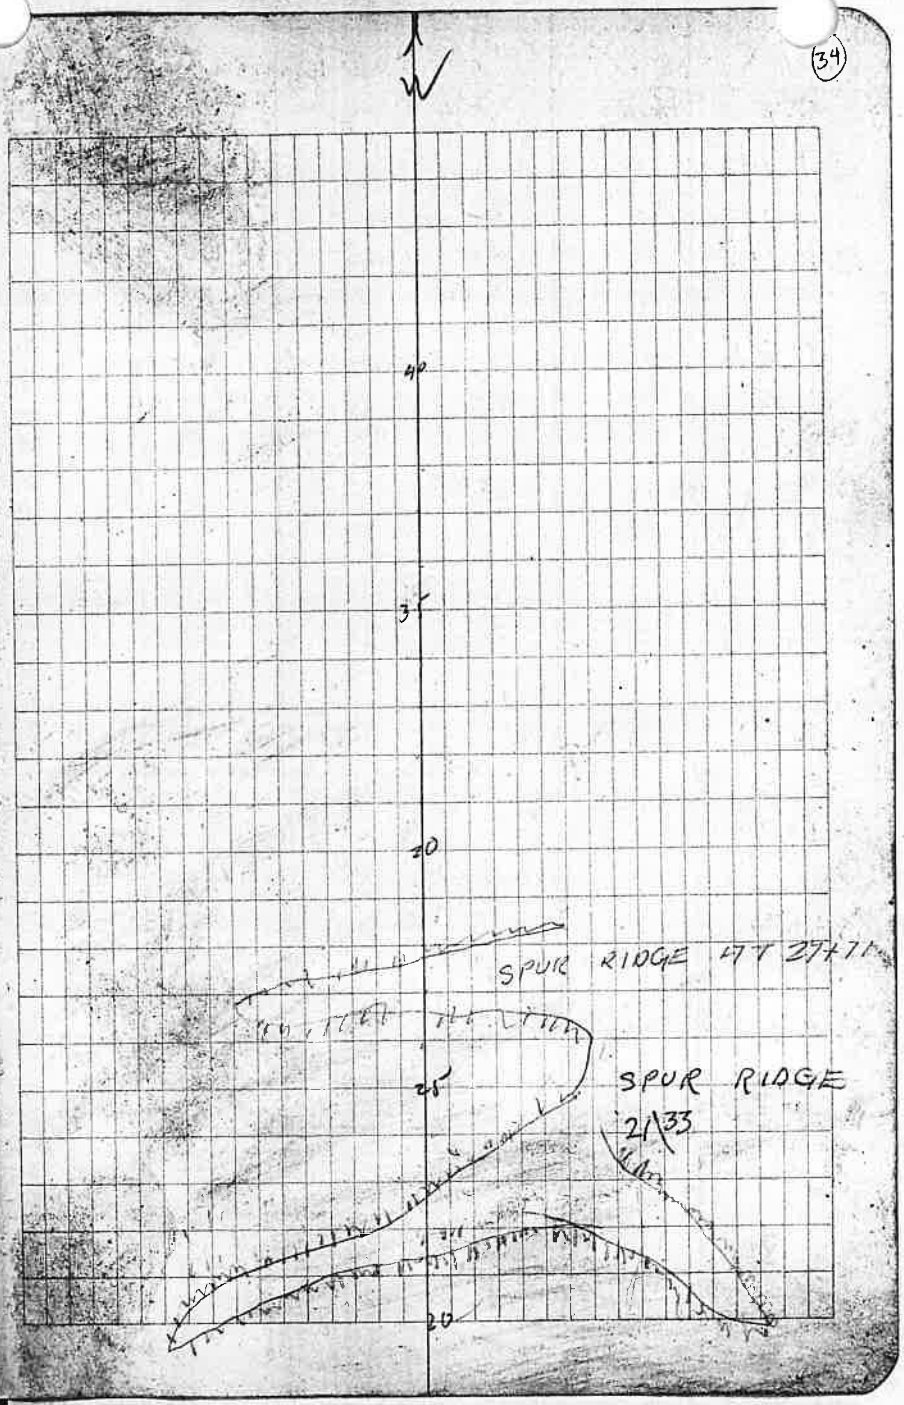

STA	BEAR	DIST	PLUS +	MINUS −
27+71	W			
		2		8
29+71		49		10
30+20		1		9
31+20		30		0
31+50		1		21
32+10		1		18
33+50		50		
34+00		1		54
35+00		1		48
36+00		20		28
37+20				

Wednesday. Feb. 2, 1938

35 Running West From 1/4 18/19 To west Line Abney.

STATION	Direc.	DIST.	+	−
	W			
37+20				
	OFFSET S	1		41
1+00				
	S	1		13
2+00				
	S	1	7	
3+00				
	S	1	4	
4+00				
	W	2		52
39+20				
	W	2		10
41+20				
	W	1	3	
42+20				
	W	1		25
43+20				
	OFFSET S	.75		30
4.75				
	W	1.		32
44+20				
	W	2		16
46+20				
	W	1,50		

VARIATION 0 = 23° E

(36)

See Feb. 3 For Topography

This Line Run To ESTABLISH LOCATION OF 13/18 24/19

STA.	Dir.	Dis.	ABNey +	ABNey −
47+70				
	W	2		8
49+70				
	W.	.50		60
50+20				
	W	.60		60
50+80				
	W	1.00		50
51+80				
	W	.75		=
52+55				

LOCATION OF 1/4 COR. TAKEN AT RANDOM FROM A LOCAL RESIDENT. FOUND ERROR OF ABOUT 1 TALLY AFTER RUNNING 36 CHAINS TO WEST, THEN TOOK OFFSETS TO SOUTH. SECTION COR. 13 | 18 / 24 | 19 WAS NOT FOUND, WAS REESTABLISHED FROM LOCATION OF A BEARING TREE WHICH WILL BE OBLITERATED BY ANOTHER YEAR.

STA	BEAR	DIST	DENEY +	DENEY −
0+00	N			
		1		55
1+00				
		2		38
3+00				
		2		22
5+00				
		2	38	
7+00				
		2	39	
9+00				
		1	35	
10+00				
		1	25	
11+00				
		1	25	
12+00				
		1	10	
13+00				
		2	3	
15+00				
		1	8	
16+00				
		2	10	
18+00				

CONTINUED PAGE 41

STARTING Sec Cor 18-19 T24S R11W — Sec Cor 13-24 T24S R12W

DECLINATION — 21° EAST

VEGETATION: —

2ND GROWTH DF
24" DBH — 10/ACRE
MYRTLE
HAZEL
VINE MAPLE

SWORD FERN
SALAL

38

STA	BEAR Ft	DIST	FIBNEY +	FIBNEY −
0+00				
		25		39
2+50				
		2		45
4+50				
		2		10
6+50				
		2	11	
8+50				
		15	10	
10+00				
		1	45	
11+00				
		1	45	
12+00				
		1	35	
13+00				
		1	25	
14+00				
		1	15	
15+00				
		1	10	
16+00				
		1	8	
17+00				
		2	10	
19+00				

STA 0+00 AT Sec Cor of 18 & 19
T24S R11W. — Secs. 13 & 24
T24S R12W.

39

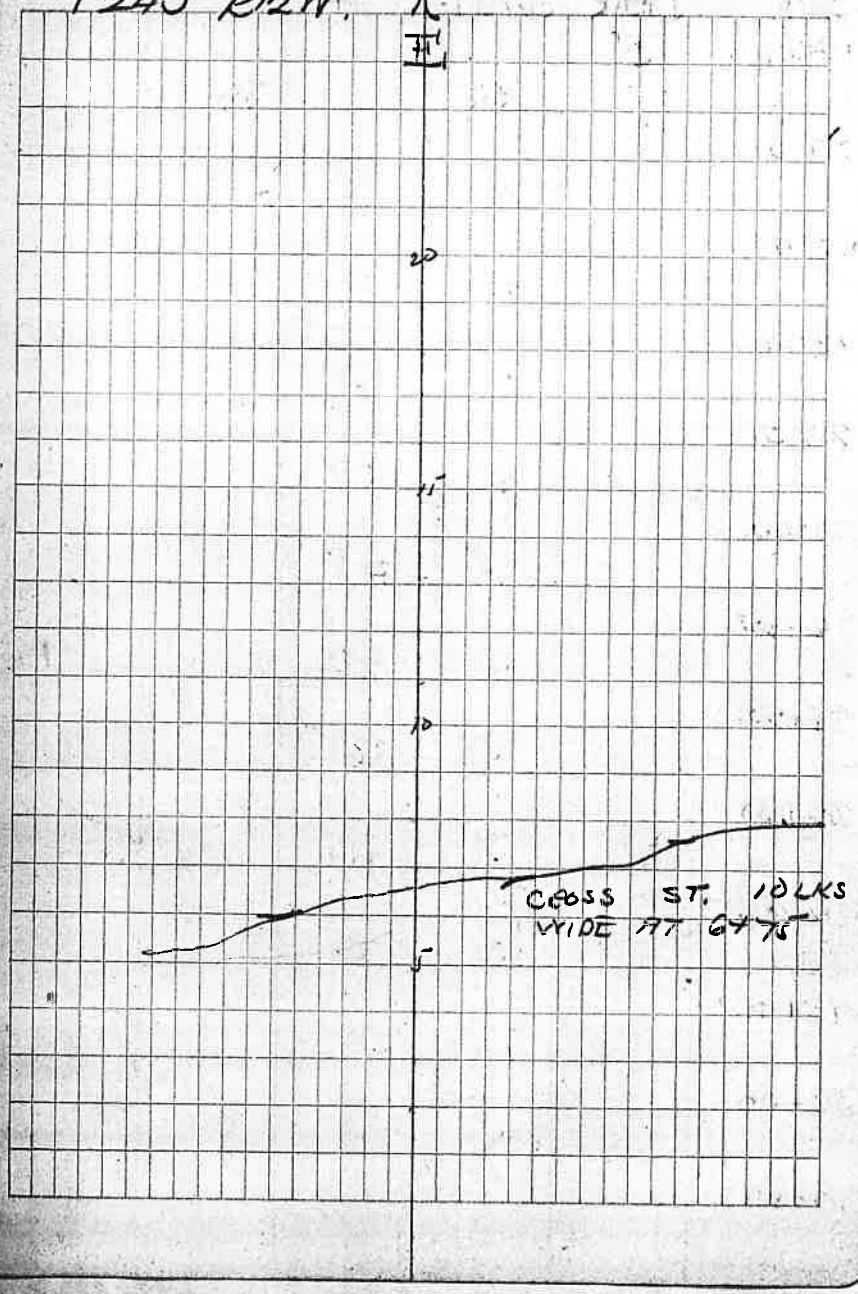

STA	CLEAR	DIST.	FOREV +	FOREV −
19+00	E.			
		1		7
20+00				
		1	27	
21+00				
		1	18	
22+00				
		1	13	
23+00				
		1	37	
24+00				
		1/5	28	
24+50				
		1	22	
25+20				
		1/5	35	
26+35				
		1/5	61	
26+80				
		2	0	
28+80				
		1 1/2		5
30+00				
		1/5		8
30+50				

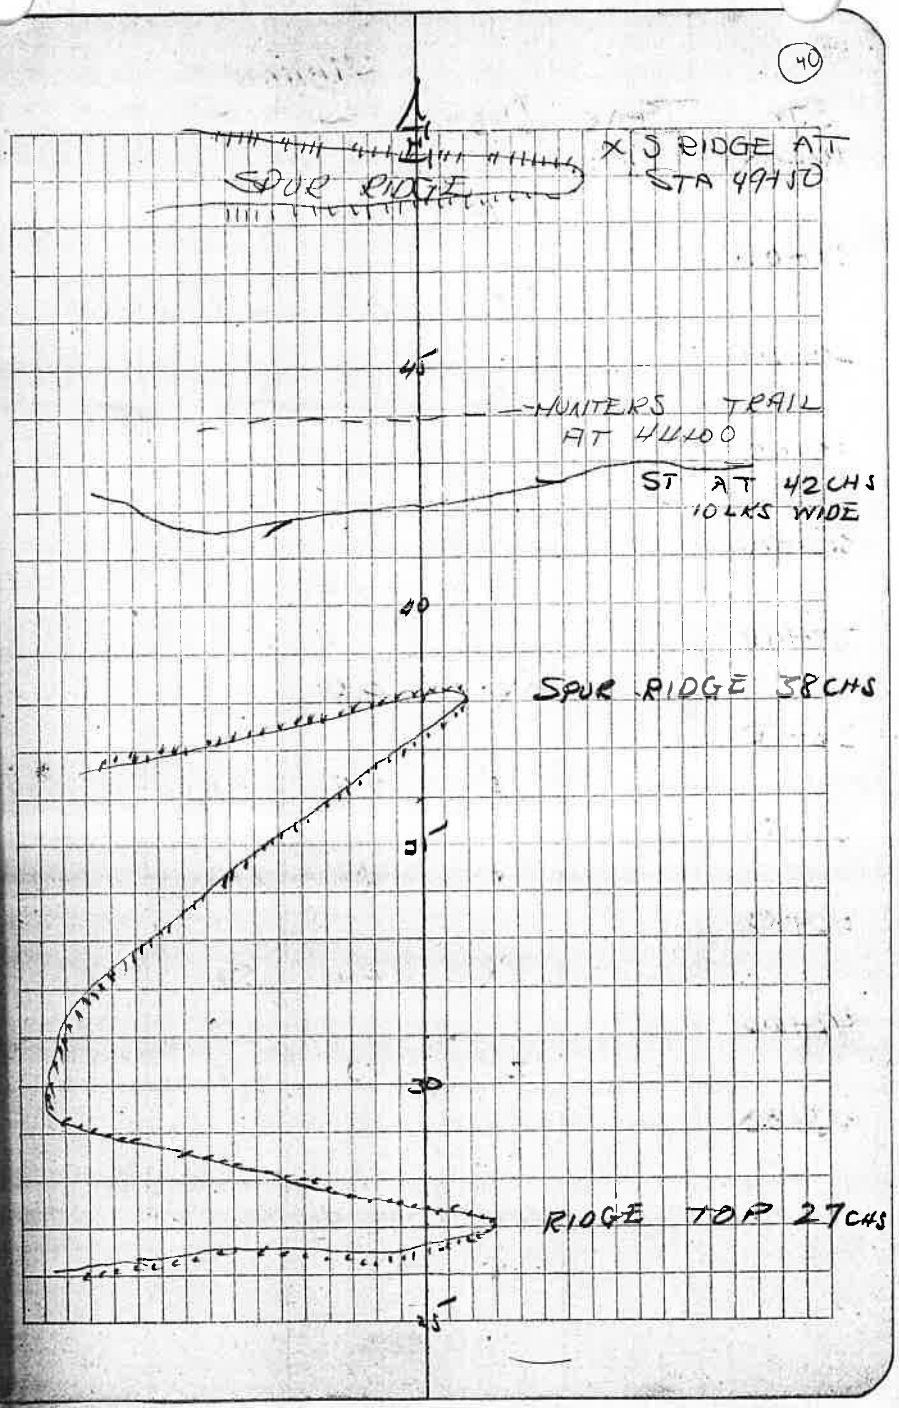

STA	BEAR L'	DIST	ABNEY +	ABNEY −
30+50				
		15		11
31+00				
		1		47
32+00				
		2		45
34+00				
		2		25
36+00				
		1	23	
37+00				
		1	22	
38+00				
		1		31
39+00				
		1		48
40+00				
		1		52
41+00				
		2		22
43+00				

CON'T. PAGE 46

VEGETATION ON SLINE SEC 18

2ND GROWTH DF 10" A 20" DIA.
MYRTLE
SALLAL
HUCKLEBERRY
SWORD FERN
ALDER
VINE & BIG LEAF MAPLE

EVIDENCES OF OLD SEVERE BURN.

MUCH ROCK OUTCROPS

41

STA	BEAR	DIST	ABNEY + —	
18+00	N			
		1	29	
19+00				
		1	35	
20+00				
		1	24	
21+00				
		2	34	
23+00				
		2	35	
25+00				
		1	45	
26+00				
		2	49	
28+00				
		2	62	
30+00				
		2	29	
32+00				
		1	0	TOP MAIN RIDGE RUNNING N 60° W
33+00				

42

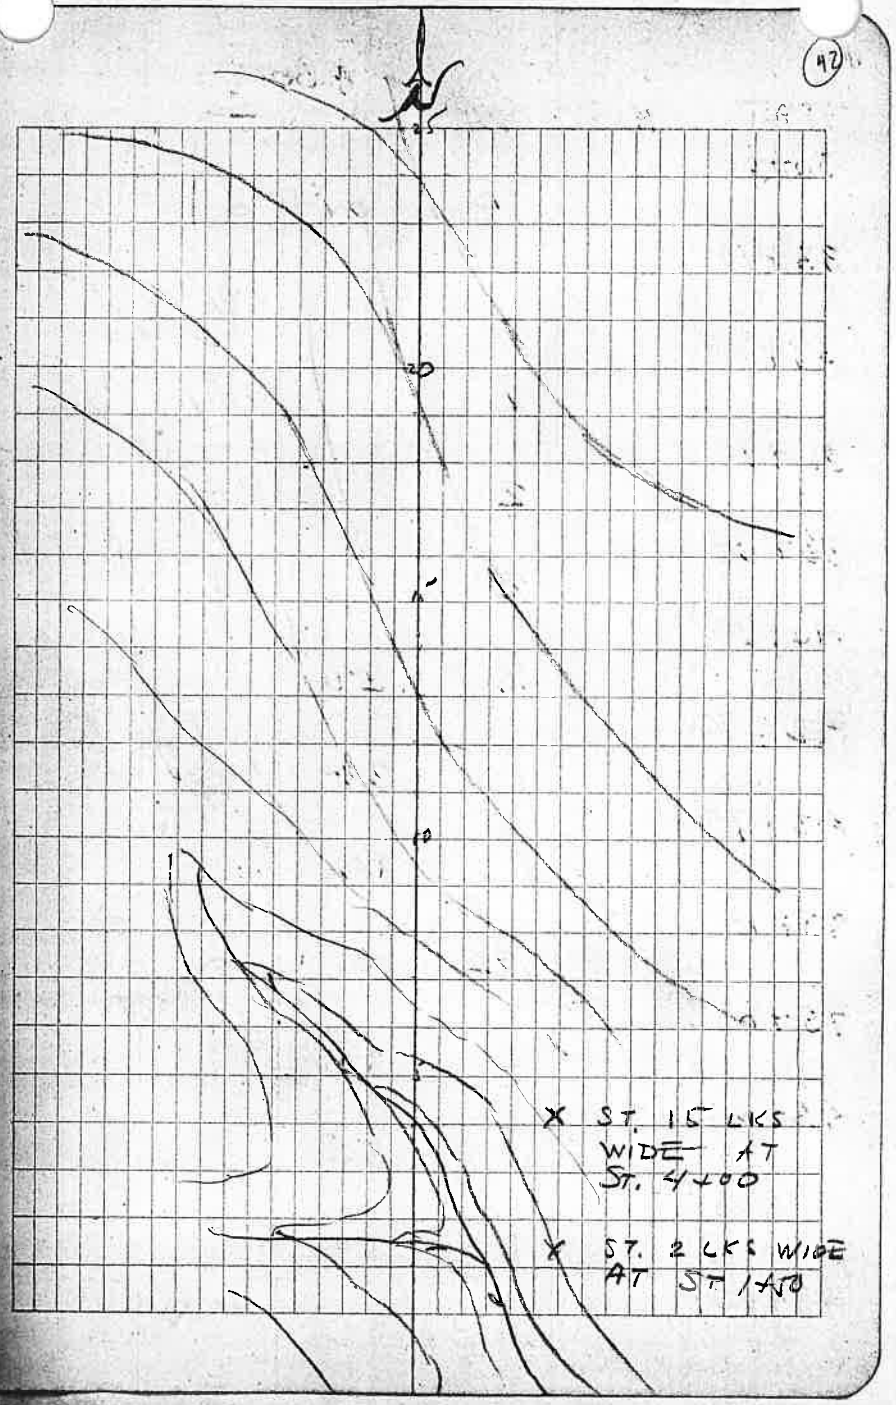

42

STAT.	N	DIST.	ABNCY +	ABNCY −
33+00				
		.74	0	0
33+74				
		1		62
34+74				
		2		48
36+74				
		2		24
38+74				
		2		26
40+74				
		2	50	
42+74				
		1	34	
43+74				
		1	36	
44+74				
		.26	0	0
45+00				
		1	36	
46+00				
		1	35	
47+00				
		1	12	
48+00				

FeBruary 14, 1939
Variation 0° 2' E From North
North From 18/24 18/19

43

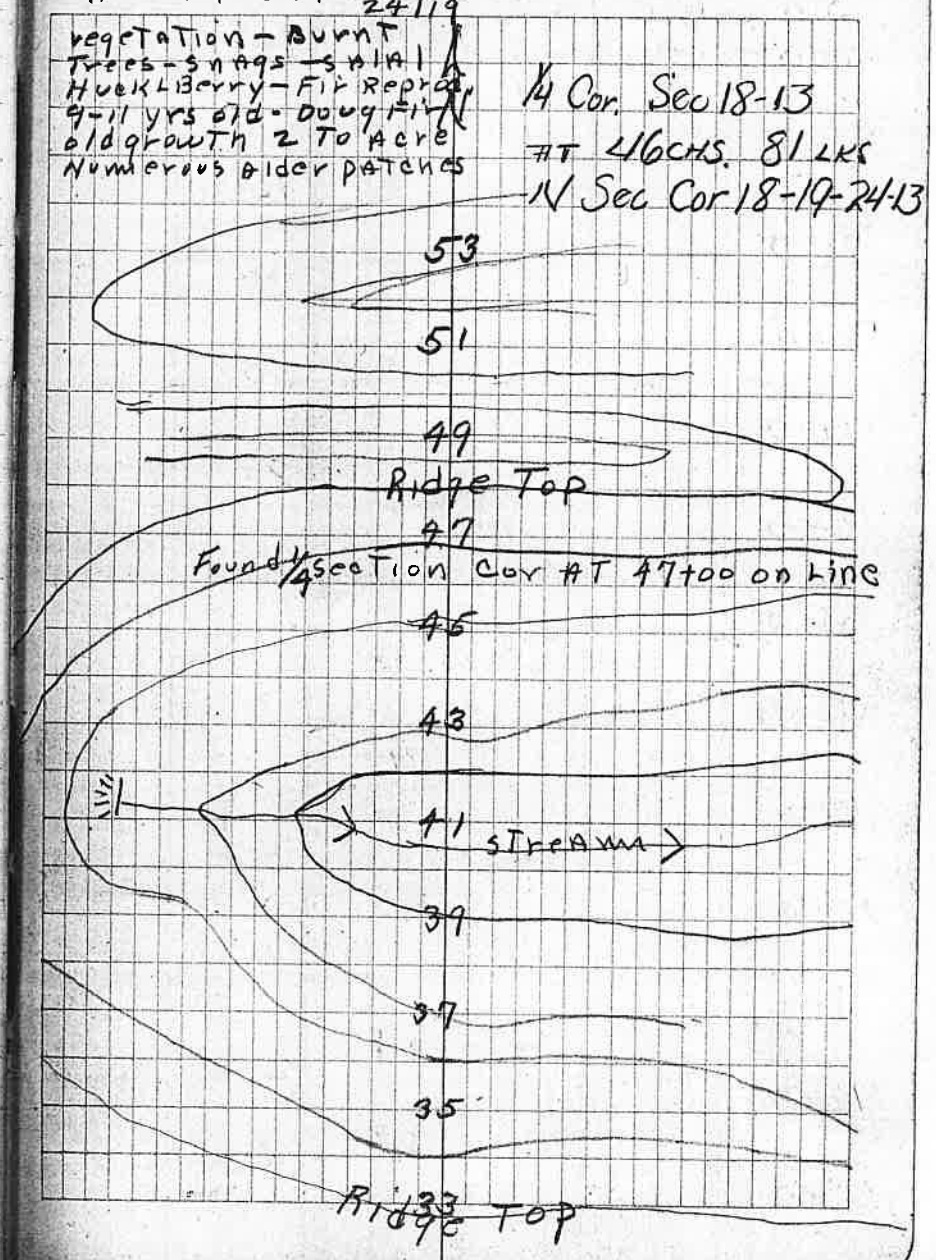

43

STA	Dir	Dist	Agney +	Agney −	
0+00	— (AT 1/4 Cor Sec 18-13) —				
	N	1	20		
1+00					
		1		10	
2+00					
		2		50	
4+00					
		1		30	
5+00					
		1		28	
6+00					
		2		48	
8+00					
		1	38		
9+00					
		1	11		
10+00					
		1		30	
11+00					
		2		11	
13+00					
		1	28		
14+00				(OFFSET 50 LKS W)	
		1	3-8		
15+00					

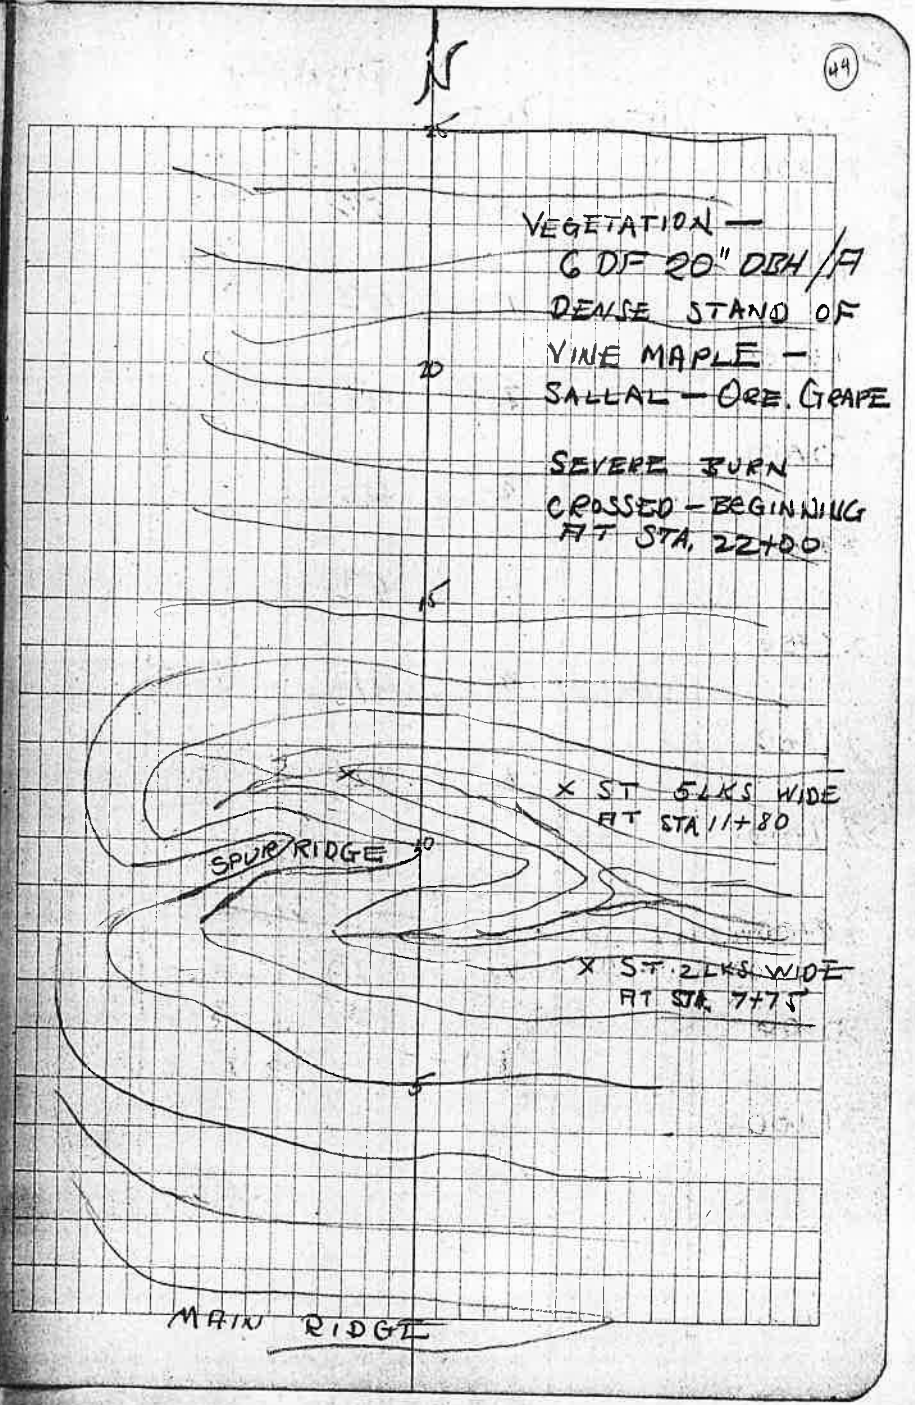

44

STA	DIR	DIST.	ABNEY +	ABNEY −	
15+00					
	N	2	32		(OFFSET 50 LKS E.)
17+00					
		1	43		
18+00					
		2	48		
20+00					
		2	46		
22+00					
		1	43		
23+00					
		2	41		
25+00					
		2	34		
27+00					
		2	9		
29+00					
		1	10		
30+00					
		1		8	
31+00					

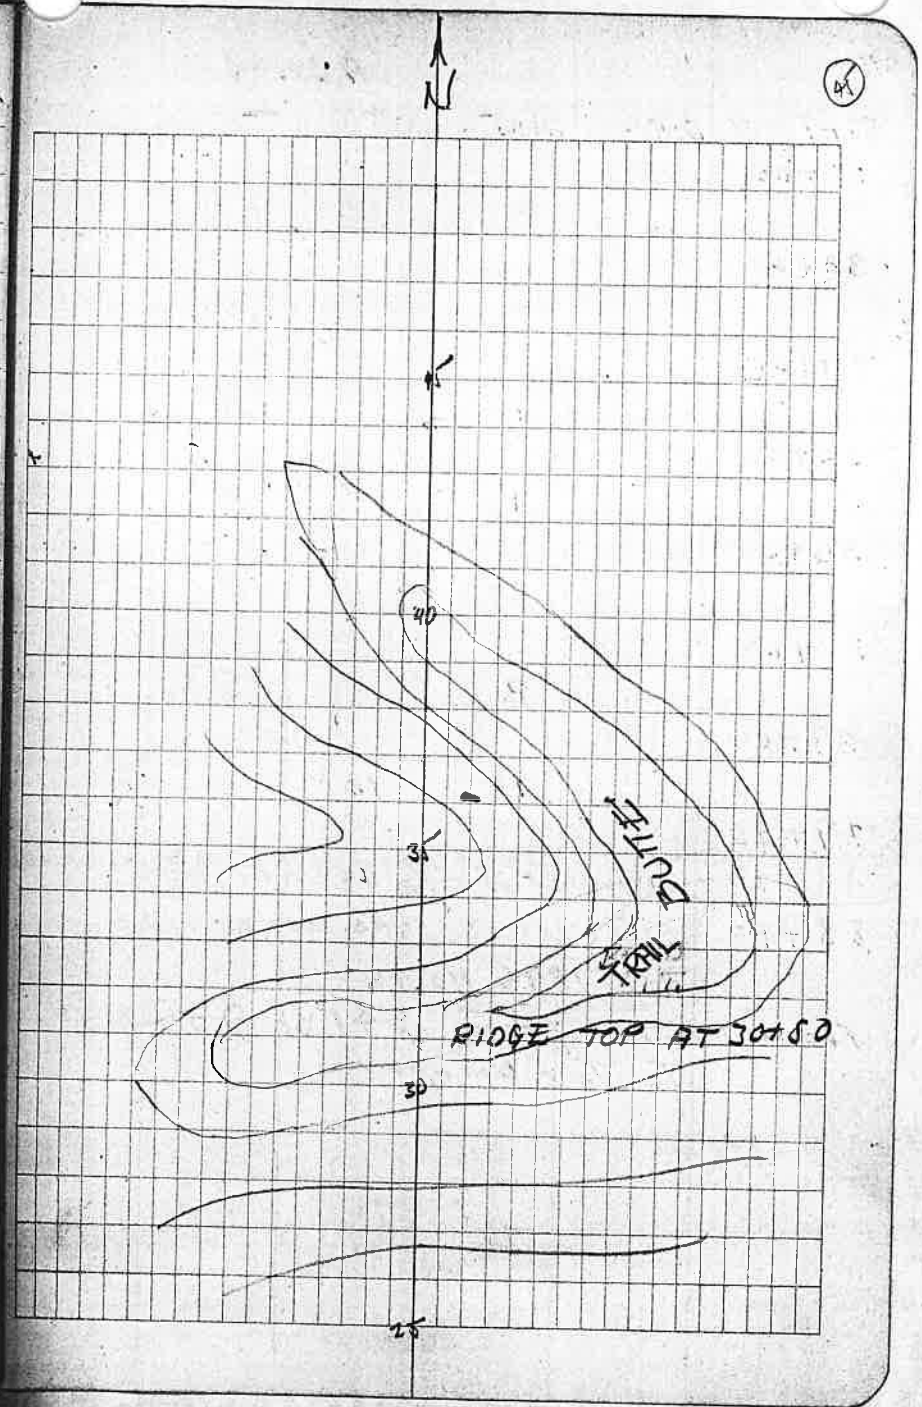

45

STATION	DIREC.	DIST.	ABNey +	ABNey −
31+00	N			
		2		9
33+00				
		1		28
34+00				
		1		24
35+00				
		1		9
36+00				
		1		1
37+00				
		2		5
39+00				
		.90	10	
39+90				
48+20	Distance To ¼ corner 13/18			
88+10	Distance To see corner as Per 1896 Notes			

From Ending point, S41°W 93 LKS
To True corner

Variation N21°E

Feb. 16, 1939
N From 13/18 24/19.
T. 24S R Line Bet R11+12W

Vegetation - Area of Repeated Burns, Burnt Trees, salal, Sloping West into 50 yr. old Fir Reprod - Line is Boundary between majority of old Burn and Reprod.

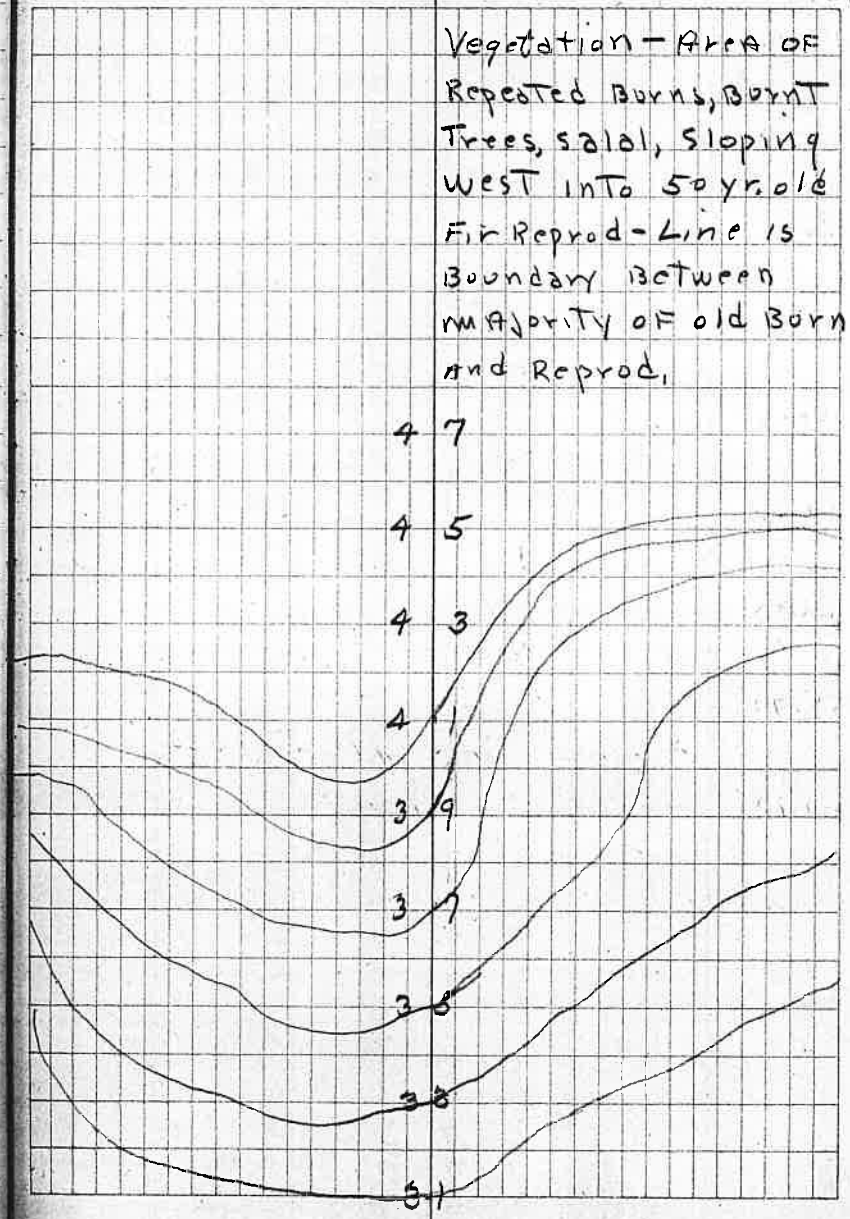

STA	BEAR	DIST	ASSAFEY		
43+00			T		
		2	19		
46+00					
		1	47		
46+00					
		1	43		
47+00					
		2	8		
49+00					
		1'	12		
49+50					
		1	0		
50+50					
		1\20		38	
51+70					
	TIED	INTO	1/4 Cor	N33°E	
			1 CH.		

47

STA	BEAR	DIST	ABNEY +	ABNEY −
		(BEGINNING AT CC Sec 17-18)		
0+00				
		1	48	
1+00				
		1	53	
2+00				
		1	47	
3+00				
		2	57	
5+00				
		1	55	
6+00				
		2		38
8+00				
		2		22
10-00				
		2		7
12+00				
		2	3	
14+00				
		2	12	
16+00				
		2 1/2		
18+50	(ESTABLISHED 1/16 CORNER)			
	DISTANCE FROM	Sec Cor 18-19-13-24 TO 1/4 C		
		57 CHS 70 LKS		
	"	" CC Sec 17-18 TO 1/4 Cor		
		37 CHS 60 LKS		

48

TOPOGRAPHY & VEGETATION IN BOOK #3

5170
2000
3170

Sta.	Dist	Abney +	Abney −	Bear
0				
	2		13	
2				
	1		10	
3				
	1		13	
4				
	1		16	
5				
	2		19	
7				
	2		35	
9				
	1		36	
10				
	2		51	
12				
	2		43	
14				
	1		52	
15				
	2	6		
17				
	1	32		
18				

Line E from 1/4 Corner 13/18

3/4/39

Weather: Rain

Decl° 15°20'E

Kyle – Compass
Hamilton – Ht. Chg. Notes
Simpson – Rr. Chain
DeGroote – Axe
Taylor – Axe.

At sta. 5 a stream 40 links is approx 8 chains to N. flowing SE.

At Sta. 9 the above mentioned stream is approx. 5 chains ¼ to N.

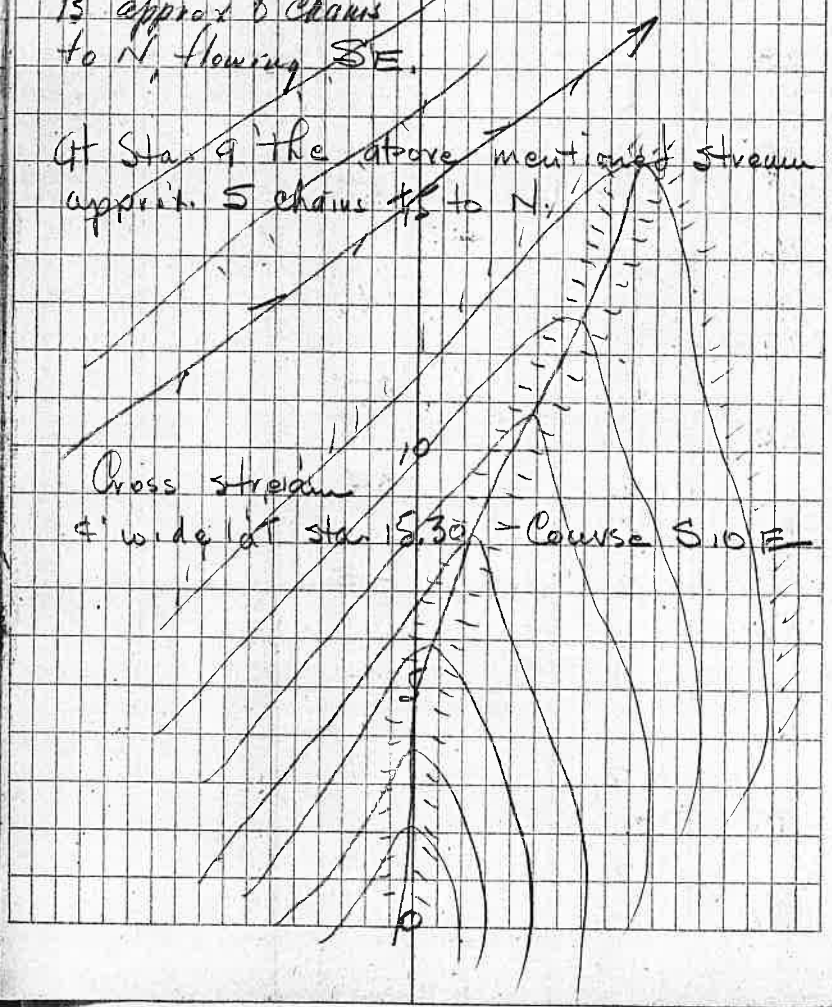

Cross stream 4' wide at Sta. 15.30 – Course S.10 E

Sta.	Dist	Aziml. +	Aziml. −	Bear.
18				
	2	31		
20				
	2	44		
22				
	1	20		
23				
	2		1	
25				
	1		5	
26				
	1		17	
27				
	1		35	
28				
	2		34	
30				
	2		−5	
32				
	1		4	
33				
	2		9	
35				
	2		10	
37				

Line E from 1/4 Sec. 13/18

(50)

3/2/39

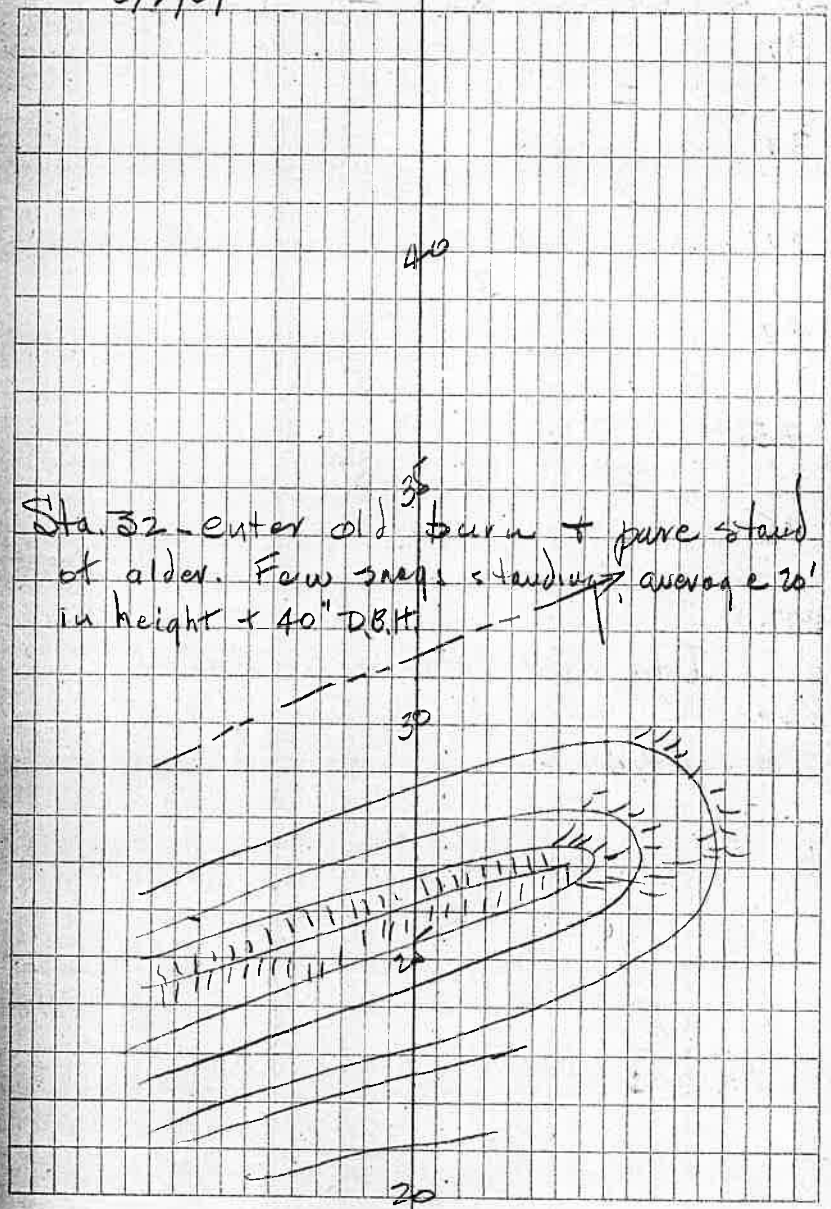

Sta. 32 - enter old burn + pure stand of alder. Few snags standing, average 20' in height + 40" D.B.H.

Sta	Dist	Abney +	Abney −	Bear
37				
	2		2	
39				
	2		10	
41				
	1	3		
42				
	1		15	
43				
	2		15	
45				
	.71	0		
45+71				

Sta. 45.71 intersects Random Line N from 1/4 Cor. Sec. 18/19 at Sta. 41.47.

Line E from 1/4 13/18

3/2/39

STA	BCA	DIST.	ABNEY		
45+71					
		2	0		
47+71					
		1	5		
48+71					
		2		3	
50+71					
		2		5	
52+71					
		1.29		4	
54+00					
		1		9	
55+00					
		.50		0	
55+50					
		1		30	
56+50					
		1		34	
57+50					
		2.50		28	
60+00					
		2		28	
62+00					
		2		19	
64+00					

EAST From HUB OF
Sec. 18 T24S R 11W (57)

Visibility - poor
March 3, 1939
Temperature 30°
Weather - Rain - snow - Hail Simpson - Hd Chain
Taylor - Axe
Conkle - Compass - Notes

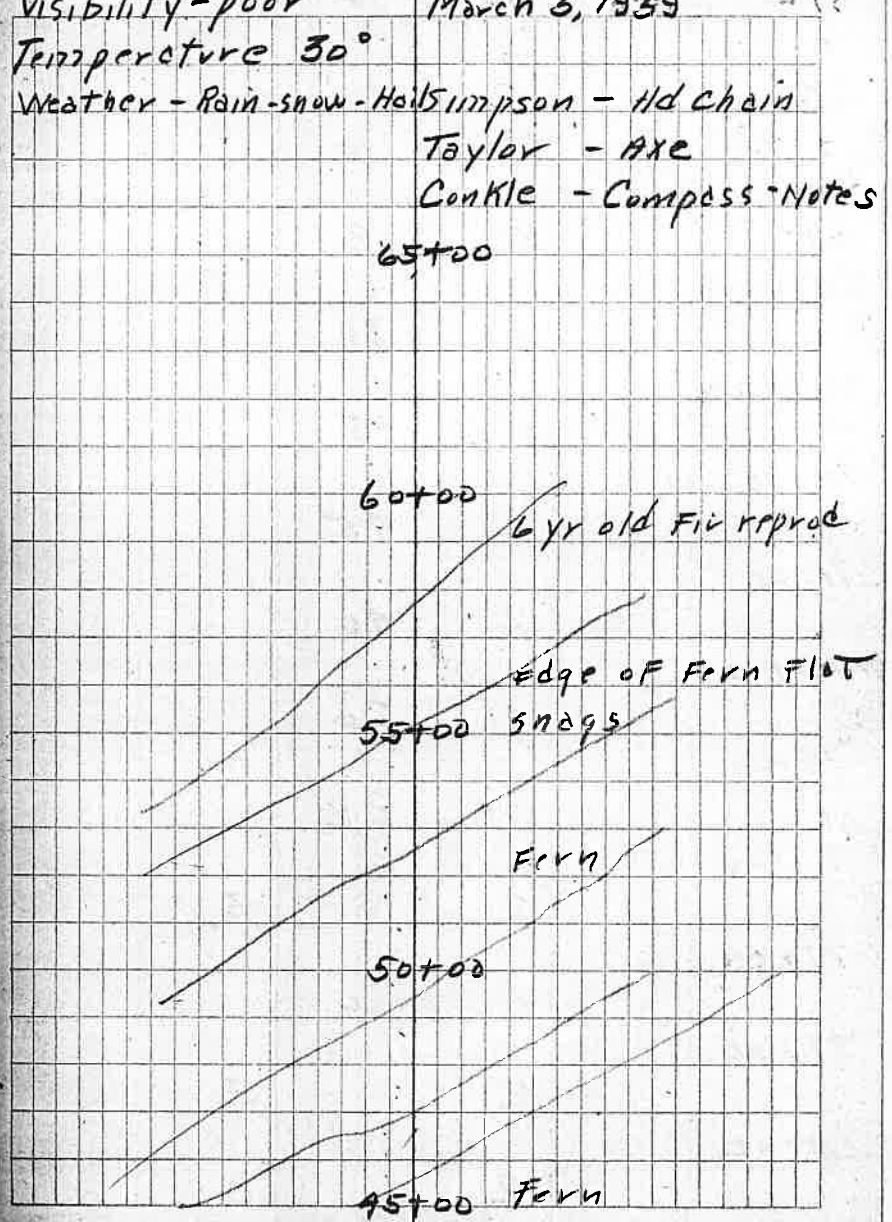

STA	Bed.	DIST.	ABNEV +	ABNEV −
		1.10	0	
65+10				
		1	0	
66+10				
		2	8	
68+10				
		1	31	
69+10				
		1	45	
70+10				
		1	45	
71+10				
		2	40	
73+10				
		1	20	
74+10				
		.90	28	
75+00				
		2		3
77+00				
		1	0	
78+00				
		2		3
80+00				
		2		6

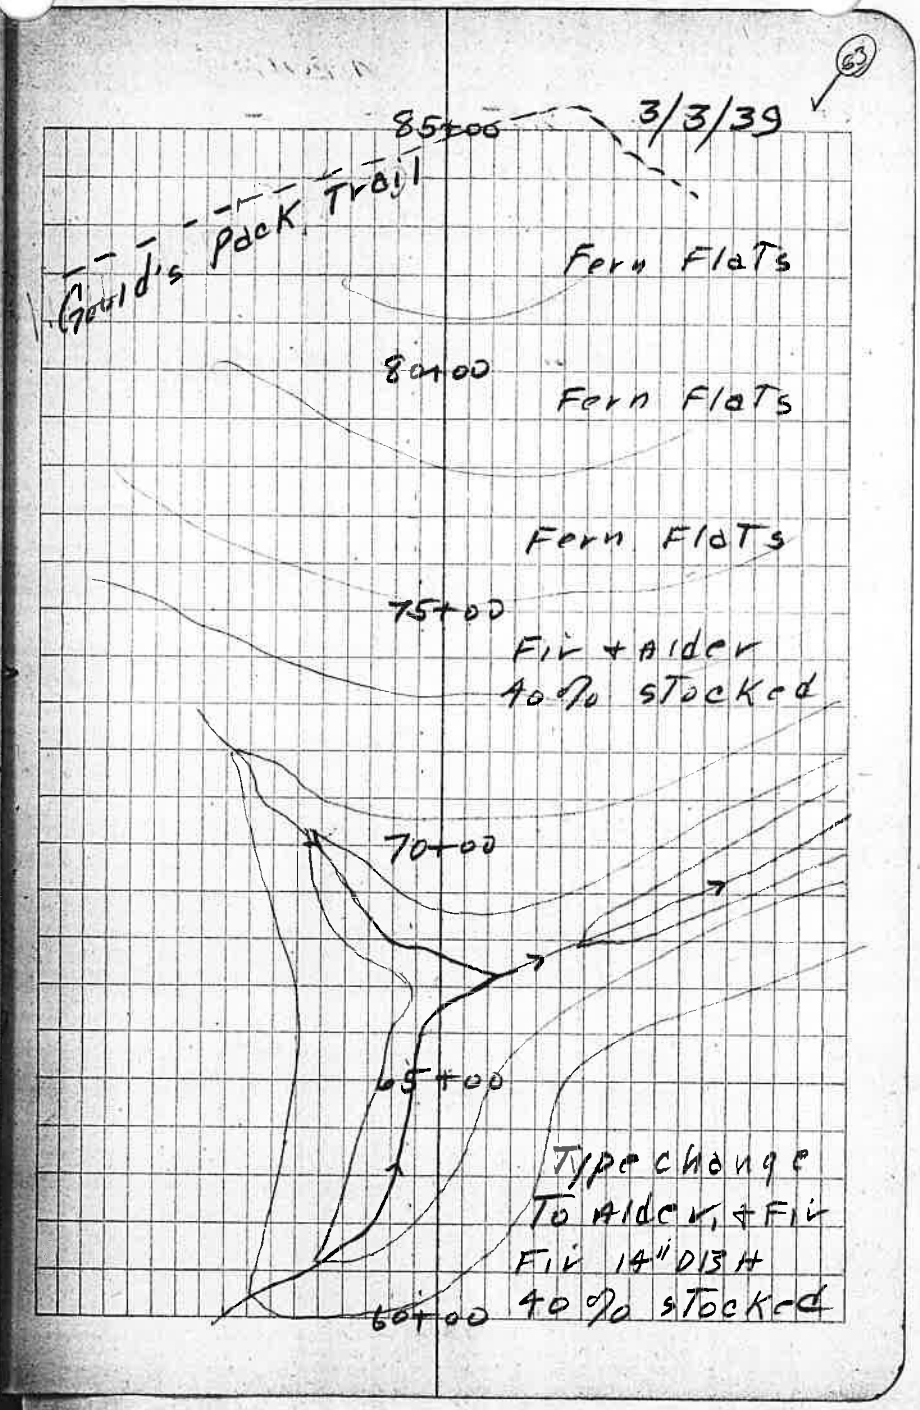

STA.	BEA.	DIST	A B NEV +	A B NEV −
82+00				
		2	12	
84+00				
		.27	0	
84+27	Tied into Tally 1W of ¼ 17-18			

(54)

3/13/39

STA.	BEA.	DIST.	ABNEY +	ABNEY −
0+00	N22°35'W - Beginning			18-19
		.77	11	
0+77				
		1		4
1+77				
		2		3
3+77				
		2		3
5+77				
		2.23	1	
8+00				
		2	0	
10+00				
		2	3	
12+00				
		2	10	
14+00				
		1		1
15+00				
		2	5	
17+00				
		1	3	
18+00				
		2		4
20+00				

Declination From True North - N22°35'W
N. From 1/4 18-19
T24S R 11W

Monday - March 6, 1939
Nec Tber - Snow
Kyle - Compass
DeGroote - Axe
Taylor - Axe
Hamilton - Hd. Chain
Conkle - Rr. Ch. + notes

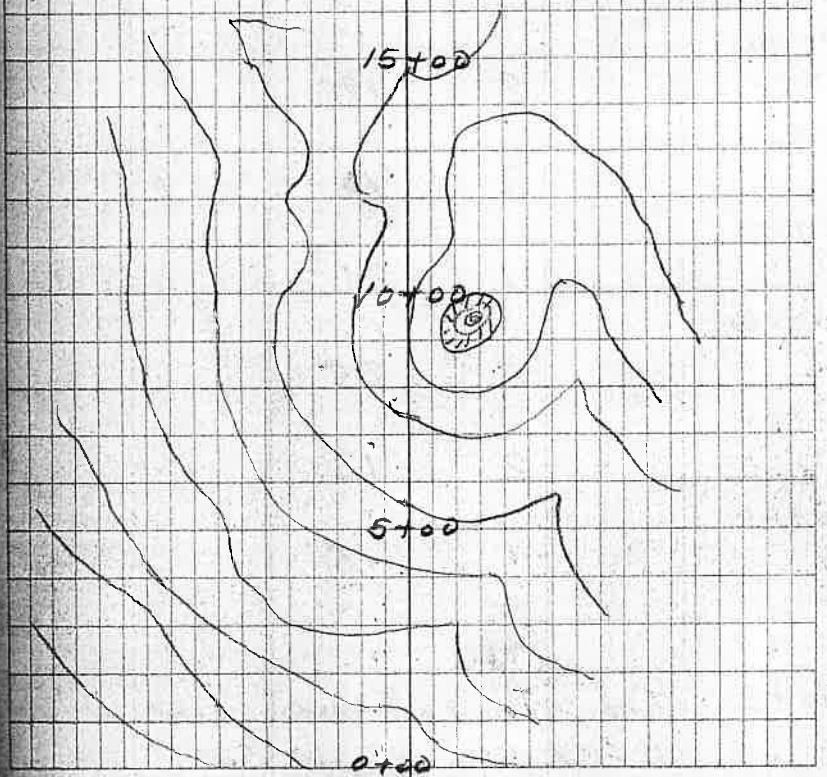

Cont. 3/6/39

Sta.	Bea	Dist	Abner +	Abner −
22+00				
		1		5
23+00				
		2		0
25+00				
		2	12	
27+00				
		1	19	
28+00				
		2	20	
30+00				
		2	14	
32+00				
		2	10	
34+00				
		1	21	
35+00				
		2	25	
37+00				
		2	13	
39+00				
		1	16	
40+00				
		42		
40+42	Tied in To East-west Line 19 Lks. West of Sta. 50+71 on E-W Line			

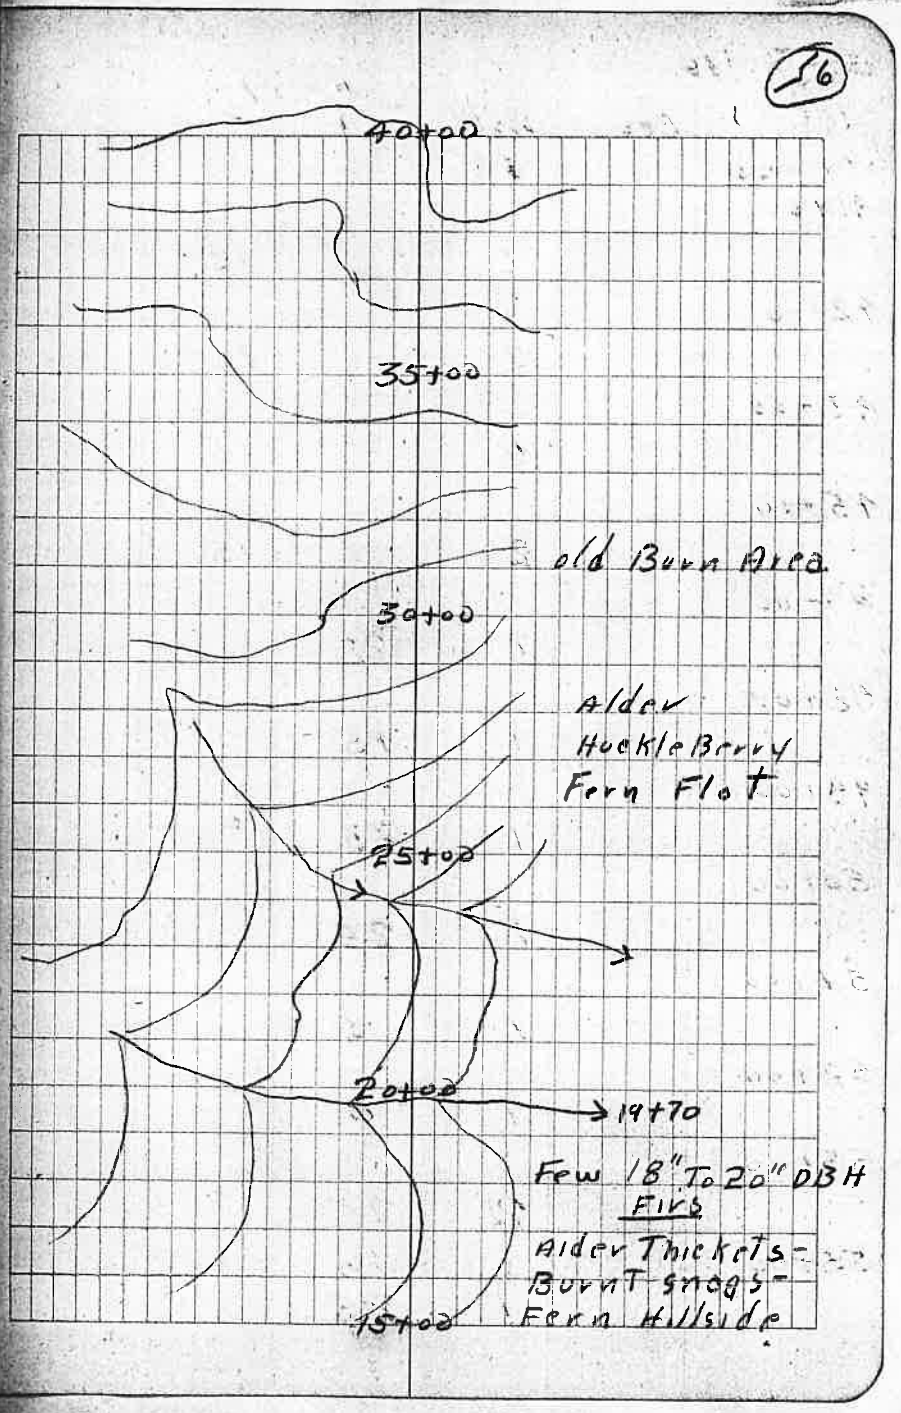

Cont 3/6/39

STA.	Bea.	DIST.	ABney +	ABney −
41+00		58	0	
42+00		1		15
43+00		1		20
45+00		2		30
47+00		2		15
48+00		1	28	
49+00		1	45	
50+00		1	33	
51+00		1	26	
52+00		1	0	
53+00		1	0	
55+00		2	25	
		1	25	

(1)

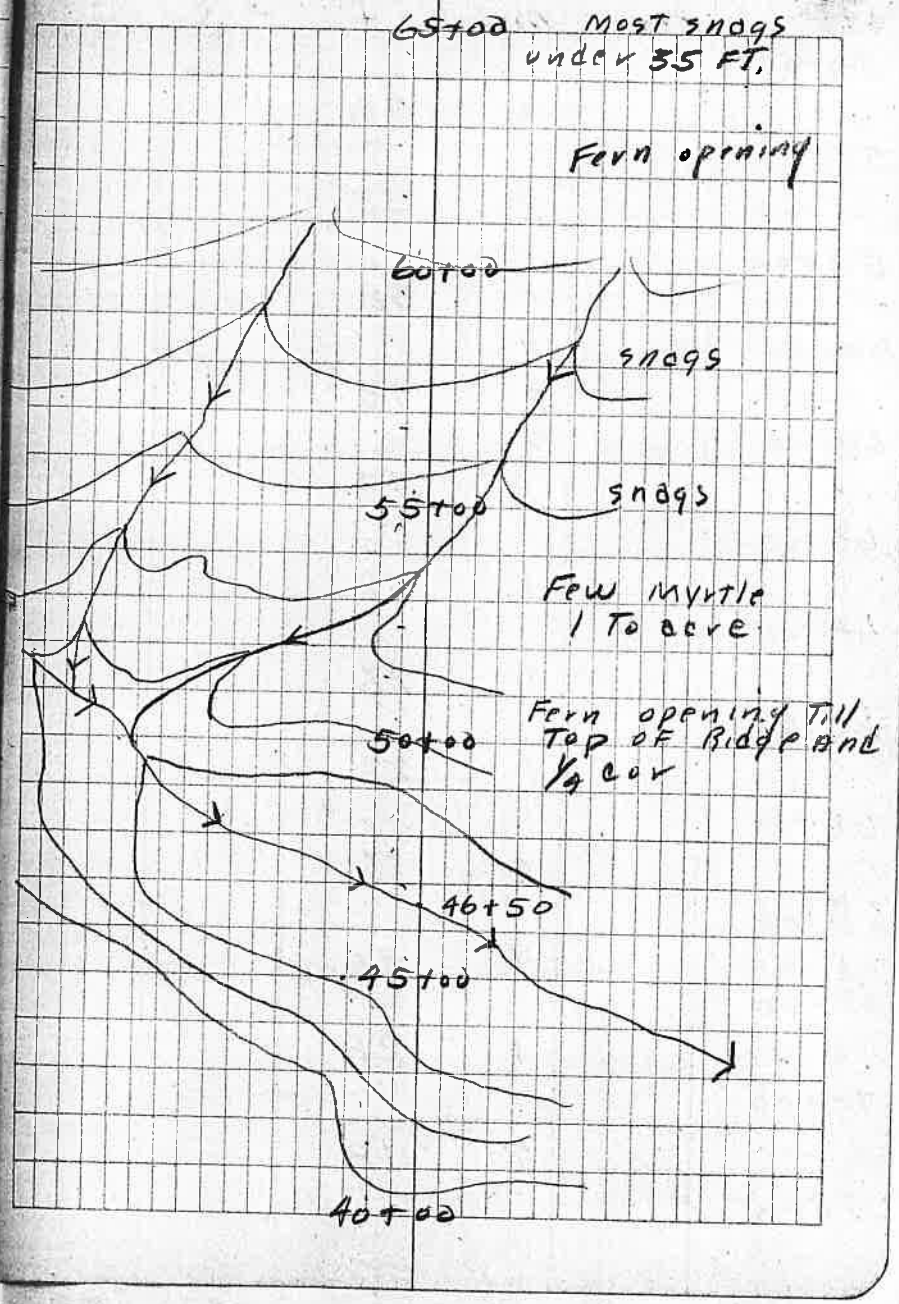

Cont 3/6/39

Sta	Bea	Dist	Alg Inv +	Alg Inv −
56+00				
		1	52	
57+00				
		2	33	
59+00				
		1	38	
60+00				
		2	48	
62+00				
		1	43	
63+00				
		1	38	
64+00				
		1	23	
65+00				
		1	23	
66+00				
		2	13	
68+00				
		1	46	
69+00				
		1	28	
70+00				
		2	18	
72+00				

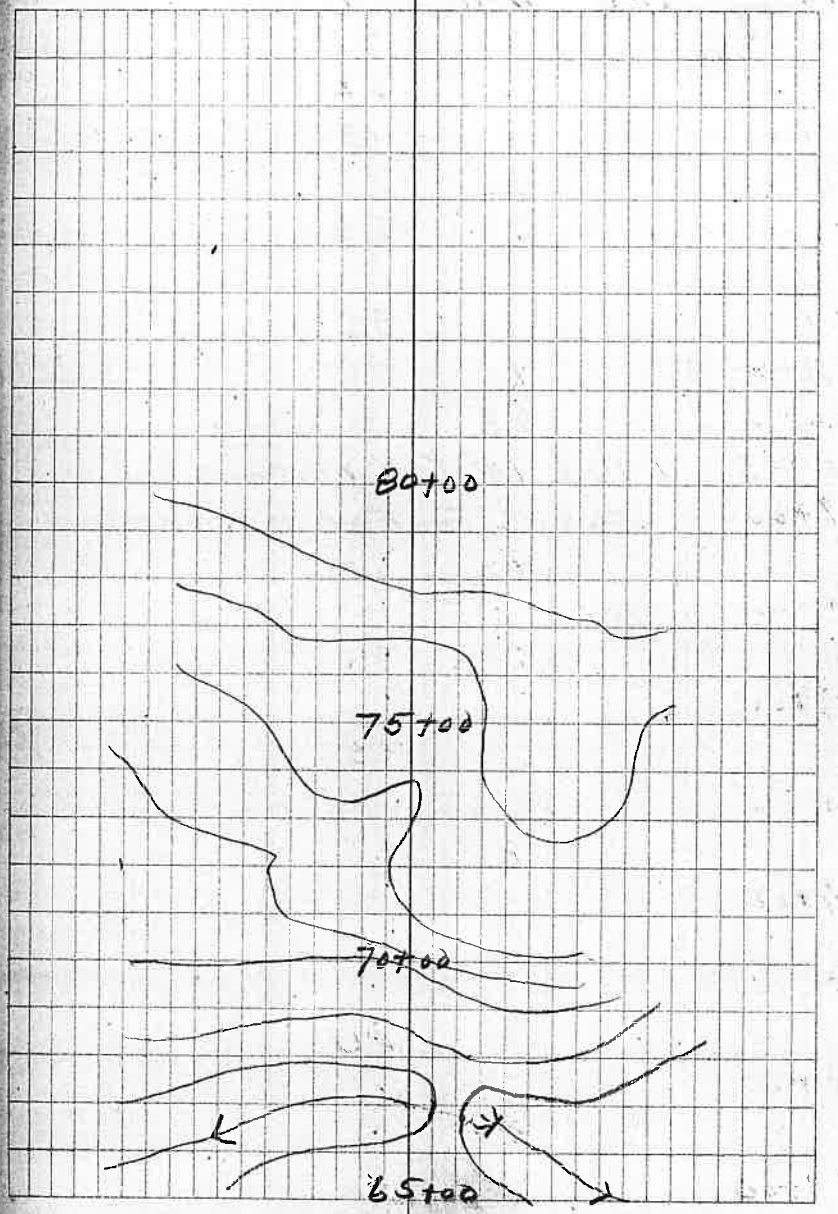

Cont 3/6/39

Sta	Bea	Dist	Adney +	Adney −
		1	25	
73+00				
		2	13	
75+00				
		2	26	
77+00				
		1	35	
78+00				
		23	0	
78+23	Tied In For Distance			
	36 LKS Too Far W in Direction			
	Hag			

STA	BEA	DIST	ABNEY +	ABNEY −
0+00	N18°52'W			
		2	23	
2+00				
		2		1
4+00				
		1		10
5+00				
		1		7
6+00				
		1		38
7+00				
		2		48
9+00				
		2	10	
11+00				
		2	64	
13+00				
		1	37	
14+00				
		1	0	
15+00				
		1	26	
16+00				
		228		5
18+28				

Start

18

60

N82°52'W - Bear. Tuesday morn 7, 1939
+ 21° - declination - weather - Cloudy, cold
From 1/16 on center Compass - Kyle
Line of sec 18 South Axe - Hamilton
of 1/4 7/18 Axe - Taylor
Axe - De Groote
Hd. Ch. - Simpson
Rr. Ch. + Notes - Conkle

1/16 on center Line south of 1/4 7-18
59+45 - Location calculated
Move 9 LKS W

Hub of section 18 - N + S
4+42 surveyed
Move 25 LKS N - calculated
Move 6 LKS W - " "
Hub 50+96 Running East + West

STA	Brg	Dist	Abney +	Abney −
20+28		2	51	
24+28		2	50	
25+00		.72	0	
27+00		2		15
29+00		2	50	
30+00		1	0	
31+00		1		14
33+00		2		25
35+00		2		27
37+00		2		24
39+00		2		61
40+00		1		28
		2 16		19

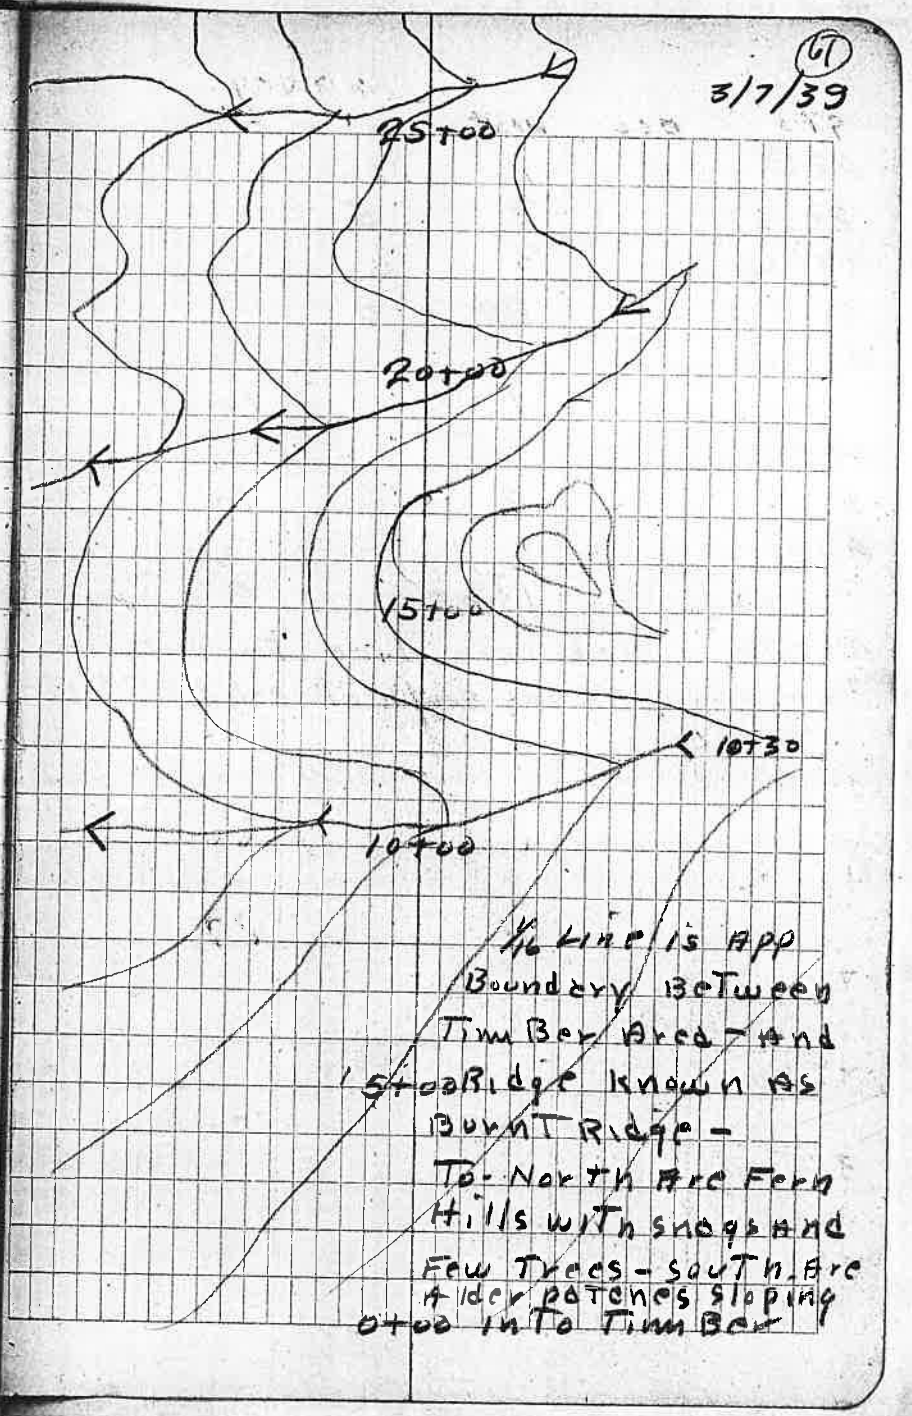

42 16					
		2	5		
44+16					
		84	0		
45+00					
		1		10	
46+00					
		2		10	
48+00					
		1 76		2	
49+76	Tie & into Line for distance .485 lks south of calculated 1/16				

3/7/39

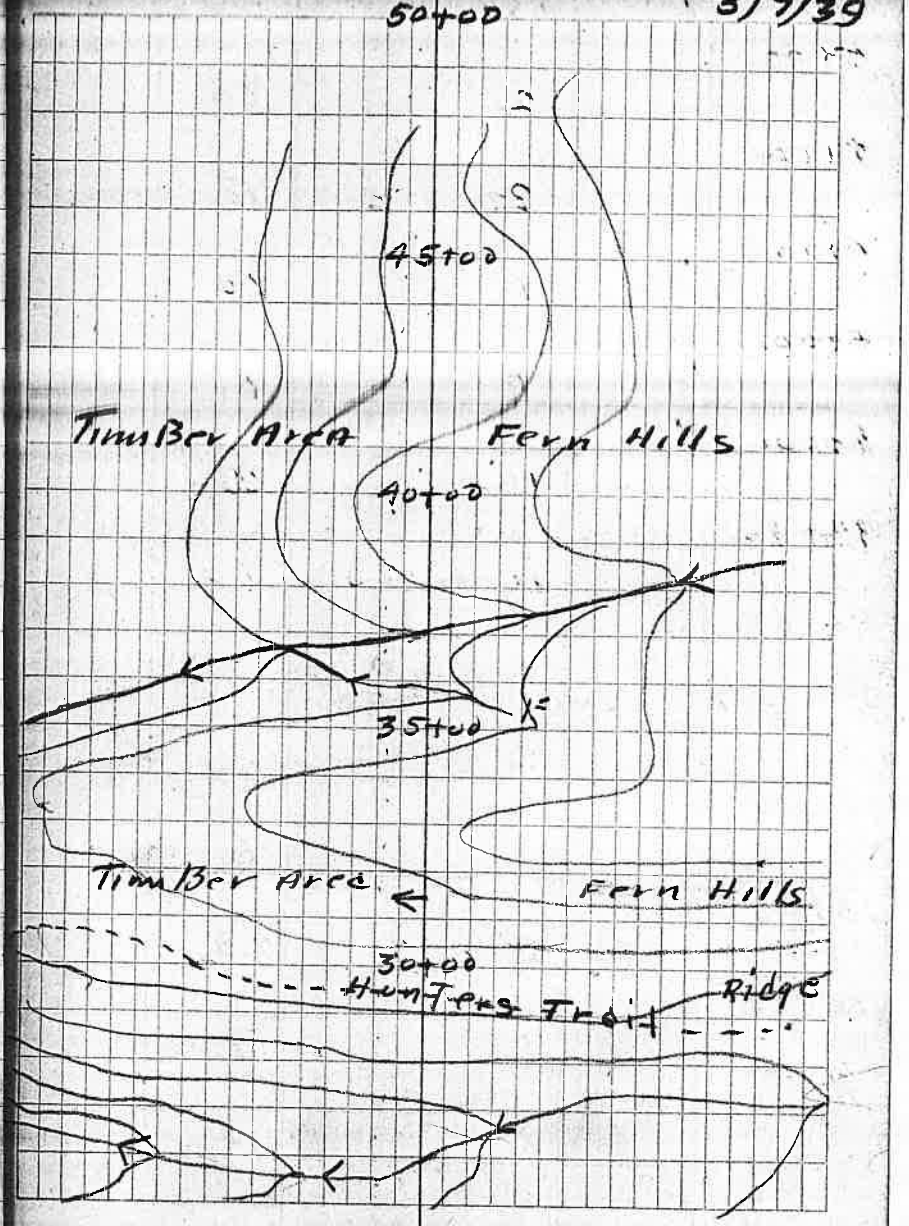

STA.	Dec.	DIST	ABNEY +	ABNEY −
0+00				
		2		30
2+00				
		2		18
4+00				
		1		20
5+00				
		1		0
6+00				
		2		28
8+00				
		1	49	
9+00				
		1	0	
10+00				
		2		
12+00				
		1		6
13+00				
		2		20
15+00				
		1		12
16+00				
		1		14
17+00				

63

Declination - 21°

Calculated dec. From Bearing - S 22° 35' W

Line - South From Center of NW¼ - 18

MARCH 8, 1939

Visibility - Fair

Hamilton - Compass
Kyle - Hd Chain
DeGroote - Axe
Simpson - Axe
Taylor - Axe
Conkle - Rr. ch. + Notes

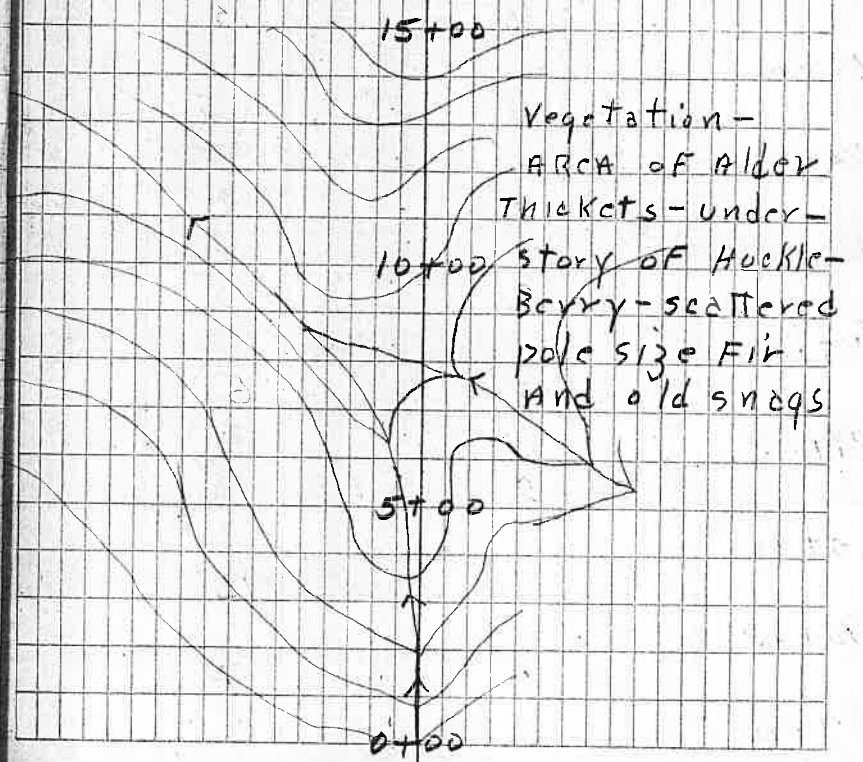

Vegetation - Area of Alder Thickets - under-story of Huckle-Berry - scattered pole size Fir and old snags

STA	Deg	Dist	ABNEY +	ABNEY −
		1	3	
18+00				
		30	0	
18+30	offset 20 LKS. To The East			
		1	10	
19+30				
		.70	0	
20+00				
		1		14
21+00				
		1		15
22+00				
		1		14
23+00				
		2		10
25+00				
		2		6
27+00				
		2	1	
29+00				
		1		15
30+00				
		2		7
32+00				

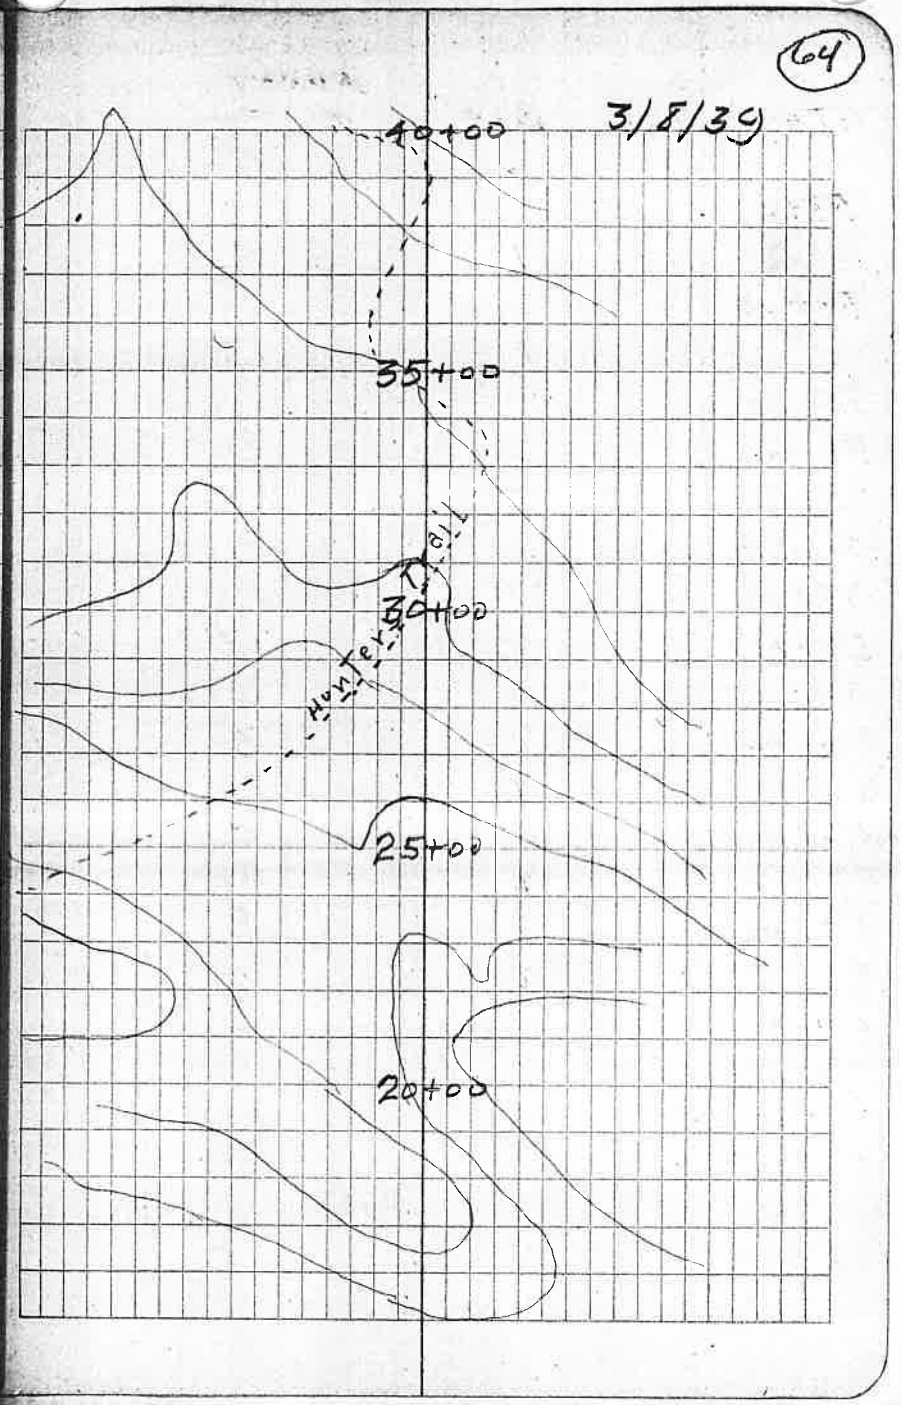

Sta.	Occ.	Dist	Abney +	Abney −
		1		2
33+00				
		1		6
34+00				
		1		13
35+00				
		1		8
36+00				
		1		8
37+00				
		2		13
39+00				
		2		3
41+00				
		2		9
43+00				
		2		8
45+00				
		1		5
46+00				
		1		0
47+00				
		1	44	
48+00				
		1	37	

(65)

3/8/39

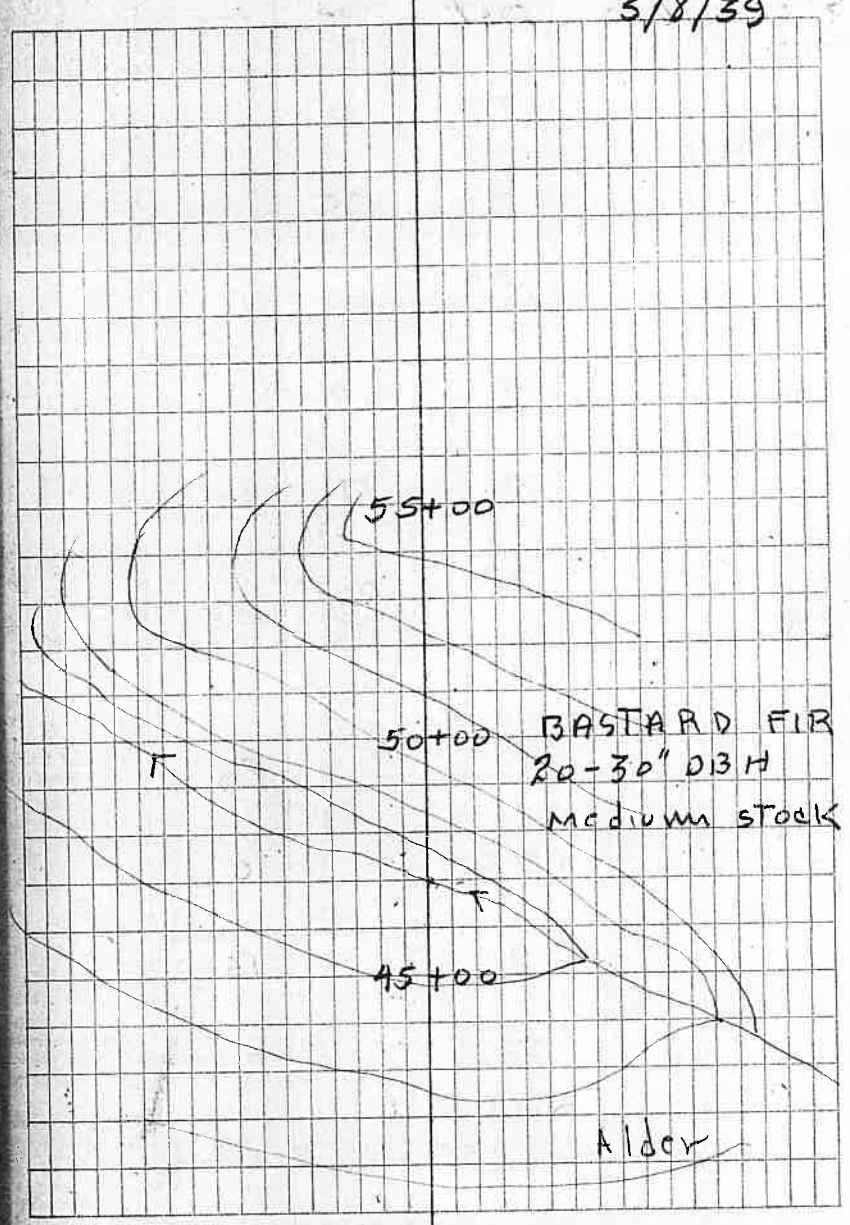

3/8/39

Sta	Dec.	Dist	ABNCY +	ABNCY −
49+00				
		.38	0	
49+38				
		2	35	
51+38				
		1 29	0	
52+67				
		2	17	
54+67				
		2	17	
56+67				
		.33	0	
57+00				
		1		11
58+00				
		1		25
59+00				
		.78		0
59+78				
		2		13
61+78				
		70		0
62+48	To	E+W line		
	Direction - 35 LKS. E. OF 1/16			

STA	DEC	DIST	ABNEY +	ABNEY −
0+00				
		.54	0	
0+54				
		1		23
1+54				
		.68		0
2+22				
		1		26
3+22				
		2		17
5+22				
		37		0
5+59				
		41		0
6+00				
		18		0
6+18				
		2		9
8+18				
		37		0
8+55				
		2		41
10+55				
		2		20
12+55				

Declination -21° E
Calculated declination
From Bearing -21°45'

Line - North From
18+80 on South side
of 18

MARCH 9, 1939

KYLE - Compass
HAMILTON - Hd. chain
DeGroote - Axe
Conkle - Br. ch. + Notes

Taylor - Posting
Simpson - Posting

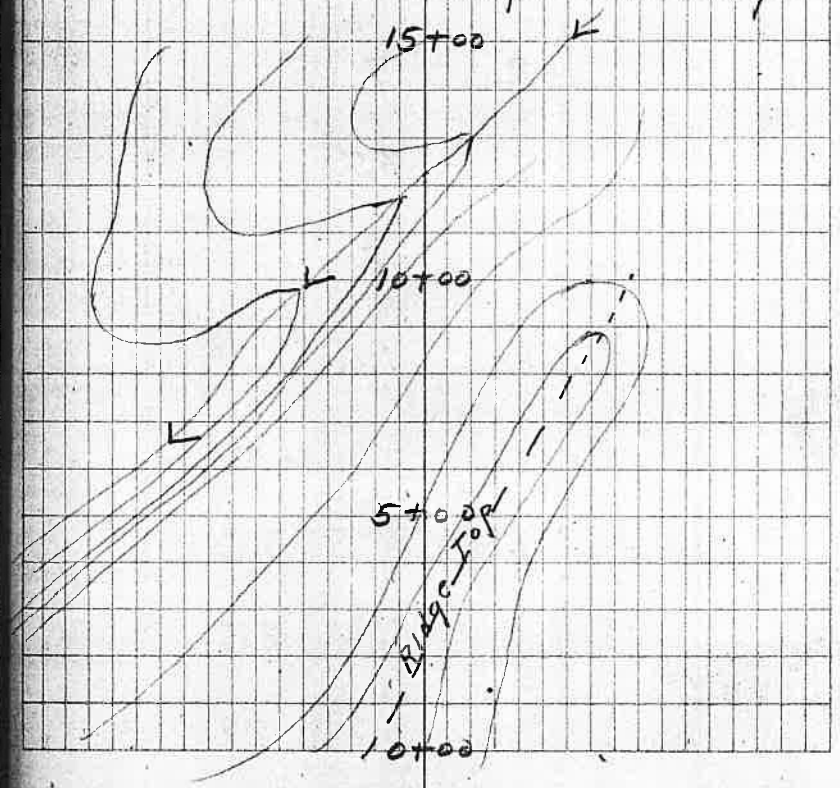

STA	DEC.	DIST	ABNEY +	ABNEY −
14+55		2	5	
15+26		.71	0	
17+26		2	6	
18+26		1	8	
19+00		.74	0	
21+00		2	7	
22+00		1	35	
23+00		1	3	
24+00		1	10	
25+00		1		6
26+00		1		28
27+00		1		23
		2		21

3/9/39

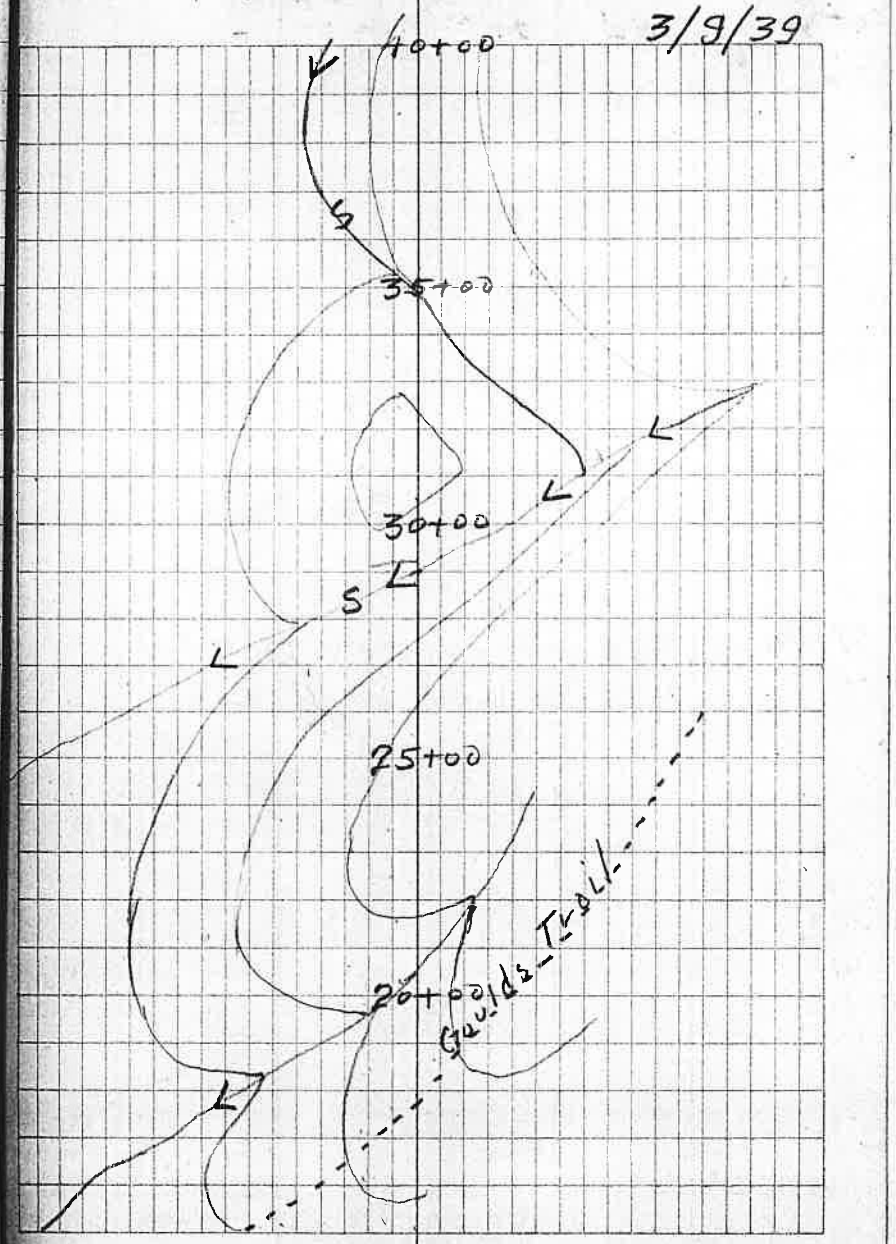

3/9/39

sta	dec	Dist	Abney +	Abney −
29+00				
		1		13
30+00				
		2		7
32+00				
		2		0
34+00				
		2	11	
36+00				
		1	26	
37+00				
		.70	0	
37+70	Tied in on E+W line 1+22 CH. West of 1/16 Cor.			

STA	BEA	DIST	ITB +	NEY −
0+00				
		1		0
1+00				
		1		2
2+00				
		1	22	
3+00				
		1	35	
4+00				
		1	0	
5+00				
		1		31
6+00				
		1		26
7+00				
		1		27
8+00				
		1		29
9+00				
		1		34
10+00				
		2		45
12+00				
		2		11
14+00				

Bearing - North

Declination - 21°

Random Line.

West From 8|9 / 17|16

MARCH 10 1939

Weather - Cloudy

Simpson - Compass

Kyle - Hd chain

Taylor + Axe

Hamilton - Axe

Conkle - Rec. Ch. + Notes

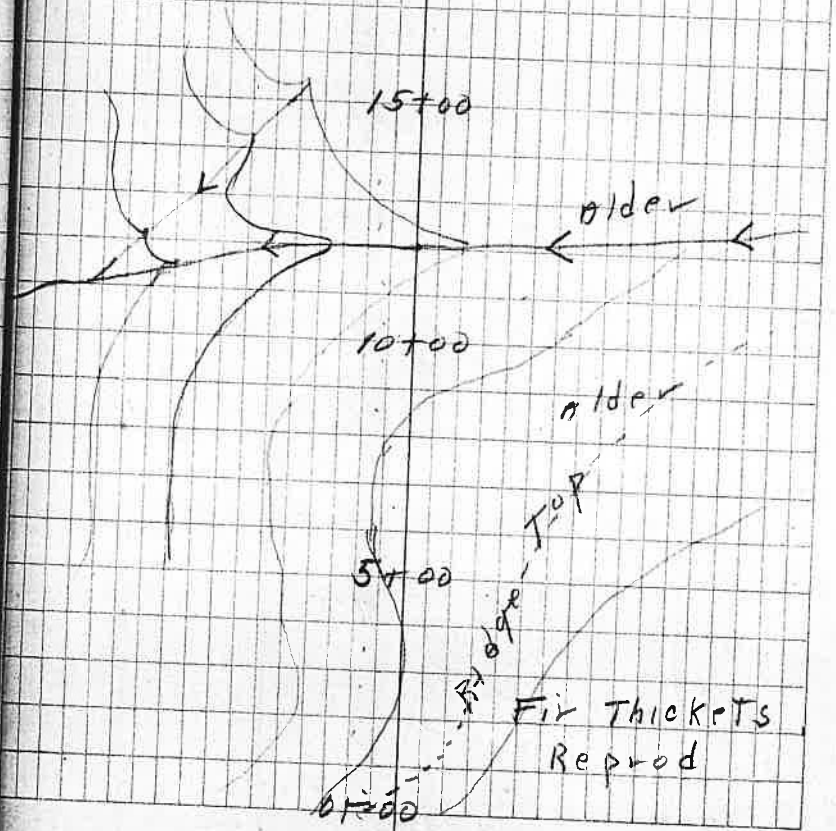

Sta	Bcc	Dist	Abney +	Abney −
15+00		1	30	
17+00		2	30	
19+00		2	11	
20+00		1	25	
21+00		1	48	
22+00		1	45	
24+00		2	25	
25+00		1	40	
26+00		1	46	
26+83		.83	0	
28+83		2	42	
30+83		2	50	
		2	49	

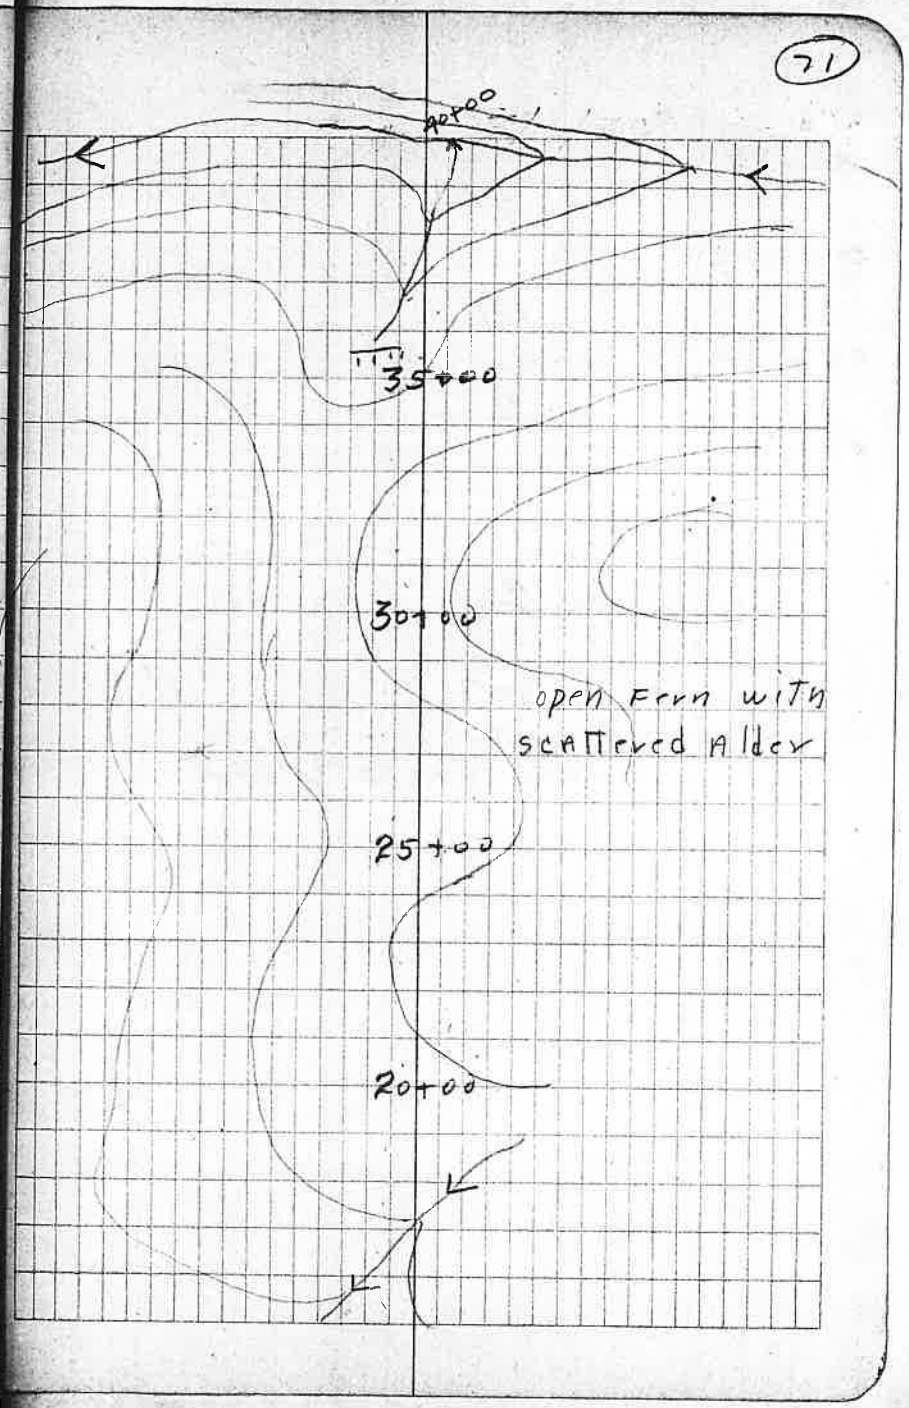

3/10/39

Sta	Brg	Dist	Abney +	Abney −
32+83				
		2		45
34+83				
		117		0
35+00				
		2		31
37+00				
		1		27
38+00				
		2		
40+00				
		107		
40+07	Tied into N+S Line 18 LKS TO N OF 1/4 Cor			