Survey No. 14 Made for. Daniel Lenig

Metson-Dygert Book Mfg. Co., Portland, Or.

Sept 2D 1893
T.27 S. R.6 W.
28 By Eppstein

Beginning at Rock Set in County Road 12×7×5 in
Bears 18½ E.
Thence N 88¾ W. 8.83 ch to Rock 12×10×5 in Set in co Road
Thence South 25.27 ch to post marked C. S.
Thence West 0.89 ch to N. E. corner of Fred Burnell 1 acre tract
Thence West 2.84 ch to N. W. cor of Fred Burnell 1 acre tract
Thence S 15¼ W. 3.44 ch to a S. W. " " " " "
and South boundary of Cl No 49. T.27 S.R.6 W. 28 by Eppstein
Thence West at 2.00 ch Left bank of Lookingglass Creek
offset South 1.00 ch at 6.60 ch offset North 1.00 ch
regained true line on Right bank of Creek
at 36.54 ch to the S. W. cor of Cl No 49.
the original bearing tree destroyed. Made new cor
a Cedar 10 in dia bears N 27° E. 61 links marked Cl 49. C.S. BT
Thence North 36.17 ch to R 16×4×3 in corner set in County road
from which W Oak 8 in dia bears N 5½ E. 340 lks marked C.S. BT
Thence S 73¼ E. 23.71 ch to post marked C.S. in co road
Thence S 88¼ E. 18.48 ch to place of beginning Cont 124 59/100 acres.
See Plat Page 9.

W. L. Briggs
Co Surr

Survey No 15 Morris Webber

Sep 15th 1893
T.27 S. R.6 W.

Beginning at the S. W. cor of Cl No 37. T.27 S.R.6 W. W. M. on
E Brothers & Burt Hassell Sworn chainman The Original B.T.
near obliterated made new cor by setting post mar C.37.C.S.
from which a Myrtle 6 in dia bears South 1 link marked C 37 C.S. B.T.
Thence East 27.12 ch Set a Rock 12×8×6. marked post C.S. alongside
Thence North 12.40 ch to Rock 14×10×8. " " " "
Thence West 37.50 ch Set post marked C.S. on Right bank of South
Umpqua River - from which Myrtle 6 in dia bears East 10 lks marked C.S. B.T.
Thence S 35° E 15.14 ch to place of beginning Cont 39 01/100 acre

T.26.S.R.6 W.

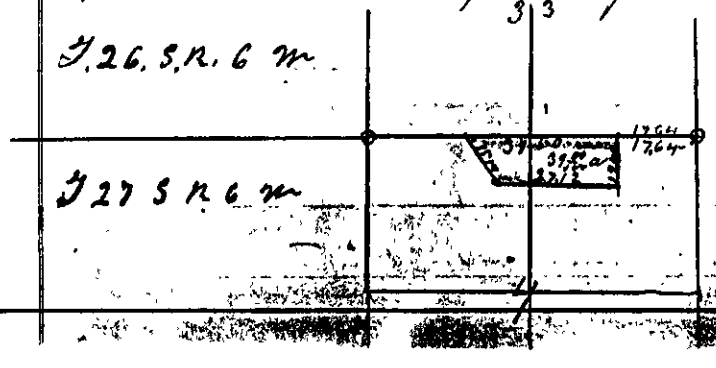

T.27 S R.6 W.

W. L. Briggs
Co. Surr

Not. Ord. F.B. 98 Page 46 & 47