

Survey No. 27

Made for John Hatfield

Dec 14 1893
T. 28 S. R. 5 W.


R. J. Rose & Crown Sworn Chainmen
 Beginning at 1/4 S. between Secs 21 & 22 T. 28 S. R. 5 W. 7th Mer
 Thence West 40.00 ch set post Var 19 1/2 E.
 Thence North 40.00 ch intersect at 1/4 S cor. bet Secs 16 & 21
 Thence N 89° 59' E. 28.10 ch set post marked C.S. from which
 Maple 12 in dia bears S 5° W. 70 lbs marked C.S. B.T.
 Thence S 29° E. 46.00 ch set post. marked C.S. from which
 Balm 20 in dia bears N 46° E. 38 lbs marked C.S. B.T.
 And Thence West 70.70 ch to place of beginning
 Cont 157.70 ac

W. H. Briggs
Co Sur

Dec 18 - 1893
T. 28 S. R. 7 W.

Survey N 28
 Made for John Mc Seure
 For the purpose of setting off the Widow dower interest
 in the Deceased Mc Seure deceased estate,
 P. Cooper, Charles Smith & Henry Sanders Surveyors
 Beginning at N. E. cor of land belonging to the estate
 at a post marked C.S. from which -
 W. Oak 24 in dia bears S 75° W. 230 lbs marked C.S. B.T.
 " " 4 " " " S 20 1/4 E. 67 " " C.S. B.T.
 Thence Var 20° E.
 Thence South 28.09 ch to post marked C.S. - from which
 W. Oak 6 in dia bears N 85° W 90 lbs marked C.S. B.T.
 Thence West 66.92 ch set post marked C.S. from which
 W. Oak 8 in dia bears N 27 1/2 E 250 lbs marked C.S. B.T.
 Thence North 28.09 ch. to the North boundary of land belonging
 to the estate. And Thence East 66.92 ch to the place
 of beginning Cont 157.22 acres Total acre of acre in the estate 357.22
 Since beginning point being 34.20 ch East of the N. W. cor
 of J. J. Mc Seure. Donation C. 2. No 52 T. 28 S. R. 7. W. Secs 33 & 34

T. 28 S. R. 7 W.

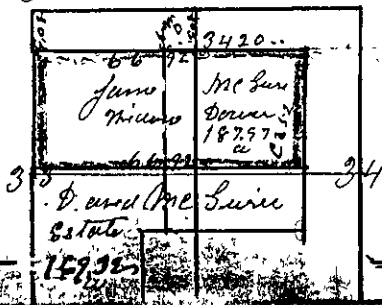

W. H. Briggs
Co Sur