

## County Surveyor's Record, Douglas County, Oregon

Survey No. *Phase*Made for *Douglas County*

T. 23 S. R. 6 W.

In The Matter of @ Leo" Road. Petitioned for by Albert Burns & 61 others From Yoncalla to Billy Creek Beginning at a point on the east line of Sec 2, Township 23 S R 6 W 100 feet north of the north bank of Billy Creek & close at the junction of @ Street on the south side of J P Devours Fruit Tract. near Yoncalla

Record of Survey can be had in clerks office

Survey made July 31

& Aug 1<sup>st</sup> & 2<sup>nd</sup> AD 1894

Will P. Heydon  
Co Surveyor

Township 23 S.

COMMENCE 60 CHAINS SURFACE MEAS  
SOUTH OF THE N.E. CORNER SEC NO 2 AND  
100 FT NORTH OF N BANK OF BILLEY CREEK 1/4

Range 6w

Range 5w

2

1



6

11

12

BILLEY CREEK

mud creek

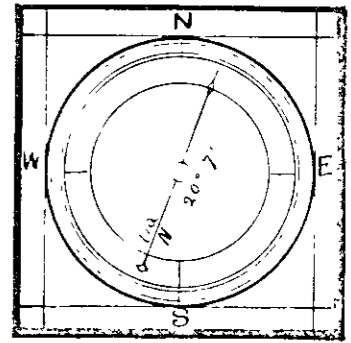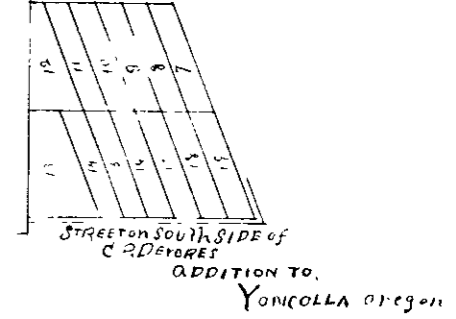

Map of County Road From  
BILLEY CREEK TO YONCOLLA SUBS

Scale 4 INCH ONE MILE SURVEYED BY WILL. P. HEYDON.

COUNTY SURVEYOR JULY 31 - AUG 1 - 2nd