County Surveyor's Record, Douglas County, Oregon

Survey No. 5

Made for H. Moodford & Ch. Aytch

Part of T 32 S R 5 W

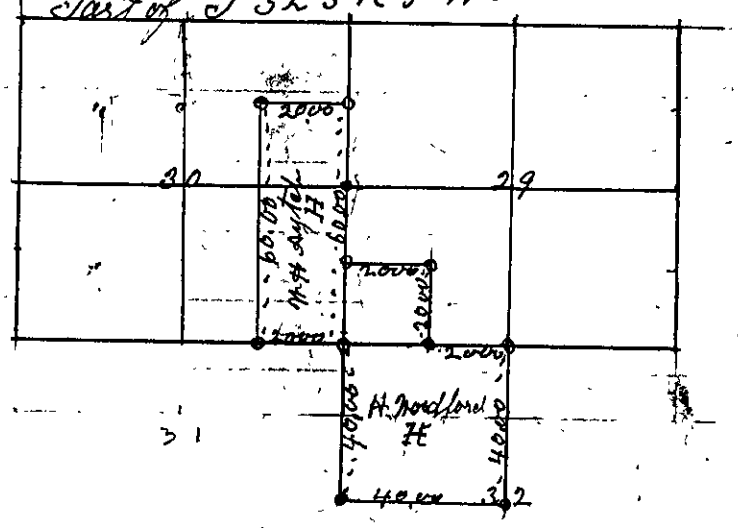

BY W. F. BRIGGS, Co. Surveyor July 26-28, 1900.

July 26-1900 Begin at the N. E. Cor of the W. M. Aytch H. Bar 19°30' E.
Thence South, at 20.00 ch set 1/4 S cor 29 & 30 the original B. T. has
been destroyed by fire made new bearing trees to wit:
Fir 8 in dia bears S 9° W 94 lks Fir 12 in dia bears S 74½ E. 86 lks
at 60.00 ch intersect at cor to sec 29, 30, 31 & 32.
Set post as per original B. T. standing to wit:
Fir 24 in. dia bears N 46° E. 25 lks. Dogwood 6 in S 67½ E. 41 lks
New W Fir 8 in dia S 80° W 22. lks Maple tree gone.
July 27- Thence South on unsurvey land 40.00 ch set post
marked 1/4 S. C.S. from which Laurel 8 in dia East 13 lks
Fir 10 in dia bears N 53° W 70 lks.
Thence East 22.50 Creek c N 40.00 ch set post
from which Fir 14 in dia bears S 73° E. 57 lks
Laurel 10 in dia bears S 58° W 63 lks
Thence North 40.00 ch set 1/4 S cor the original
B. T. has been destroyed by fire Mad new B. T. to wit
Laurel 5 in dia bears S 20° W 20 lks no other tree near
Thence West 20.00 ch set post from which
Black 10 in dia bears S 5° E. 50 lks.
July 28- Thence North 20.00 ch set post from which
Fir 14 in dia bears S 56½ W. 17 lks
Thence West 20.14 ch intersect 19 lks South
of temporary post set in pile from which
Pine 10 in dia bears S 59½ E. 373 lks
Thence Cor to 29, 30, 31 & 32. I run West 20.00 ch set post from which
Fir 18 in dia bears N 38½ E. 58 lks. Thence North 60.00 ch set
post from which Fir 10 in dia bears N 73° W 6 lks. & Fir 14 in S 45
Thence East 20.00 [illegible] of beg.