County Surveyor's Record, Douglas County, Oregon

Survey No. .....

Made for Frank Rose

T. 28 and 29 S
R. 6 W.

Chainmen John Howard and Adams
Surveyed May 8th. 1903 (Var. 20°E)

Begin at the East 1/4 cor. of sec. 35 in T. 28 S R 6 W the West 1/4 cor. of this sec. which is visible from this cor. bears S. 89°56' W. I ran for same. At 79.80 chs. intersect at West 1/4 cor. of sec. 35. Thence I run N 89°56 E at 19.95 chs. set a post marked C S from which a black oak 26 ins. diam bears N. 29° W 126 lks. dist. marked C S B T. Thence South at 40.00 chs. intersect Tp. line 20.00 chs. West of S. 1/4 cor. of sec. 35. The SW. cor. of sec. 35 is in South Umpqua River and all bearing trees have disappeared. At point of intersection I set a post marked C S and buried a brick, no trees near.

Thence I run South on a random line at 20 chs. set temp. cor. Thence West 20.00 chs. set temp. cor. Thence South at 20.00 chs. intersect at 1/4 sec. bet. secs 2 and 3 T. 29 S., R 6 W. The distance from this cor. North to cor. in river is reported in government field-notes to be 40.70 chs. I ran North on a true line bt 2 and 3, at 19.65 chs. set post marked C S from which a white oak 10 ins diam. bears S 10° W. 4.81 chs. dist., marked C S B J Thence East 20.00 chs. set a post marked C S from which a black oak 28 ins diam. bears S. 45° E. 166 lks. marked C S B J. A white oak 12 ins diam bears S. 72½° W. 5.23 chs. marked C S B J.

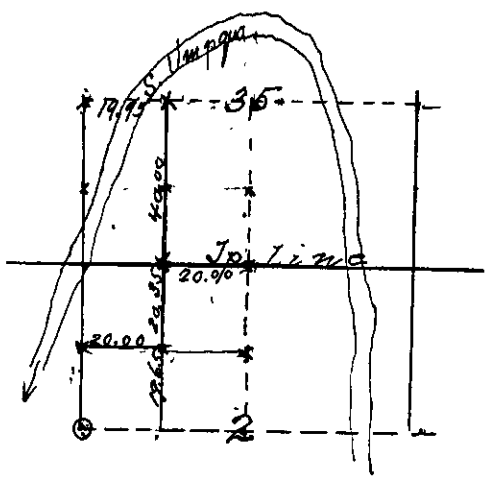

C. E. Roberts