County Surveyor's Record, Douglas County, Oregon Aug. 25 — Sept 3 '08

Survey No. .....
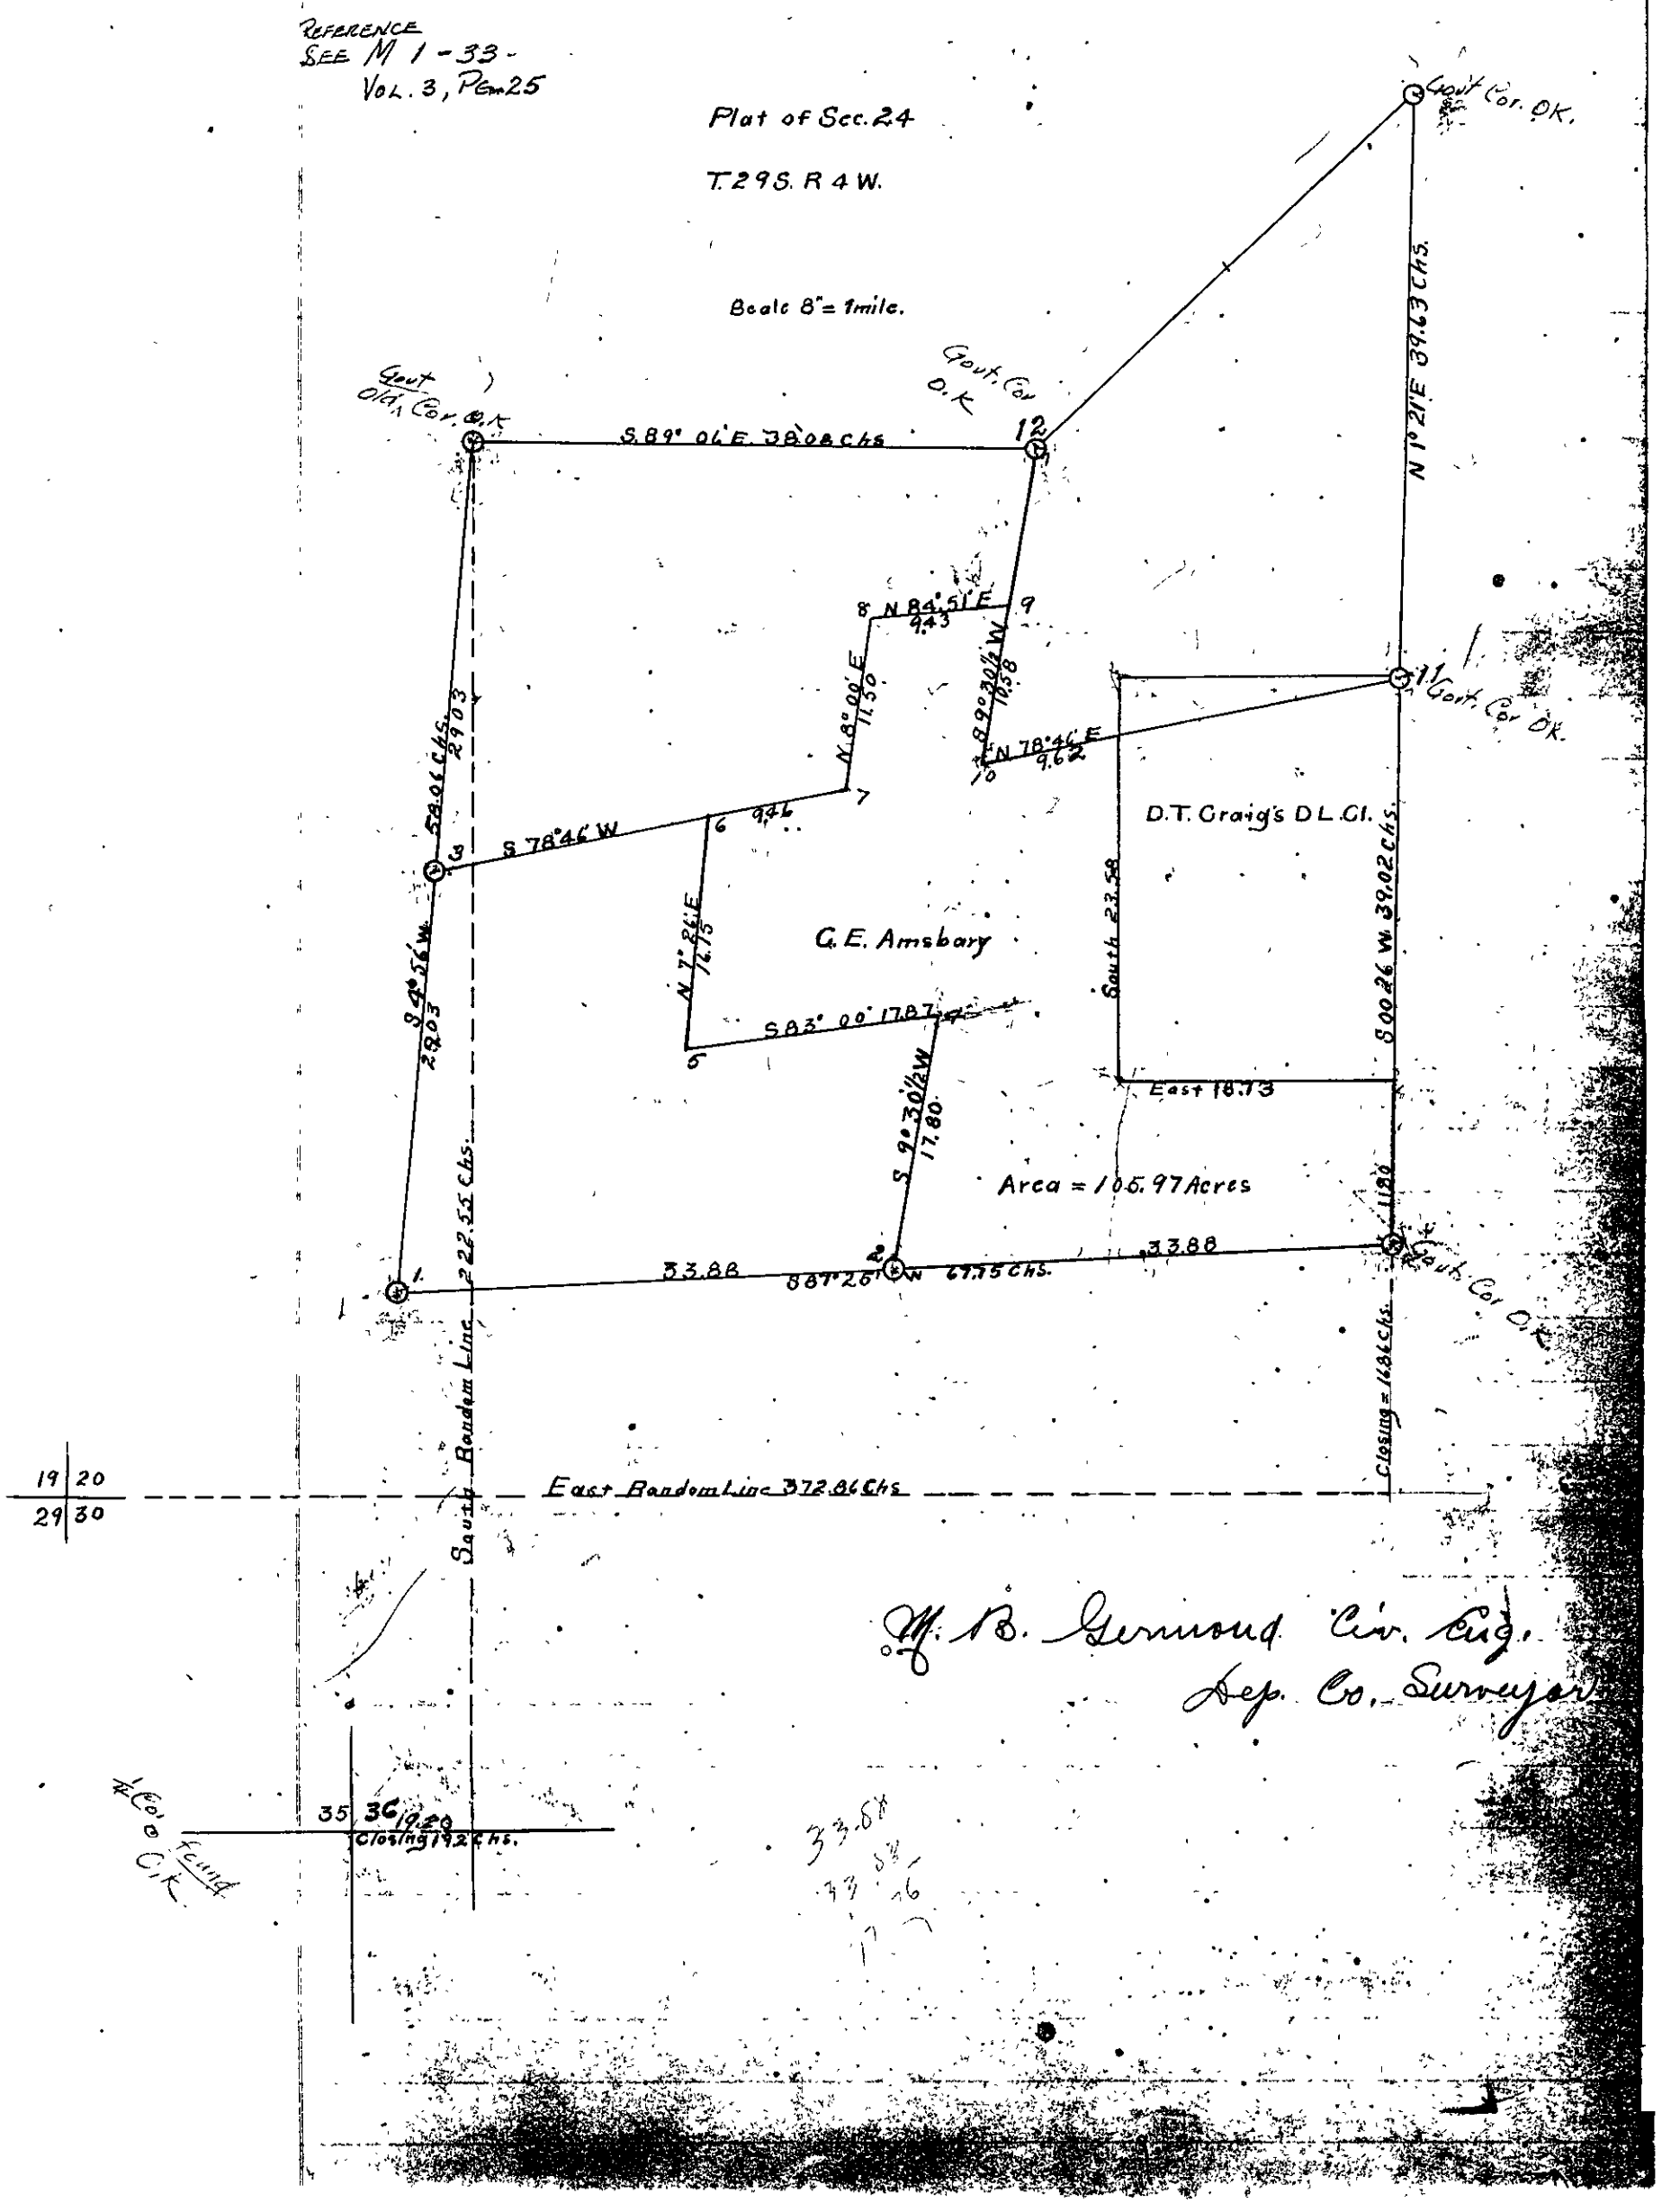
Made for C. E. Amsbary