Pg. 152

Survey No. .....

Made for Survey made for C. B. Smith

Sept 14-17 '08

Meston-Dykell Book Mfg. Co., Portland, Or.

T 26 S., R. 3 W W.M

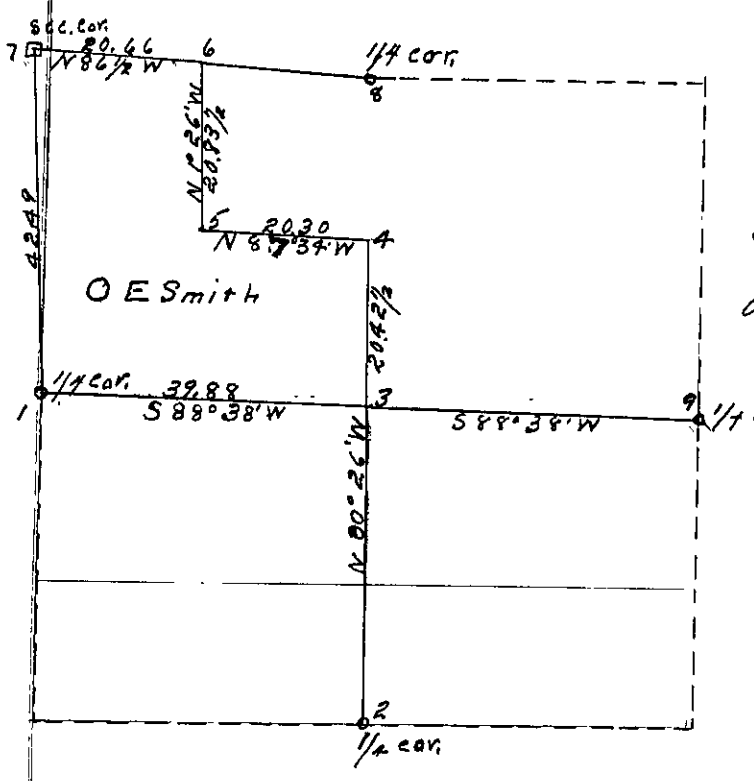

Began survey at the 1/4 corner on west side sec 21. I found a stone set by Co Sur. Britt but BTs decayed. However old trees in evidence. I run East on random at 40.00 chains set temp. stake for cor. of sec. Des continue chaining here and continue on East on random line. I intersect the E. bdy of sec 21, 1.80 chs N of 1/4 corner on E side of sec. I note this corner has been reset and BTs and corner stake in good condition.

I commence at 1/4 corner on South side sec. 21 I find old corner set by Co. Sur. Britt and note that one bearing tree is standing but out of position as per Gov. field notes. I make test of position of corner and find it impossible to set stake according to old field notes and use cor. as set by Britt. From this corner I run random North and at intersection of this random with random run East I note I fall 20 lks East of temp. stake set for cor. of section. I began chaining at the intersection of these random lines and at 39.95 chs I fell .64 lks East of position assumed as position of 1/4 cor on the North of sec 21. The position of this 1/4 cor. was taken as noted below for cor. No 8. The corner according to E. B. Chapman was located by Co. Sur. Britt as well as the ones on the South and West side of the section. The old Gov. field notes in no way apply to this corner as they give post and rock mound. No rocks in the vicinity.

From this 1/4 corner on the North side sec 21, I run random N 89° 47 W ~~West~~ at 41.32 I fall 2.37 chs S of corner for N.W. cor. sec. 21.

From these random lines I establish the center of the sec 21 at a point 39.88 chs S 88° 38' E of the 1/4 cor on west side sec 21 or at the intersection of the N & S and E & W random lines