Pg. 179

County Surveyor's Record, Douglas County, Oregon

Survey No.....

Made for E. M. Seeley and others.

T. 27 S. R. 7 W.
July 16, 17, 18, 20, 21. 1914
by F. J. Cole
Deputy County Surveyor.

F.B. No 13 = 39
Page 47 "
Pg 50

SEE ALSO M 33-41

Corners Recorded

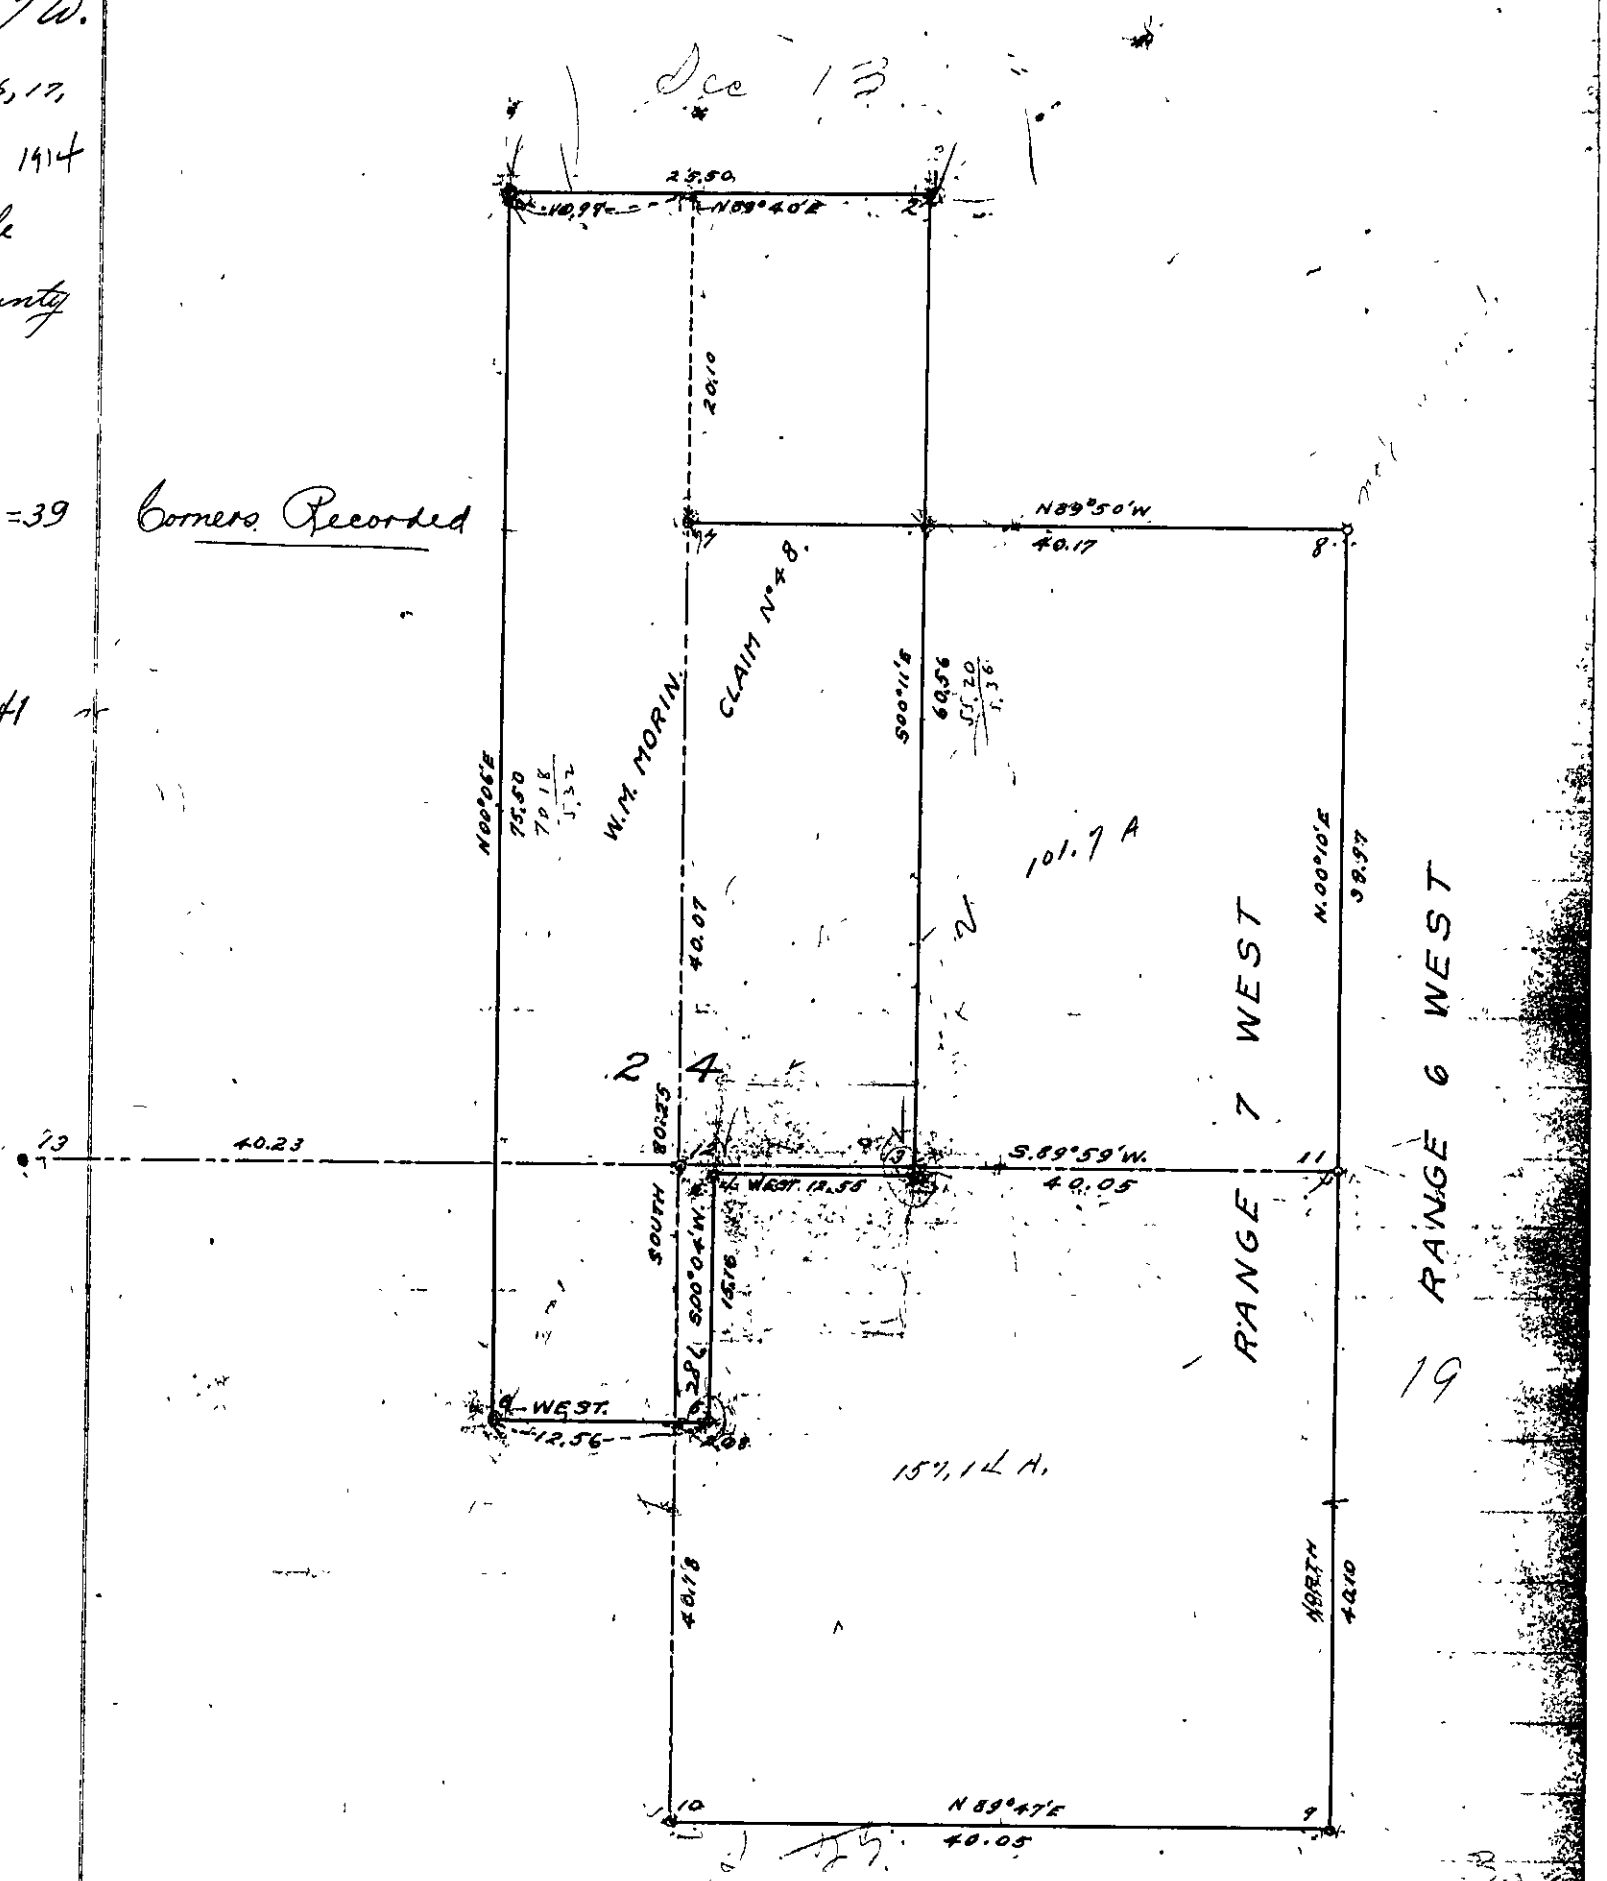

All distances obtained by measurements on the ground. M.A. Cozad and J.H. Criteser sworn chainmen.

Nos 1, 2, 3, 4, 5 & 6 of Donation claim set from original trees.

Nos 7, 8, 9, 10, 11 & 13 Set from original bearing trees.

No 12 set by intersections of quarter lines run through the section both ways. Witnessed by

A. W. Oak [illegible] N 8½° W 268 lks.