Pg 191

County Surveyor's Record, Douglas County, Oregon

Survey No

Made for Jane Walker.

T 22 S R 8 W
July 8th 1913.

Field Book 12-32
Page 32

Chairmen
C Henderson
L Ross
Geo Walker

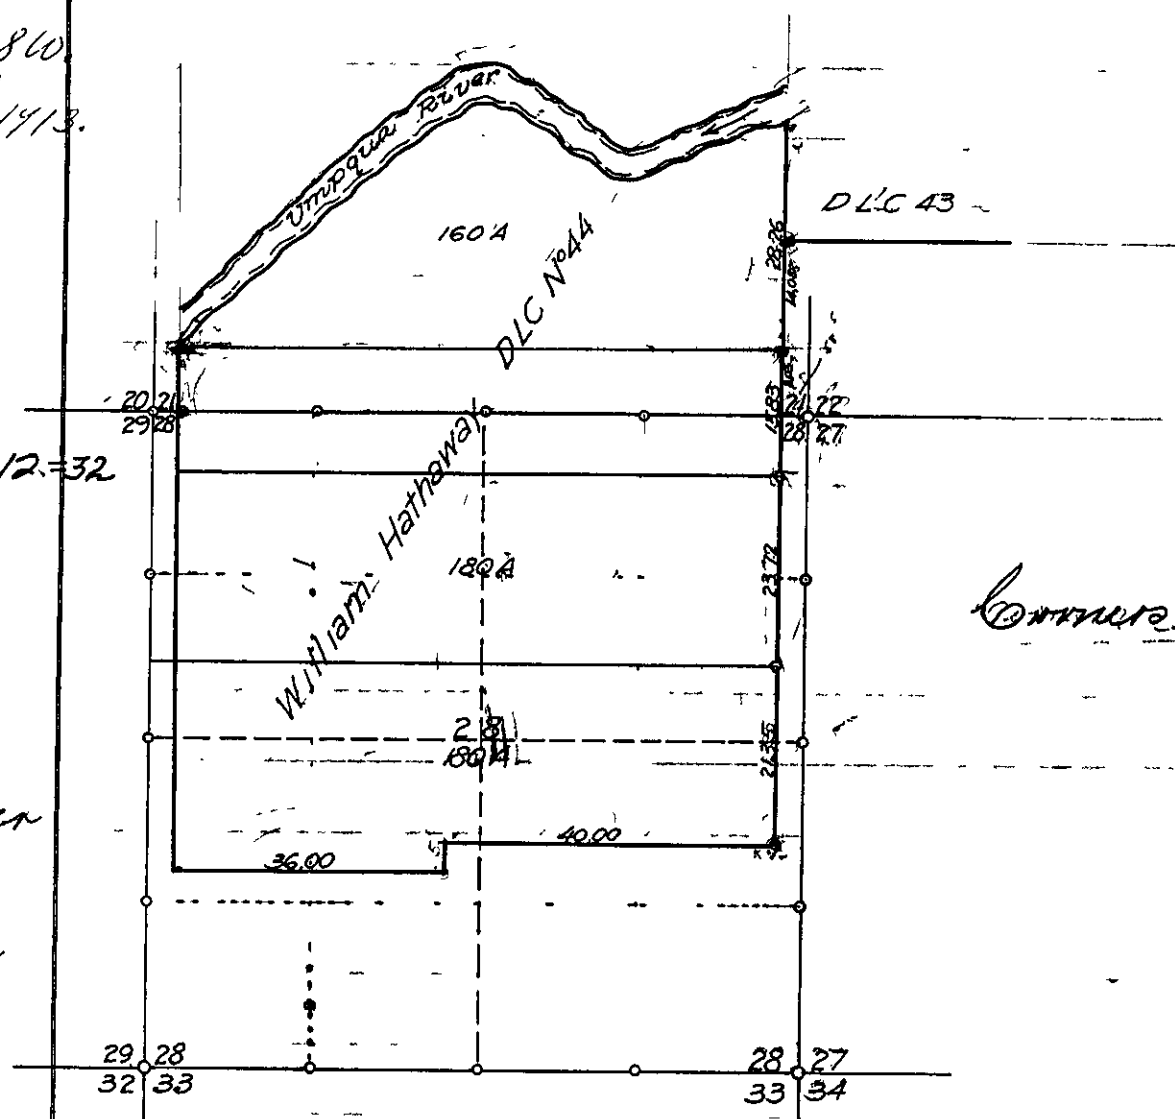

Corners Recorded.

Survey to locate the corners to the various divisions of E line of D L C No 44 T 22, S, R 8 W.

As no one knew where the E line or any of the corners of the claim were I began at the NW Corner on the River bank and established the corner from the stumps of the orginal bearing trees Set an oak post and mark

An Oak 24 in dia S 3° 30 W 91.5 lks
" 22 " " N 88° 15 E 69.5 " "

Thence East 7600 Chs To East line of Claim
Thence beginning at the SW Corner of Claim 43 Tran South (should be 38°) E 1408 Chs to the SE corner of first sub division Then on same line 1583 Chs to the SE Corner of second subdivision Thence 2372 Chs to the SE cor of third subdivision Thence 2135 Chs to the SE corner of Claim which I find previously set. I renew corner with a stone 9"x14"x18" and mark

An Oak 24 in dia N 87 1/4 E 128 lks
" 14 " " S 77 1/2 W 101 "