Pg. 220

County Surveyor's Record, Douglas County, Oregon

Survey No. .....

Made for F. M. Lodge & Rice Bros.

T. 28 S. R. 6 W.
June 17, 1915,

To establish the West boundary of the East half of the East one half of Sec 32. also to locate the South boundary of Sec. 32. and The South boundary of the N.W. 1/4 of the N.E. 1/4 of Sec 32. T. 28 S. R. 6 W. W.M.

Field Book 18-37
Page 55

Chainman
Frank Royer.
Joy Rice

Corners Recorded.

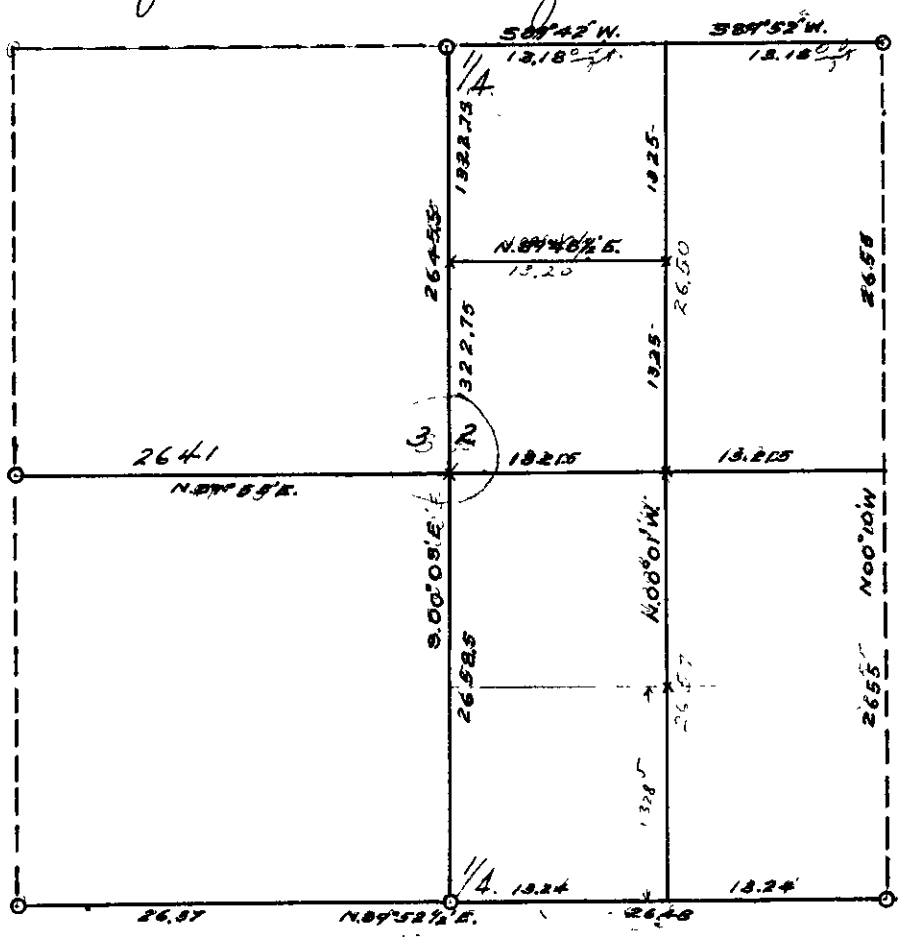

Beginning at the 1/4 Corner between Secs, 29 & 32. Ran S. 00°26' W. — 5304 Intersect South boundary of Sec. 32, 14 feet West of 1/4 corner which I locate by original tree.
Hence true direction of 1/4 line is S. 00°03' E.
Renew Corner with Oak Post 4x4x42 inches and mark a Fir 24 in N. 22° W. 8 ft.
Maple 7 in S. 2½° E. 51 feet.
From 1/4 Corner on South boundary of 32 Ran N 89°54½' E. 2648 feet, Intersect East boundary 1.5 feet South of Sec. corner, Correct direction N. 89°52½' E.
From 1/4 Corner on West boundary of Sec 32. Ran East. (Needle bearing Var 21° E) 2624 Intersect Random 1/4 line running South 2622 feet South of North Boundary. set intersection hub and turn angle. first line to be N. 89°31' E.