222

County Surveyor's Record, Douglas County, Oregon

Survey No. .....

Made for W. H. Lawrance

T 29 S. R 4 W.

Survey made to Subdivide Section "5"
J. J. Cole and J. J. Black chainmen "Sworn"
Wm Birdine marker. "

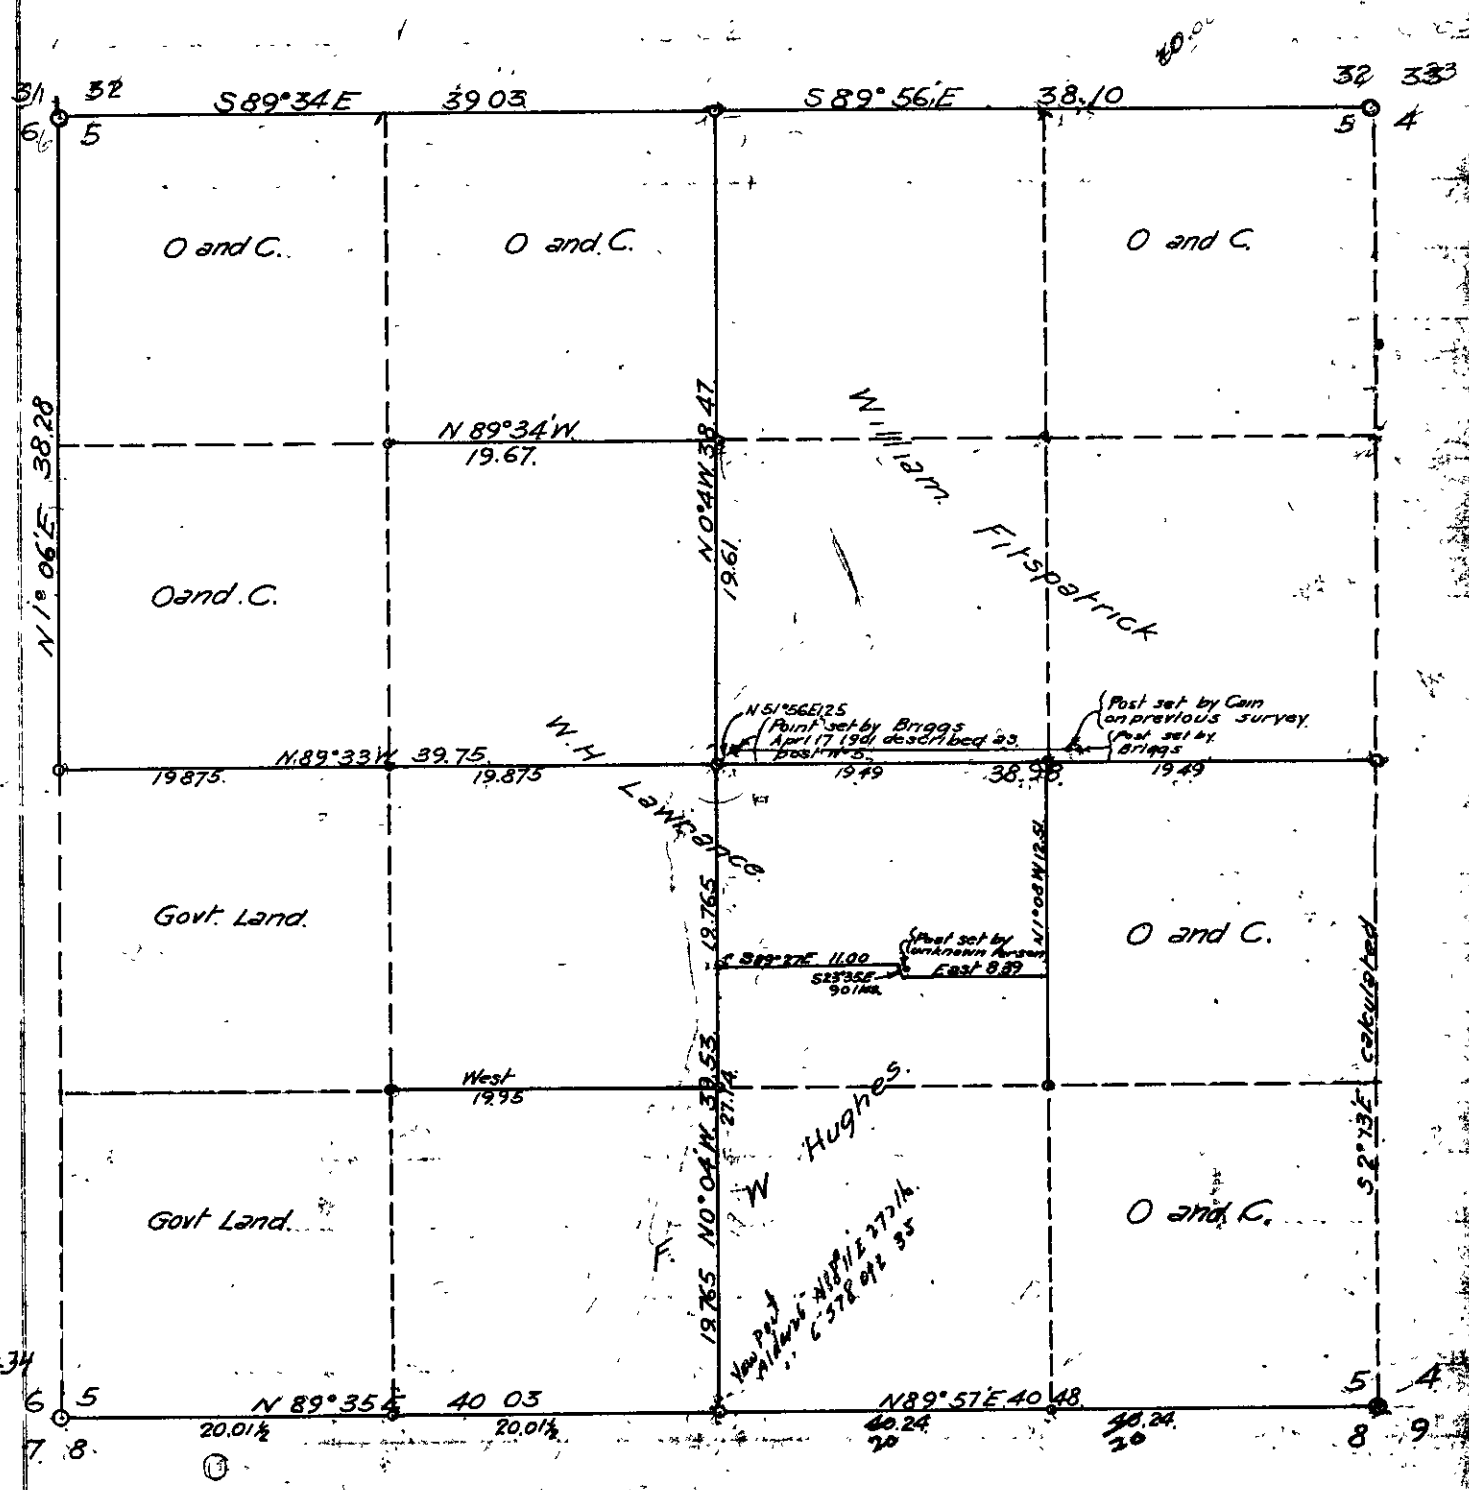

Note.
Field book 15-34
14 to 24
Pages 27 to 47.

Take observation on the sun in Latitude calculated N 43°05' June dec. May 5th 1915 9:00 A.M. N 18°43' 36.6" + 3 hrs ref 36" = 18°44' 12.6" Variation 20° 00 E.