County Surveyor's Record, Douglas County, Oregon

Survey No. .....

Made for Orval Beckley

T.22.S.R.7.W.

Corners Recorded,

Oct 25. 1915

Survey made to determine the area of lands shown on plat.

Field Book 15=34

Pages 47 to 52.

C.S. 1/8

Chainmen { Ivan Grubbe. Orval Beckley.
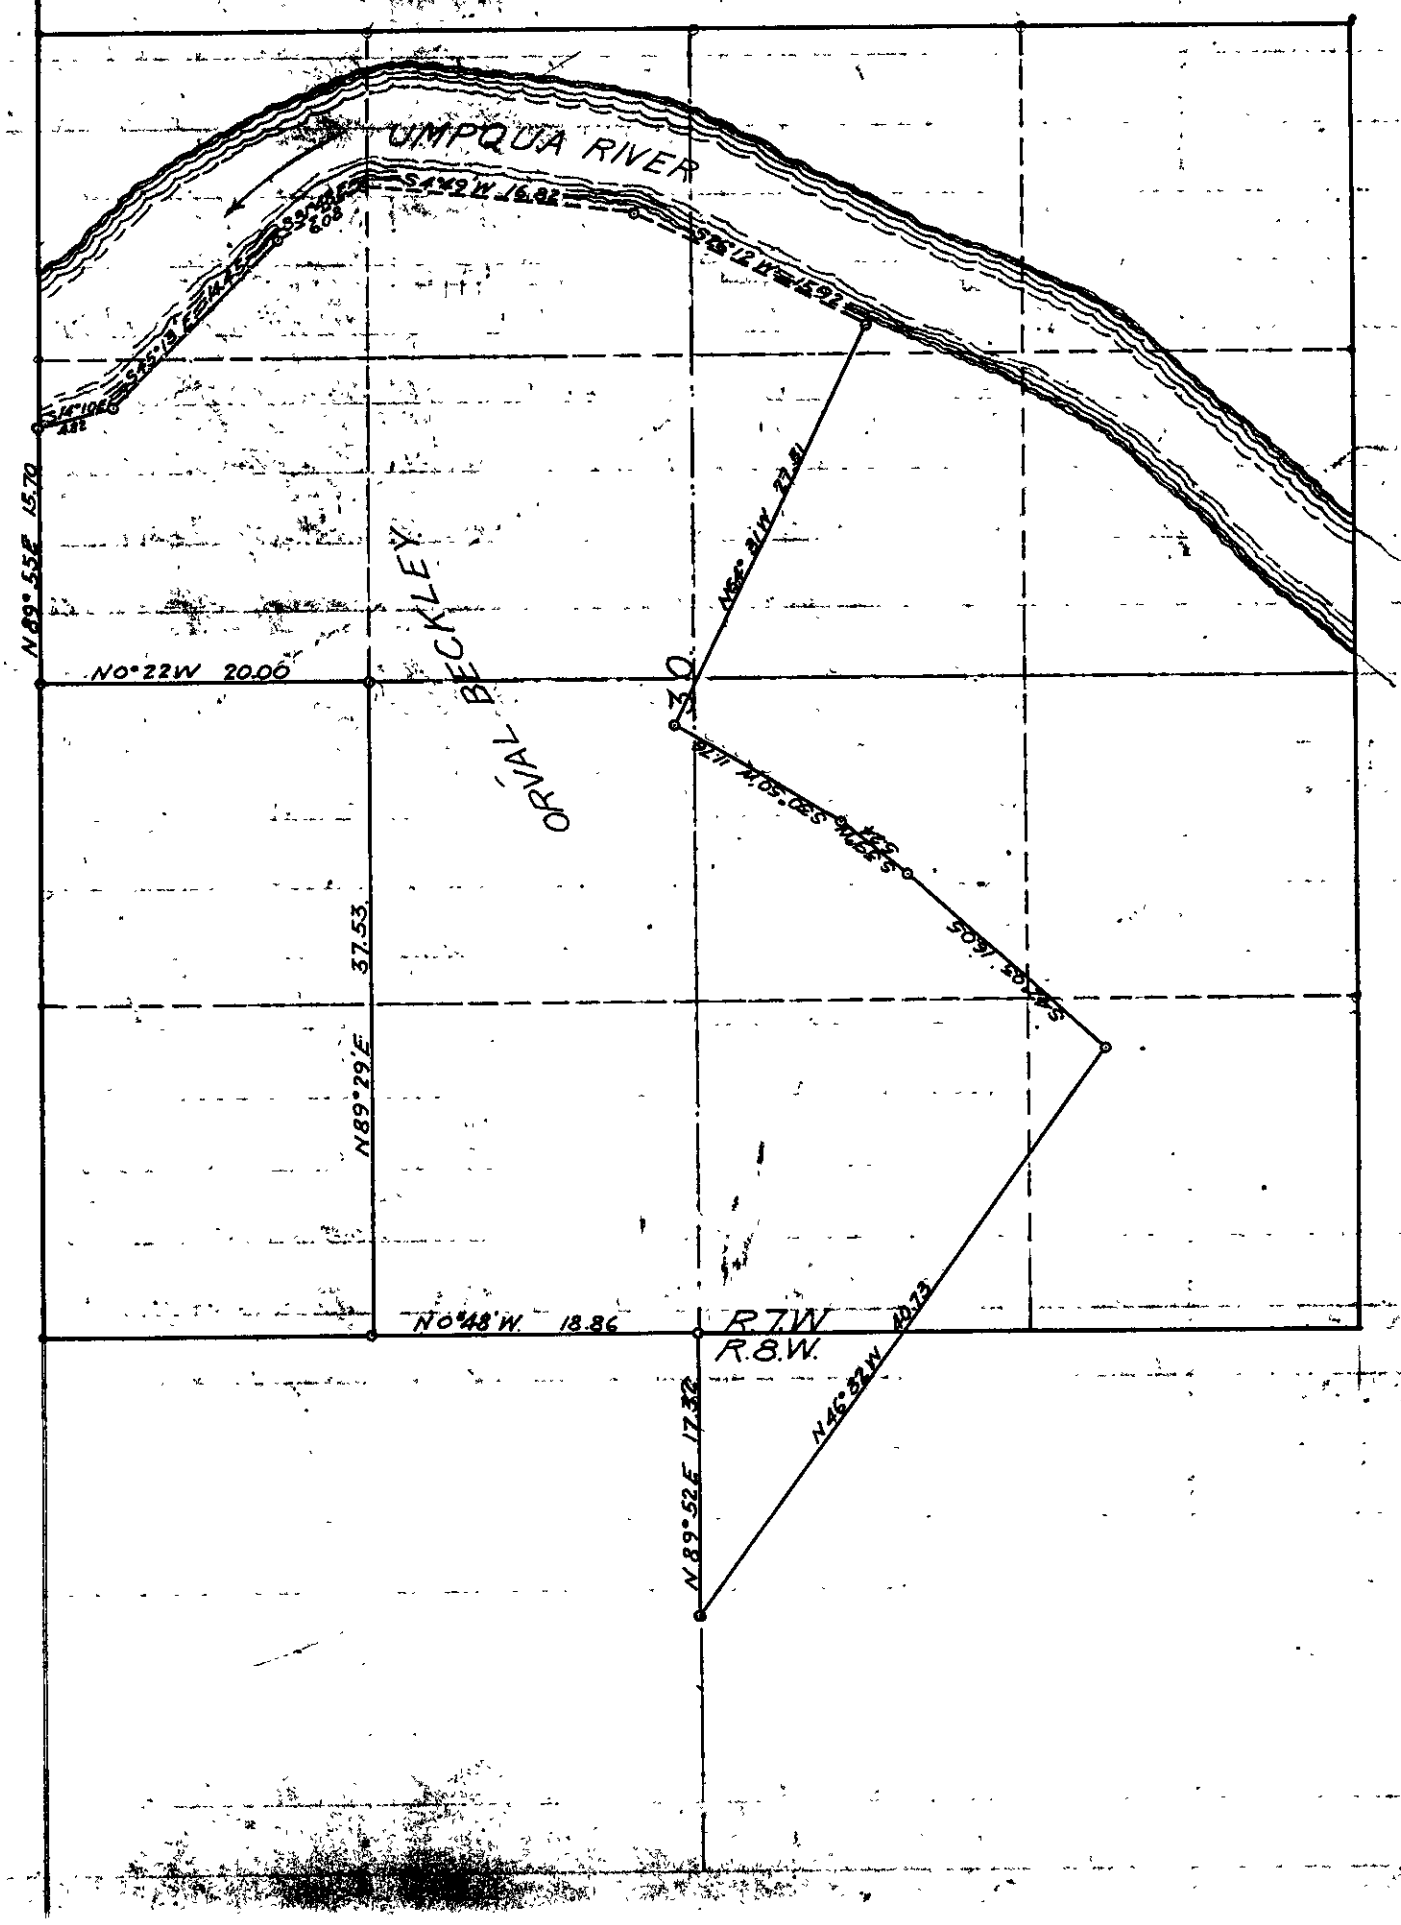
Var 21° 47 E