County Surveyor's Record, Douglas County, Oregon

Survey No. ..... Made for S. C. Bruce

T26 SR 3W
Apr. 13-17 1916

J. W. Cole

Chainmen { Cecil Black, D. A. Oden } Axemen { A. Schloeman, S. C. Bruce }

Field Book 20 Page 1 (41)
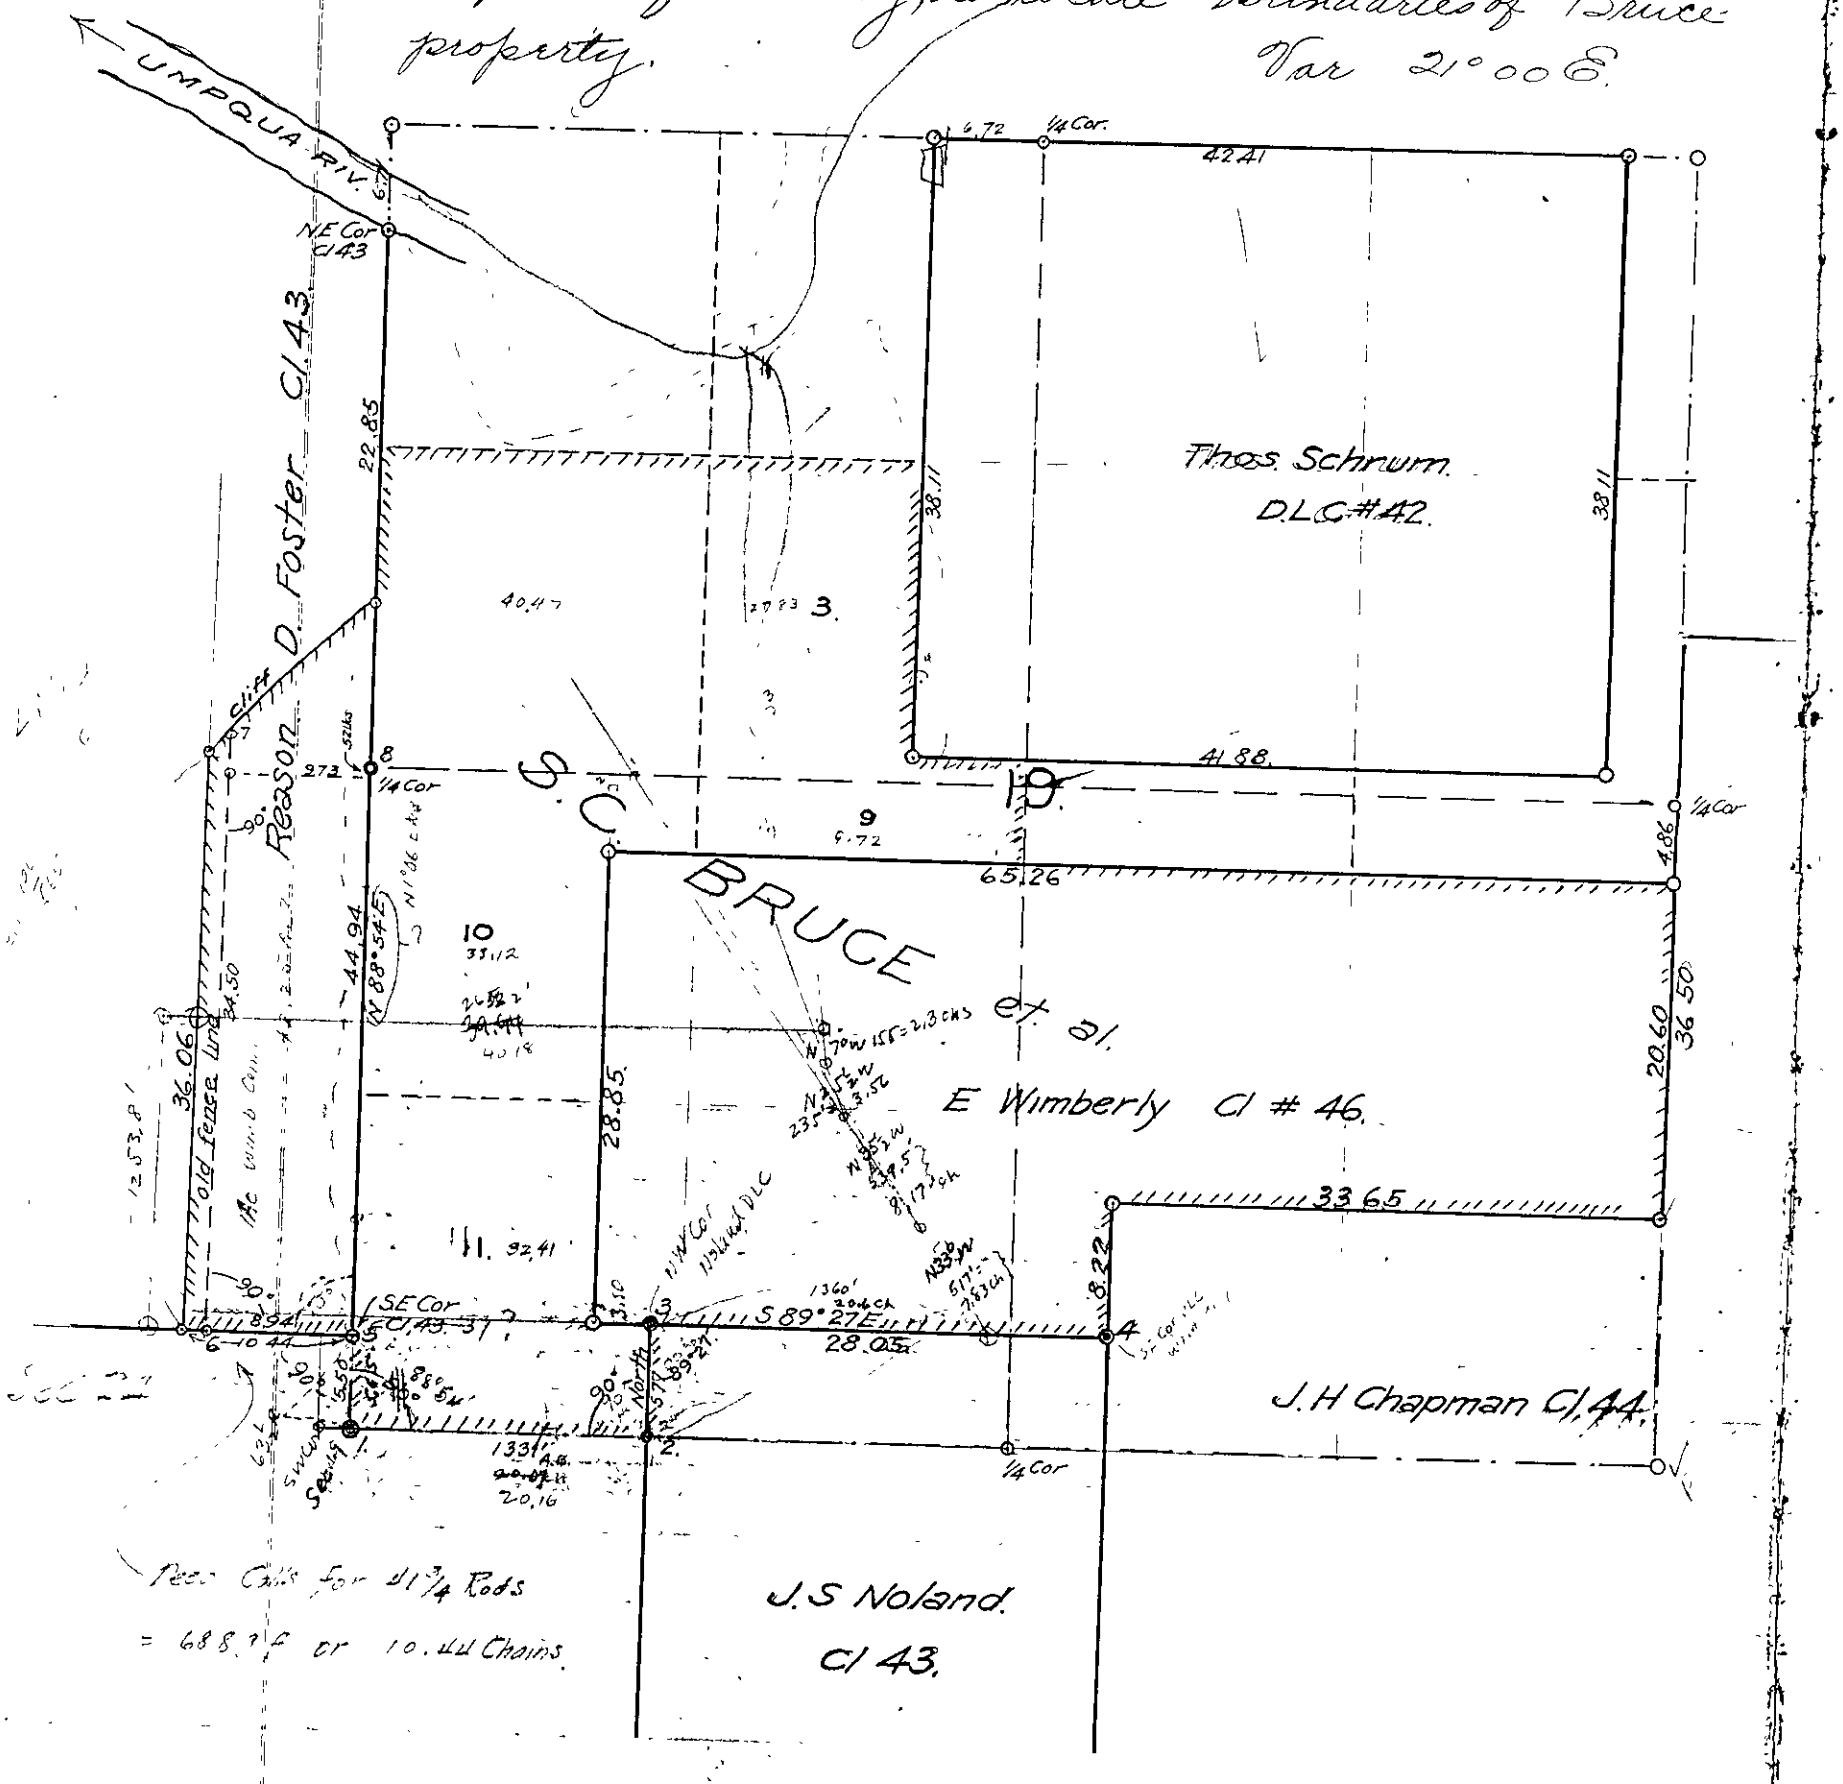
Corners Renewed Nos. 1, 3, 4, 8.
Lines run. 1-2 2-3, 3-4 1-5 5-6, 6-7, 7-8.
Purpose of Survey, to locate boundaries of Bruce property.
Var 21° 00 E.