COUNTY SURVEYOR'S RECORD, DOUGLAS COUNTY, OREGON

Survey No. *Made on* Oct. 26 1918	*Survey No.* *Made on*
In Town. 28 S. *Range* 7 west *Sec.* 26	*In Town.* *Range* *Sec.*
Made for W.S. Johnston & Victoria McDaniels	*Made for*
Purpose of survey was to establish a line between said property owners.	*Purpose of*

F. B. 14 = 45

Began survey at the ¼ cor. bet. secs. 23 and 26 above town. and range. I note the reest. of previous /. said ¼ cor. as per the old B.T.s. which are in evidence and after running a random line I begin my survey at this ¼ cor. and run a true line N.87°-15'W. between

chs.

20.50 secs. 23 and 26 and at called point "D" I set in a 1/16 cor./which is a 1" x 24" G.I.P., from which A B.O. 10" d. brs. N.09°-05' W. 22½ lks. Then I continue on and at

41.00 even I fall on the Cor. common to secs. 22,23,26, & 27. I note all but the S.E. bearing is in evidence. I set in a 1" x 24" iron bar for sec. cor. and mark no new trees.

From the above noted section cor. I retrace along an oldfence and line a distance of

39.71 to the ¼ cor. on the West side of sec.26. This ¼ cor. was setin by Surveyor F.J. Cole and was accepted as correct by Johnson And McDaniels. I then return along this line and set in point "C", which point is on line bet. sec. and ¼ cor. and midway between them or

19.86 southerly of sec. cor. From this point "C" I run a mag. line S.88°-00' E. until I inter sect a line run from the N. as follows.- viz. I return to the line run between the sec. cor. and the ¼ cor. on the N. side of sec. 26 and at the point called "D" set on this line I run a line South (mag) approx. 20 chains. Therefore at the intersection of the lines run south from "D" and Easterly from "C" I set in point "A" for the approx. S.E. Cor. of the N.W.¼ of the N.W.¼ of sec. 26. Point "A" is a stake.

I note that the ¼ cors. on the N. And W. sides of sec. 26 had been set in by Sur. F.J. Cole a short time before and was in good condition. New Gurley transit was used and magnetic lines were run. Chmen. were "L. McDaniels & " " Howard
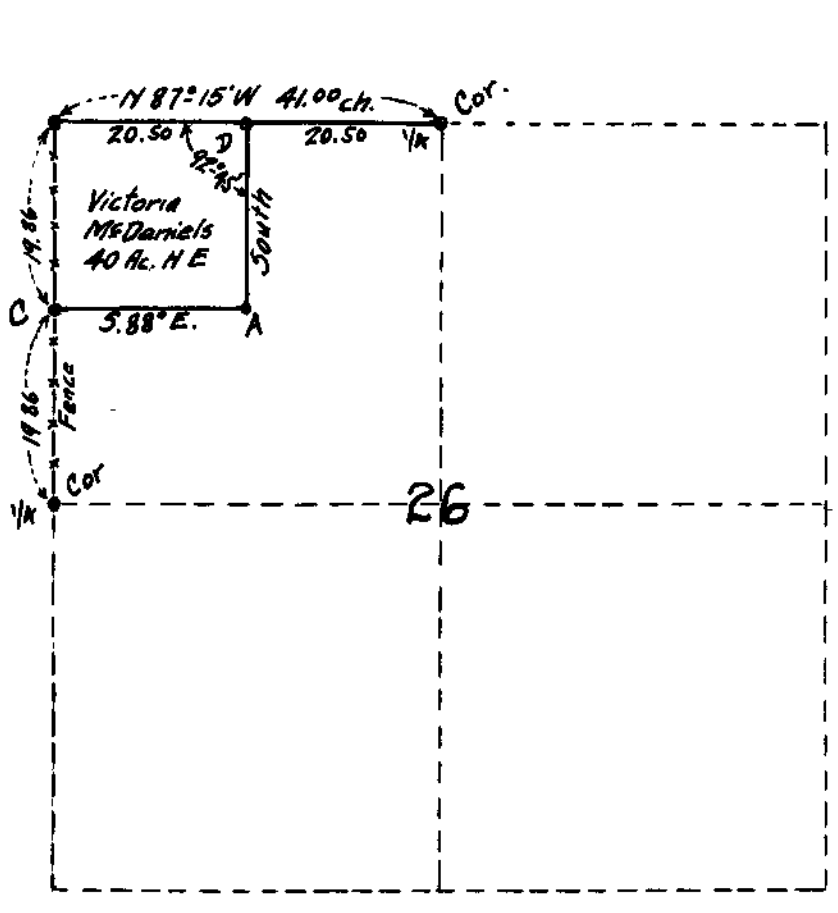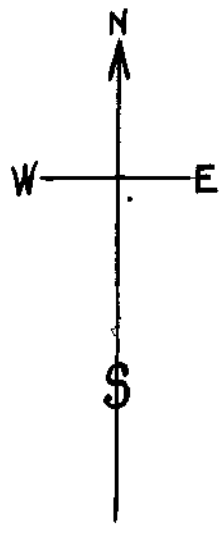
F. C. Frear
Dep. Co Surveyor.