COUNTY SURVEYOR'S RECORD, DOUGLAS COUNTY, OREGON

Survey No. *Made on* Aug 17_ Sept3 1920	*Survey No.* *Made on*
In Town. 29 *Range* 9 *Sec.* 25 & 26	*In Town.* *Range* *Sec.*
Made for Denn. Estate	*Made for*
Purpose of To determine lines dividing property assigned to the different heirs	*Purpose of*

FB. 18 = 48 cs. 6/17

o Cor's Renewed.
o Points Set to indicate divisions
◎ Cor's found Standing
⊠ 1/16 Cor's Witnessed by B T's See FB#18

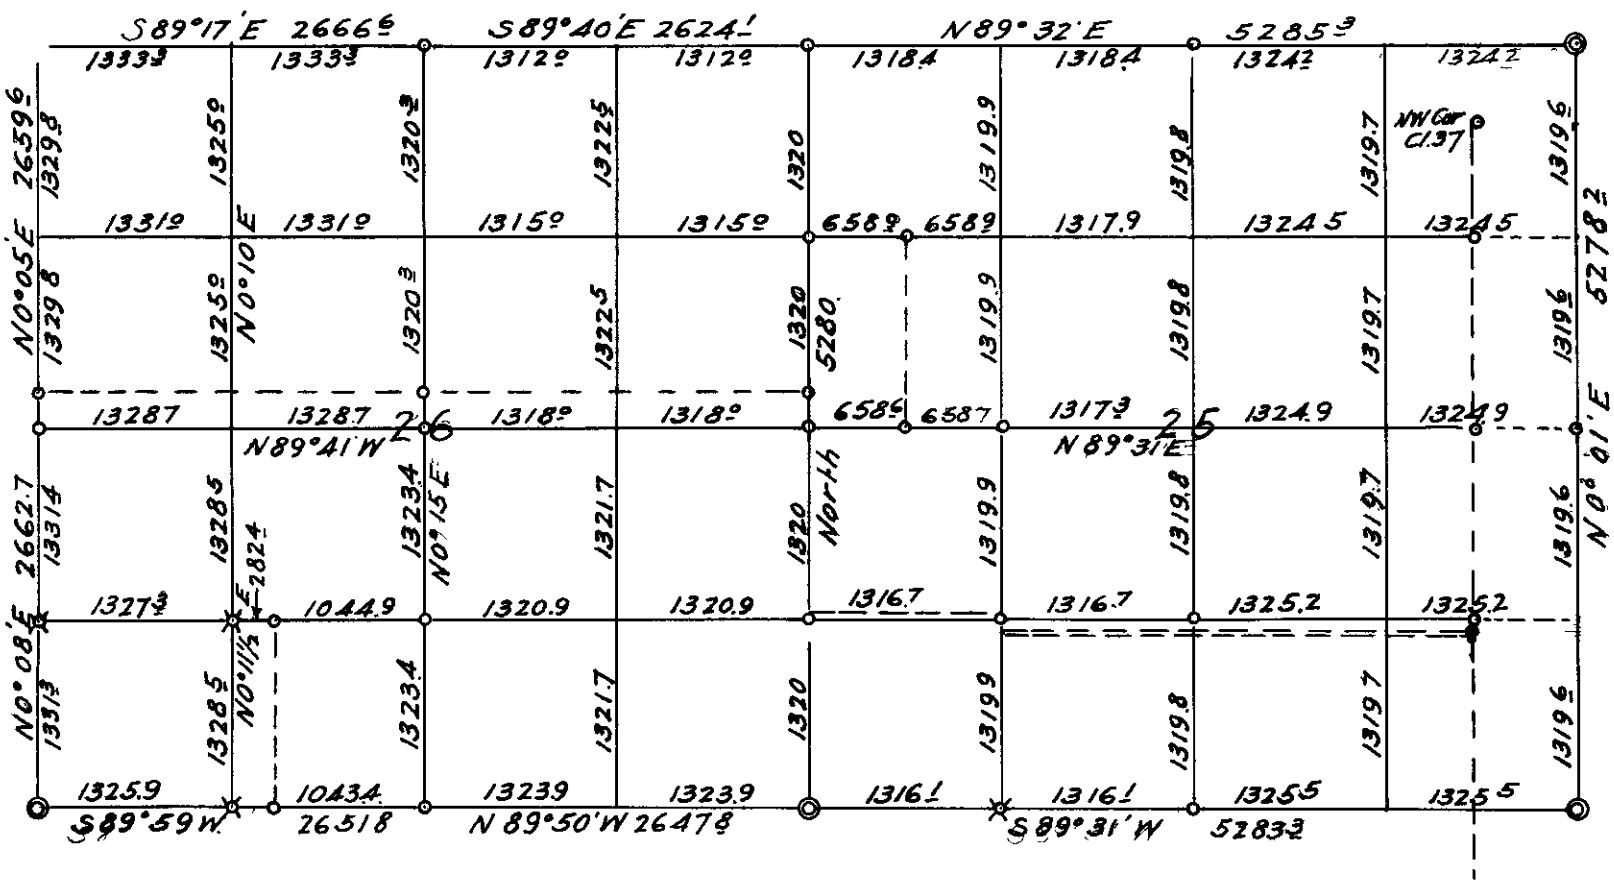

Begin the survey at the N.W Cor of D.l.C No.37 T29 S R 9 W ,find Original B.T. alive and standing. Went to the tree and run N 60°W 243 lks. with Var 21°15E Set a pin and find that the original ground had been excavated to turnpike the road and the distance and direction given ,put the point 6½ lks. North of the D.L.C. line as designated by the fences bet. R. Dick and Stanley property. Also Jake Denn testifies that the corner formerly stodd on fence line ,I used this as evidence and moved point south 6½ lks. and established the corner as recorded in Book of Corner records .

S89° 40' E Along center of road

10.29 Ch. Set point approximately on the Twp. line

10.56 " Fence East side of Road north and South

25.54 S.E. Cor of Claims 38 & 42 which is a rock in fence corner.

From point on the Approximate Twp.line Chain along the Center of road North

8.24 Ch. Set point for Approximate corner and later during the survey Jake Denn Showed me a rock placed by a surveyor (Emerson) many years agowhich was 6 lks. East of measurement point . Find stump of old Ash

N34° 30'E 10.53 Chs Compass set with Var 20°45' which makes it read North sighting along the center of road on Township line

Thence North along the center of the road

32.80 center line of Road East

40.00 Set a point and look for Bearing trees,find a large Oak alive ,