COUNTY SURVEYOR'S RECORD, DOUGLAS COUNTY, OREGON

74.

Survey No. *Made on* Sep 23 to 26 inc 1920	*Survey No.* *Made on*
In Town. 27 *Range* 4 *Sec.* 9	*In Town.* *Range* *Sec.*
Made for E.E.Dent	*Made for*
Purpose of Survey was to establish the div. line between Dent and Strader also to stake proposed road as shown on sketch and make description for deed.	*Purpose of*

F.B. 18 = 48.

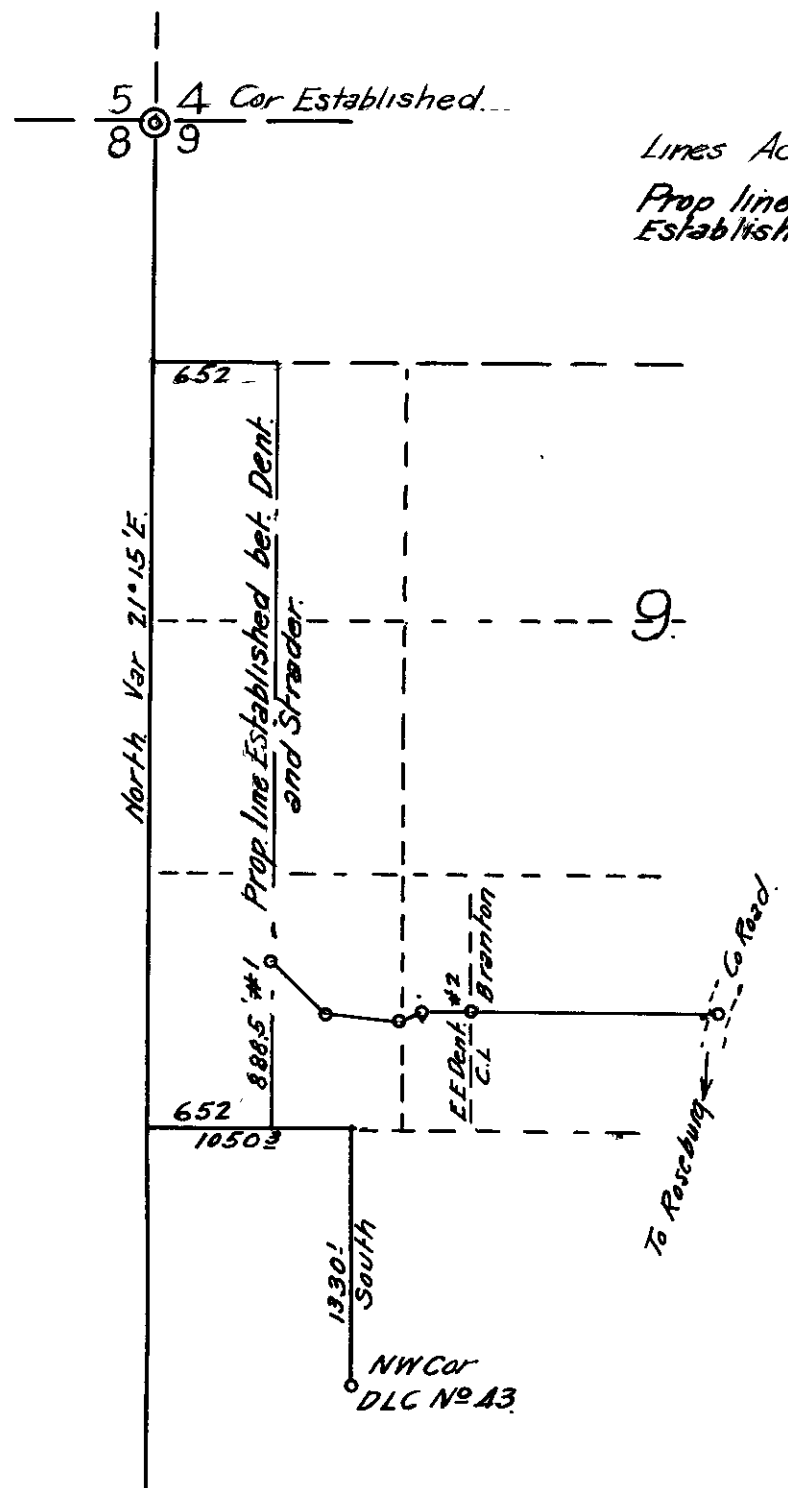

Lines Actually run Shown solid

Prop line bet Dent and Strader Established by offsets from Sec line

#1 Initial Point of Road across Dent

#2 " " " " " Branton

Begin Survey at the cor to Sections 4,5,&8,9 T 27 S R 4 W. W.M Established the corner from the old Bearing trees,as recorded in Govt Book of Cofners, I ran thence South without chaining ,setting hubs on line about every 1,000 ft At approximately 80.00 chains I set hub in fence line ,supposed to be on the Section line, I hunted for evidence of the corner but could find n none. I then ran south by a traverse chaining the distance,and intersecte the ¼ cor. bet 16&17,a straight line connecting corners,bears S 0°02'W from beginning point.

I then ran East 1050.3 ft Thence South 1330.1 to the NW Cor of D.L.C No 43. Then from a point 652 East of true line bet Secs 8,9,~~16~~ 17 & 16 and on fence line I ran North along the division line between Dent and Strader 888.5 ft. to a point which is the beginning point of a road across Dent. Thence along the center of the proposed road,S46°27'E 412.0 ft. Thence S84°33'E 386.0 ft. N60°42'E 116.3 Thence N89°56'E 248.0 ft. to the property line between Dent and Branton. Thence N89°56'E 1291.8 ft. along proposed road across Branton to the center line of the County Road. Rainy and Cloudy the entire time and I could not make a sun observation.

J. W. Cole

DEPUTY COUNTY SURVEYOR