76

COUNTY SURVEYOR'S RECORD, DOUGLAS COUNTY, OREGON

Survey No. Made on Oct. 21 1920	Survey No. Made on
In Town. 22. Range 5 Sec. 16-17	In Town. Range Sec.
Made for Jack Roach + J. H Sneed.	Made for
Purpose of for Deed Description	Purpose of

C. S. 1/26
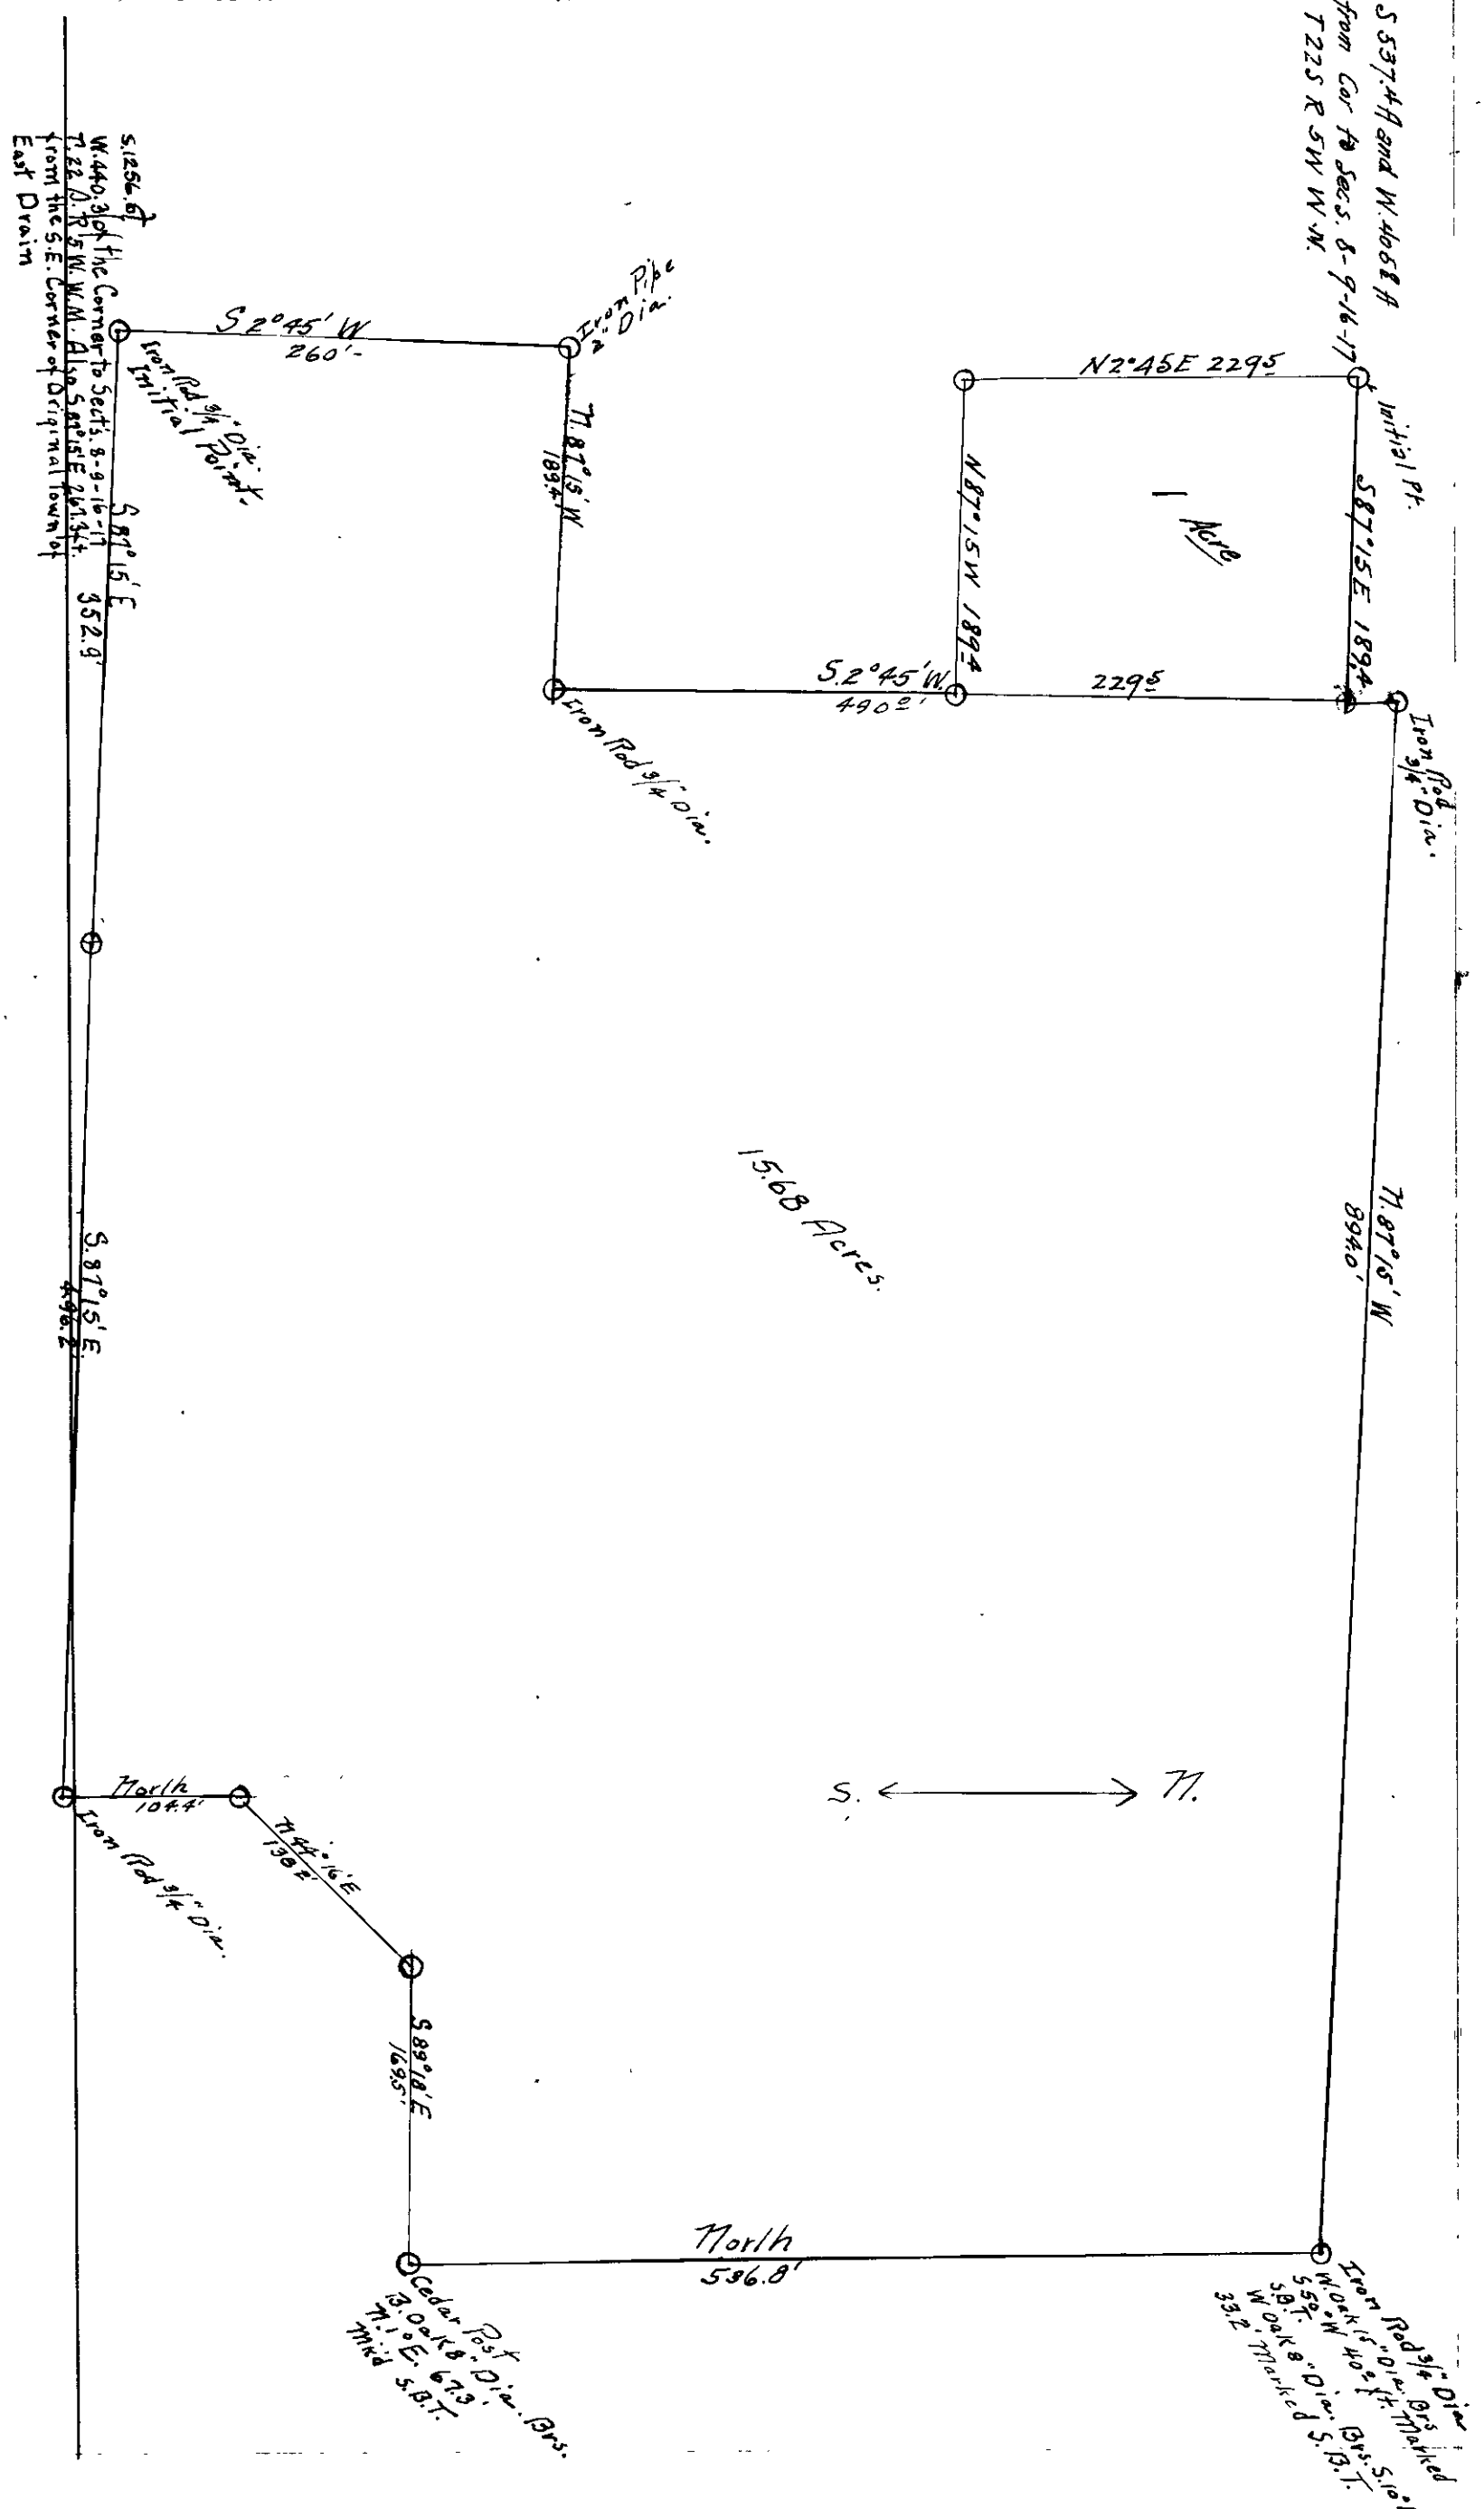
F.B. 19=49. J. W. Cole Deputy