80.

COUNTY SURVEYOR'S RECORD, DOUGLAS COUNTY, OREGON
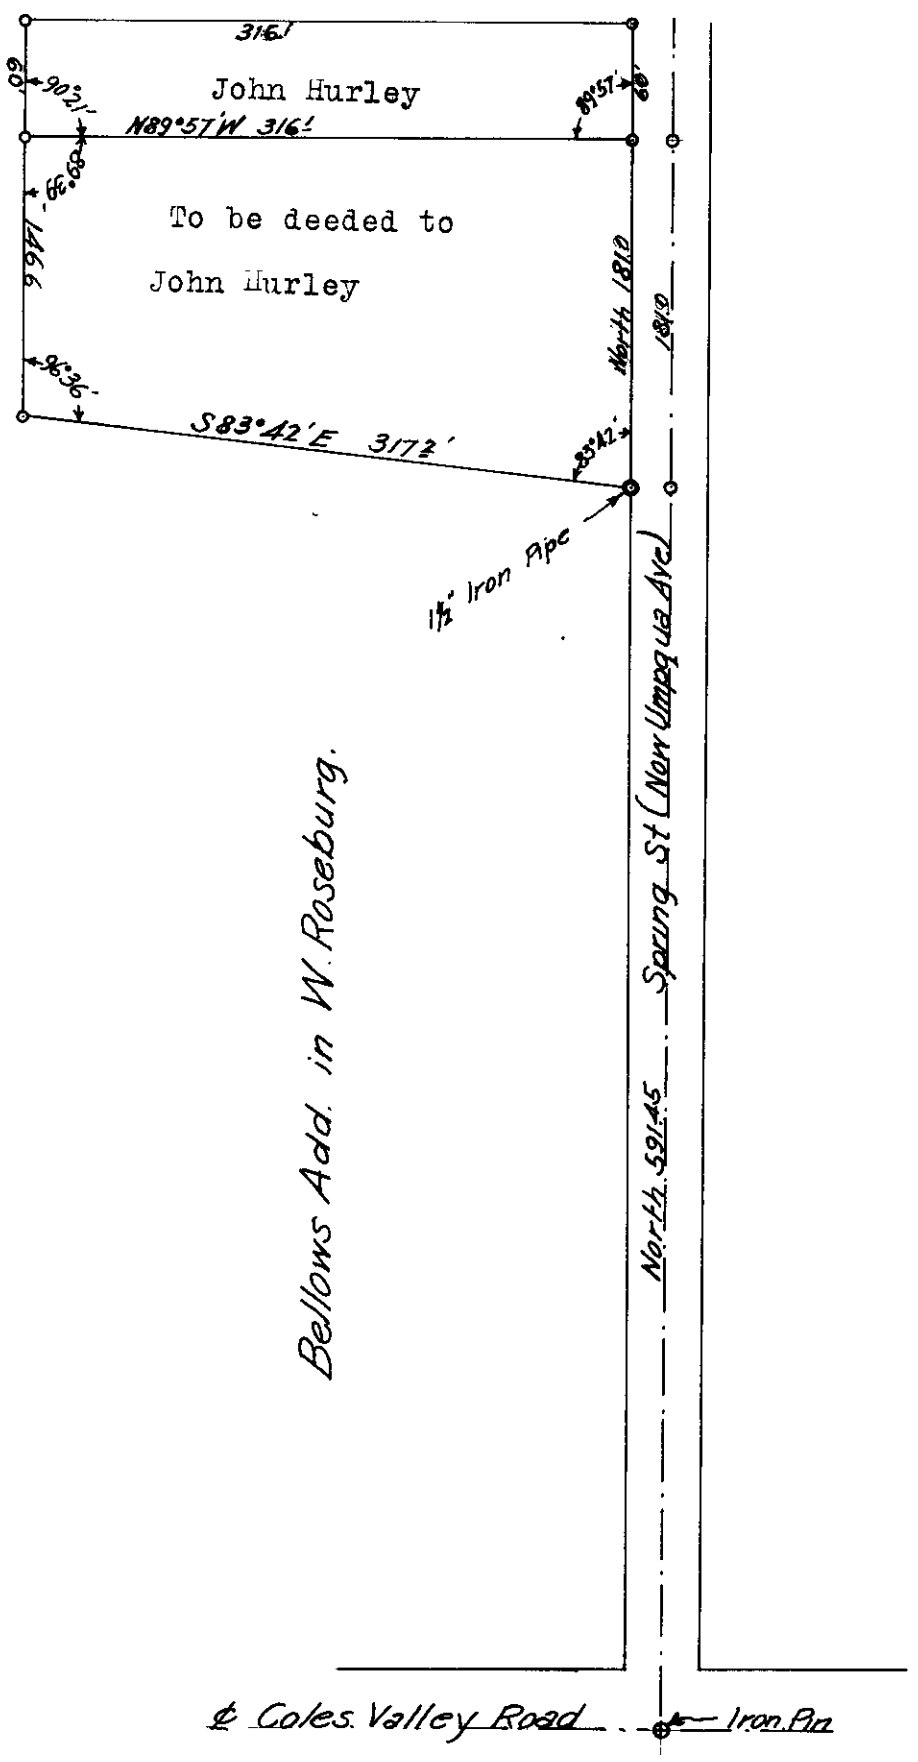
Survey No. *Made on* Nov 8 1920	*Survey No.* *Made on*
In Town. West *Range* *Sec.*	*In Town.* *Range* *Sec.*
Made for In West Roseburg for John Hurley	*Made for*
Purpose of Purpose to get correct deed Description of lots shown on sketch	*Purpose of*
Field. Book. No 19 Page 16	
C.S. 17/9 J.W. Cole Deputy. L. Smick - Chkr.