89

COUNTY SURVEYOR'S RECORD, DOUGLAS COUNTY, OREGON

Survey No. *Made on* Feb 18 1921	*Survey No.* *Made on*
In Town. 22 S *Range* 7 W *Sec.* D.L.C. 42	*In Town.* *Range* *Sec.*
Made for Oliver Hines and Del Wetherly	*Made for*
Purpose of To mark that portion of the East Bd'y of Cl 42 ,whic was a property line Between them J.J.Cole Deputy Lou Smick Chain	*Purpose of* Witnesses --- Del Wetherly Oliver Haines

FB 20 - 50

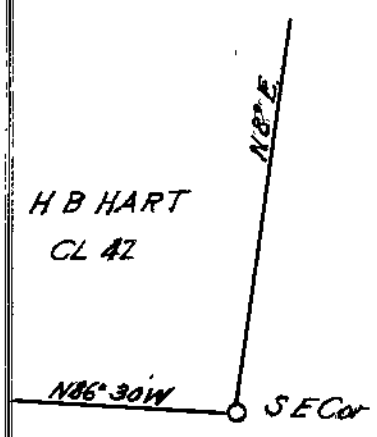

I began the survey at the S E Corner of the H.B.Hart Cl 42 ,which I renewed from three original Witness trees, I set a rock 18"x18"x 24" marked with a cross from which a Stump of, an Original bearing tree Bears N56°W 57.2 ft. A Large Oak bearing scribe marks bears N 9°E 134 ft. A sang of a Large Oak bearing scribe marks bears S 87°E 72.6 ft

A Point of ledge rock bears S80° W 50.3 ft.
" "n " " W S25°30'W 22 ft.
Both ledges marked C.L.42

I then set West from the corner 20 ft. and run N8°E to a flag setting 20 ft West of the North East Corner of Cl.42 set stakes on line without chaining,and then measured 20 ft east fro the stakes on the offset line for points on the Claim line.

T 22 S R 7 W W.M.

SURVEY FOR HELMS & SHAEB FEB. 24 1921

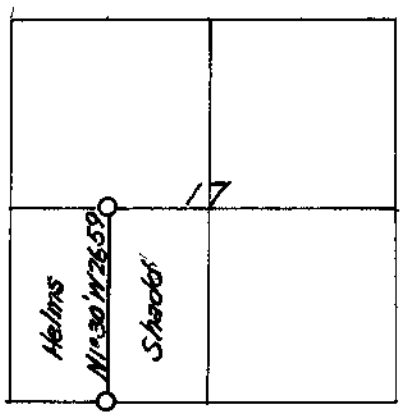

The Survey was made to establish the 1/16 line North and South through the S W ¼ of Se. 17.

By J.W.Cole

I began the survey at the 1/16 corner on the south Boundary of the SW¼ of Sec 17 ,which is an iron pin at the corner of the fence,

Thence North on a random line with assumed VAr. of 21°30' At 2658.9 ft I intersected 68.0ft.East of the 1/16 corner set by Frank Cain,which I renewe by settin a large cedar post marked 1/16 CS.

I then corrected to the true line from the hubs set on the random line and computed the bearing of the true line to be N1°30W 2659 ft.

FB No 20 Page 26

6-17-02 Rwb

Survey of the George Paine D.L.C. No. 53 T 23S R 7W W.M.
Surveyed for Warren Cheevers Feb. 25 1921

3782 FT
SEE FB 50
PG 29

I began the survey at the South West Corner of the Paine Claim, which I established from a large Oak bearing tree,which I chopped out and found the scribe marks, I ran N 65° W 308.9 ft and set a stake , Then from the stake I ran S80° W 132 ft. and found the remains of an Ash tree 15 " dia lying down and partly decayed , I renewed the corner by setting an Oak post 4"x4"x40" and also an iron binder shaft 1"x 60" and marked a new tree S86° 30'W 32.3 ft. Thence N17°39'E 3014.2 ft Solar direction,and set a temporary corner,and searched for evidence of the original corner,but could not find any, Thence I ran S75°30'E on a random line and at 478.9 ft I intersected the Township line 197.2 ft South of the Corner to Sections 6-7-1-12 ,which I renewed from the original bearing trees both of which were alive and standing I set an Oak post 4"x4"x40 also an iron pipe 1"x 30" for corner and Marked a new tree A W Oak 10" in dia. N53°15'W 29.0 ft.

Thene I continued the line S75°30' E and at 3090.2 ft from the Temp.NW Corner I intersected a rock which had previously been set for the NE Corner of the Paine Claim , I then Established the North West corner of Claim 53 80 ft. North and 11 ft East of the temporary corner.We made it correspond with the tie given in the government field notes. I set an iron plow coulter and an Oak stake 4"x4"x40 " for the corner and marked new trees, A W Oak 24" in dia. S14°45'W 104.5 ft. AW Oak S73°20'E 112.5 ft .

I then corrected the West boundary of Claim 53 to N17°35'E and blazed the trres on line,this line followed an old blazed line exactly,

I also corrected the North Boundary of Claim 53 to S 75°05'E and Marked the line by stakes and blazing the trees on line.

From the Rock at the North East corner of Cl. 53 I ranN8°00'W 1700 ft to the North West corner of the Gant Claim No 50 to check position of corners that I had established,

(See Next Page)