COUNTY SURVEYOR'S RECORD, DOUGLAS COUNTY, OREGON

95

Survey No.	*Made on* June 6 1921
In Town. 26 S	*Range* 3 W *Sec.* 29-32-33
Made for	Lexington Invest. Co per Walter Hamilton
Purpose of	To establish lines for fencing
	J.W.Cole Deputy
C.S. 1/47	L.N.Smick Asst.
F.B. 21-51 pg. 31-38	Floyd Watson Axe
	Seth Mathews Axe

Survey No.	*Made on*
In Town.	*Range* *Sec.*
Made for	
Purpose of	

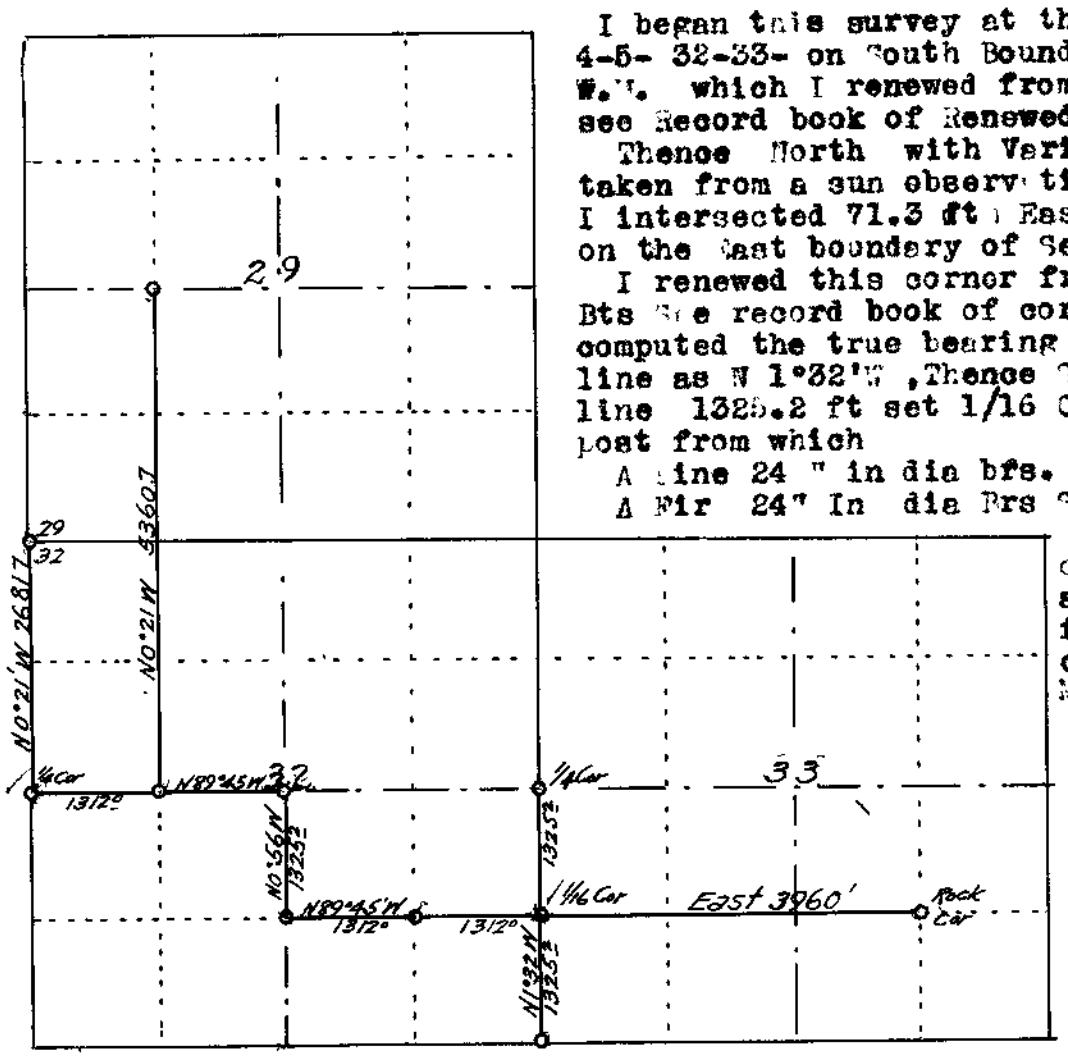

I began this survey at the Corner of Secs 4-5- 32-33- on South Boundary of T 26 S R 3 W W.M. which I renewed from the original B.T's see Record book of Renewed Gov't Corners

Thence North with Variation of 21°00'E taken from a sun observation, at 2650.5 ft, I intersected 71.3 ft East of the 1/4 Corner on the East boundary of Section 32.

I renewed this corner from the original Bts See record book of corners renewed, and computed the true bearing of the Section line as N 1°32'W , Thence N1°32'E on true Sec line 1325.2 ft set 1/16 Corner a cedar post from which

A pine 24 " in dia bfs. N 68°30'E 10.5 ft.
A Fir 24" In dia Brs S 6°30'W 55.3 ft.

Thence from the 1/16 corner , East 3960 ft and set a large rock for corner also a cedar stake 4x4" Marked rock with X

I then returned to the 1/16 corner on the Section line , and ran N89°45'W 1312 ft and set a large cedar post for the approximate 1/16 corner, Thence continued West or, N89°45'W 1312 ft and set another Large cedar post for the approximate 1/16 corner, Thence I ran N0°15'W 1325.2 ft and set a large cedar post for the approximate 1/16 corner, Thence N89°45'W 1312 ft. and set a large cedar post for the approximate 1/16 corner, Thence continue N89°45'W 1312 ft to the 1/4 Sec corner bet. Sec's 31 & 32 which I renewed from one original B.T. See record book of Cor's renewed , Thence N 0° 21'W 2687.1 ft to the corner to Sections 29-30 31-32 all bearing trees standing.

I then returned to the approximate 1/16 corner S89°45'E 1312 ft. from the 1/4 corner and ran N0°26'W 5350.7 ft to a rock , nearly round and 12" in dia .burried flush with the ground, This rock apparently had been set by some previous surveyor, and a fir tree due South bore a scar but no scribe marks. I assumed this to be the corner and corrected the lines accordingly, All the lines were marked by large cedar stakes , set at frequent intervals, and trees on and near line were blazed.