COUNTY SURVEYOR'S RECORD, DOUGLAS COUNTY, OREGON

Survey No. 111 *Made on* Feb 16 1922	*Survey No* *Made on*
In Town 27 S. *Range* 6 . *Sec.* 13 & 14	*In Town* *Range* *Sec*
Made for Thomas Barton	*Made for*
Purpose of survey was to establish line between Barton and Wilson	*Purpose of*
N. I Eppstein County Surveyor. E.N. "LL"	

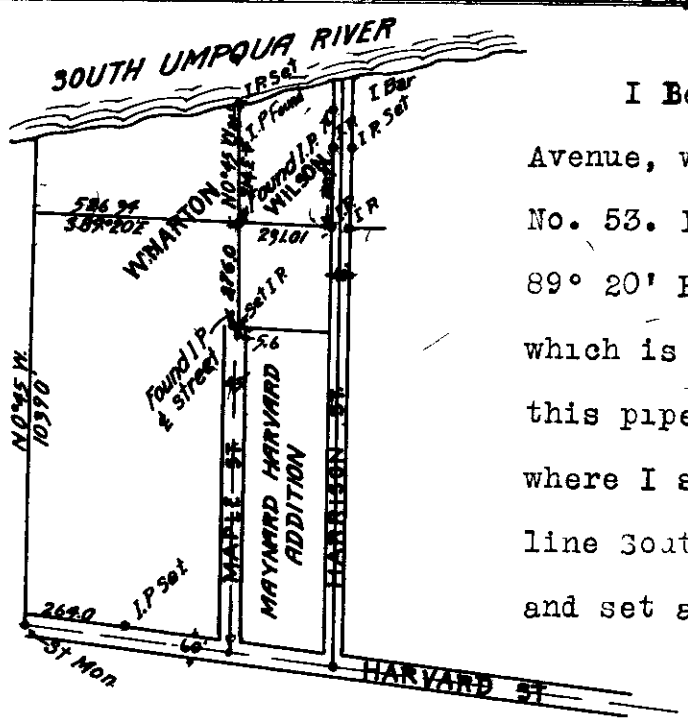

I Began the survey at the street monument on Harvard Avenue, which is on the east line of John Leiser D. L. C. No. 53. I then ran N. 0° 45' W. 1039.0 feet, Thence South 89° 20' E. 526 34 feet, and there I found an Iron Pipe, which is the South West Corner of Wilson's place From this pipe I ran N. 0° 45' W to the South Umpqua River, where I set a 2" x 36" iron pipe Thence I continued this line South on the same bearing 30' 0° 45' E 276 feet and set a 2" x 36" Iron Pipe on the end of Maple Street, Maynard's Harvard Addition to West Roseburg This Iron Pipe is 5 6 feet East of the pipe set at the end of Maple Street and on the center line of said street I then ran out center line of Harrison Street from the plat of the Maynards Harvard Avenue Addition to West Roseburg and set two 1" x 18" Iron Pipe on the East side of said street and an iron bar on the West side as indicated by Plat I then ran the South boundary of Wilsons place from the iron pipe found at his S W corner continued on line So 89° 20" East 231.01 feet to Wilsons S E. corner, I set a 1' x 36" iron pipe and then intersected the center line of Harrison Street 20 feet from the iron pipe at the So E corner of Wilsons place