132

COUNTY SURVEYOR'S RECORD, DOUGLAS COUNTY, OREGON

Survey No. *Made on* December 19 1922	*Survey No.* *Made on*
In Town. 28 S *Range* 6 W *Sec.* 29	*In Town.* *Range* *Sec.*
Made for R. A. Hercher et al	*Made for*
Purpose of Corners and fence lines	*Purpose of*
C, G. Stewart, Deputy	

I began at mound of rocks pointed out to be the quarter section corner between sections 20 and 29 . I can not find evidence of witness trees as they have been destroyed. This corner has been accepted as ¼ corner in making land ties in this vicinity so I reestablish corner by driving 1½" iron pipe and marking 14" Balm N 38°E 210.5 ft; 16" Balm N 62° E 261.5 ft, no other suitable trees available. From this corner as set I run a transit line to iron pipe set years ago for center of section 29. There are no trees for this corner, but location of pipe pointed out by property owners. I accept this as correct and compute the bearing of line to ¼ corner as S 0° 35' E 2653.2 ft, Variation 21°15' . I compute position of property corner one fourth of distance between two corners and drive iron pipe and run transit line N 89° 25' E for division line.

I compute half was point or sixteenth corner North of center section and drive iron pipe and mark 12" Cherry tree N 46° W 17.0 ft. From this pipe I run transit line N 89° 25' E 396.0 ft and set pipe, and then continue 264.0 ft farther, same bearing and set hub at side of road.

I return to quarter corner between 20 and 29 and run N 89° 12' E along section line 396.0 ft and drive iron pipe. I did not run to section corner for the section line, but took a post by south side of P.H. Bridge as a site from ¼ corner, said post was said by property owners to be on the section line, from a previous survey. I also set stakes for fence line from this iron pipe to iron pipe quater of a mile South of it.
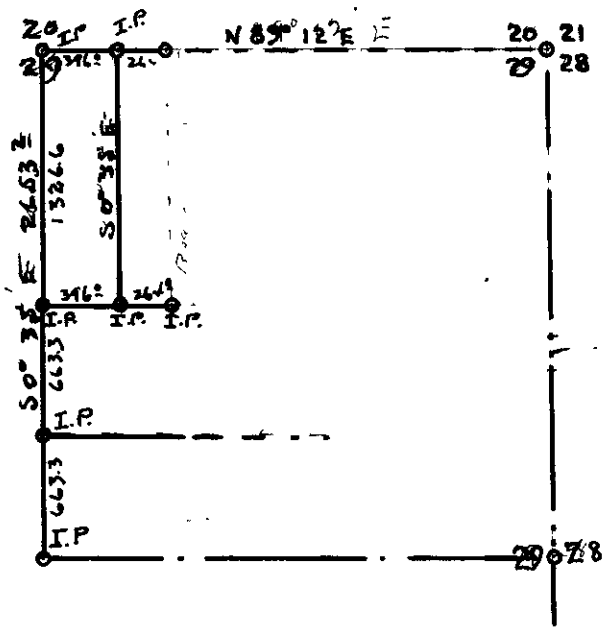
Lawrence Hercher and C. C. Laurance ~~Hercher~~ chainmen. R. A. Hercher rear flag man.