134

COUNTY SURVEYOR'S RECORD, DOUGLAS COUNTY, OREGON

Survey No. **Made on** Dec 29 1923

In Town. 27 **Range** 7 **Sec.** 23

Made for G .W.Finley

Purpose of To establish the approximate Section line between Sections 23 and 26

J.W.Cole Surveyor
; G.W.Finley
Witnessess; Geo Finley
; Harry Brown

F.N."L."

Survey No. **Made on** Jan 4 1923

In Town. 27 S **Range** 7 W.W.M. **Sec.** 12

Made for Melrose School Dist No 25

Purpose of To get description of lot to be Acquired for school lot

J.W.Cole --Surveyor
John Doern r --Chain Var 21°45'E
C.O.Critser -- Axe

F.N."L."

Approx ¼Cor ◎ West 40.07½ Ch (23 24 26 25)

I Began the survey at the Cor to Sections 23-24-25-26 which I renewed from three of the original Bearing trees which checked very closely.

Thence West on a Magnetic Course Variation 21°45'E 2645,6 ft. equals 40.07½ Chs.and looked for evidence of the quarter post,but found no evidence ,I set an approximate Quarter corner by setting an oak post and errected a mound of rock ,from which

A W Oak 10 in dia N53°15'E 26.0 ft.
" " 30 in dia S37° 30'E 44,0 ft.

Thence North about 1,000 ft to designate the approximate line for fence

---

(2)

East 1612.4 ft ◎ ¼Cor. Sec 1. Sec 12

I began the survey at the ¼ Corner bet Secs 1 and 12 which had been newly established by Gordon Stewart,Thence S 62°35'W 42.5 ft to Hub No 1, Thence S 63 56'W 121.9 ft to Hub No 2 ,Thence S61°18 W 1376.9 ft to Hub N .3 Thence S6818'W 1036.4 ft. to hub No. 4 Thence S 5°29'W 893.5 ft to hub No.5 Thence S 5° 27' W 451.0 ft. to hub no. 6 and the Initial point of the survey,

Thence S 8°10'W, 501,9 ft to an iron pipe "2"x30" at the intersection of the cross roads Thence 89°19'E 306.0 ft to a point in the center of the county road from which an Iron pipe 2"x30" bears North 20. ft. Thence N0°16'E 306.6 ft to an iron pipe 2"x30" thence S89°21'W 275.0 ft to place of the beginning and containing 2.02 Acres The beginning point being in the center of the County road from which the ¼ Corner bet Secs 1 and 12 bears North 3101.4 ft and East 1612.4 ft. and an iron pipe bears East 25.0 ft

Initial bearing -Magnetic
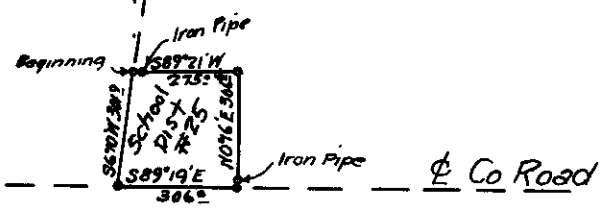
North 3101.4 ft. ℄ Co. Road