COUNTY SURVEYOR'S RECORD, DOUGLAS COUNTY, OREGON

BUSHONG & CO. PORTLAND, ORE. 87545

Survey No. *Made on* Jan 18-19 1924

In Town. 24 S *Range* 7 W *Sec.* 34-35

Made for Jack Sabonjian and L.W.Harris

Purpose of To determine approximate Sec line bet 34-35

J.W.Cole;;;Surveyor
L.W.Harris
Jack Sabonjian Helpers
Loy Harris
Jim Evans

C.S. 1/22

F.B. 300-52

Survey No. *Made on* April 28 1924

In Town. 27 S *Range* 7 W *Sec.* 25

Made for Walter Vashow

Purpose of To locate the West Bdy of N.W.¼ Sec 25

J.W.Cole County Surveyor

F.B. 8 -31

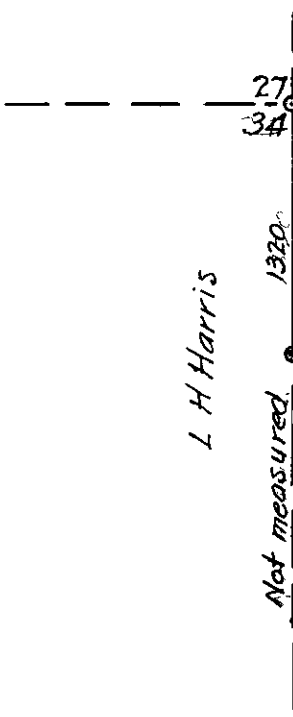

I began the survey at the corner of Sec's 26-27-34-35,T 24 S R 7 W W.M. which I renewed from the cedar B.T. S85°W101.6 ft from which stump of 24 inch fir N33°E 112.0 ft. a stump badly burned N50°W 97.ft. Hole where tree has burned out S48°E 80.0 ft.

Jack Sabonjian

I set a sand stone 10x10x15 and errected a mound of rock Marked rock corner 2 notches on East and One on South also CS on North and x on top of rock. Did not mark trees as they were all burned badly .

Thence I ran South Var 21°30' 1320 ft and set a Cedar stake for approximate 1/16 cor.

I then ran East without measure ment approximately 500 ft.

Mr H arris and Mr Sabonjian both verbally agreed that the line was entirely satisfactory as a property line.

x-x-x--x-x--x-x-x-x-x-x-x-x-x-x-x-x-x-x-x-x-x-x-x-x-x-x-x-x-x-

Survey for Walter Vashow

I began the survey at the corner to Sections 23-24-25-26 which had previously been renewed ,and ran a random traverse line South and at a point computed by latitudes and departures I intersected the ¼ Sec corner bet 25-26 which I renewed by setting a Cedar Post and a mound of rock,from which one of the Original Bearing trees bears S 47°W 12 lks,this tree I chopped open and found the scribe marks,the other tree was entirely gone,but the whole remained where it had stood.I marked new trees as follows
A W.Oak 10 in dia N68°00'W 30.0 ft.; also set Steel Auto axle
A W.Oak 5 in N75°30'E 37.0 ft. ; at corner
I then corrected the to the true lime , as S0°19'W 2642 ft. and st cedar stakes at close intervals,and blazed the trees along the line.