23.9

COUNTY SURVEYOR'S RECORD, DOUGLAS COUNTY, OREGON

BUSHONG & CO. PORTLAND, ORE. 87545

Survey No. 3-23 *Made on*	*Survey No.* *Made on*
In Town. *Range* *Sec.*	*In Town.* *Range* *Sec.*
Made for	*Made for*
Purpose of	*Purpose of*

From the corner to 20-21-28-29 which a charred stake in place, properly marked I run

N 1°17'E — On random line getween Sec. 20-21

40.00 — Temporary 1/4 corner (Could not find corner after search)

79.23 — Corner of 16-17-20-21

There being no evidence of the 1/4 corner on this line, either corner or bearing trees, I set it by proportional measurment at a point N 1°17'E 39.62 chains. Set an 6 ft. x 2½" pipe 4 ft. in the ground and marked
An Alder 12" brs. N 31°E 72 lks B.T. 1/4 S 21 C.S.
An Alder 15" brs N23°15'W 56 lks B.T. 1/4 S 20 C.S.

At the Northwest corner of D.L.C. No. 39 I find B.T.s and corner tree in place. The corner tree being partly burned I drive an iron pin in the stump for the corner
The B.T. S 40°W 27 lks. is properly marked
The B.T. S 10°E 34 lks. had no visible marks so I remarked it by scribing it CL 39 B.T. C.S. thence

South 3.00 — to Section line thence

N 89°32'W 5.32 — To Section corner 16-17-21-22 thence

South 10.00 — To North west corner D.L.C. where I find stump of old B.T. S 88°W 84 lks. as all ties to Section corner checks I establish the corner by driving an 2" x 18" iron pipe, No trees near.
thence

N 89°36'W 5.25 Intersect Sec. Line bet. 20-21 S1°17'W 7.10 ch. from sec. cor.

30.11 to N.W. Cor D.L.C. No. 39 In Sec. 20
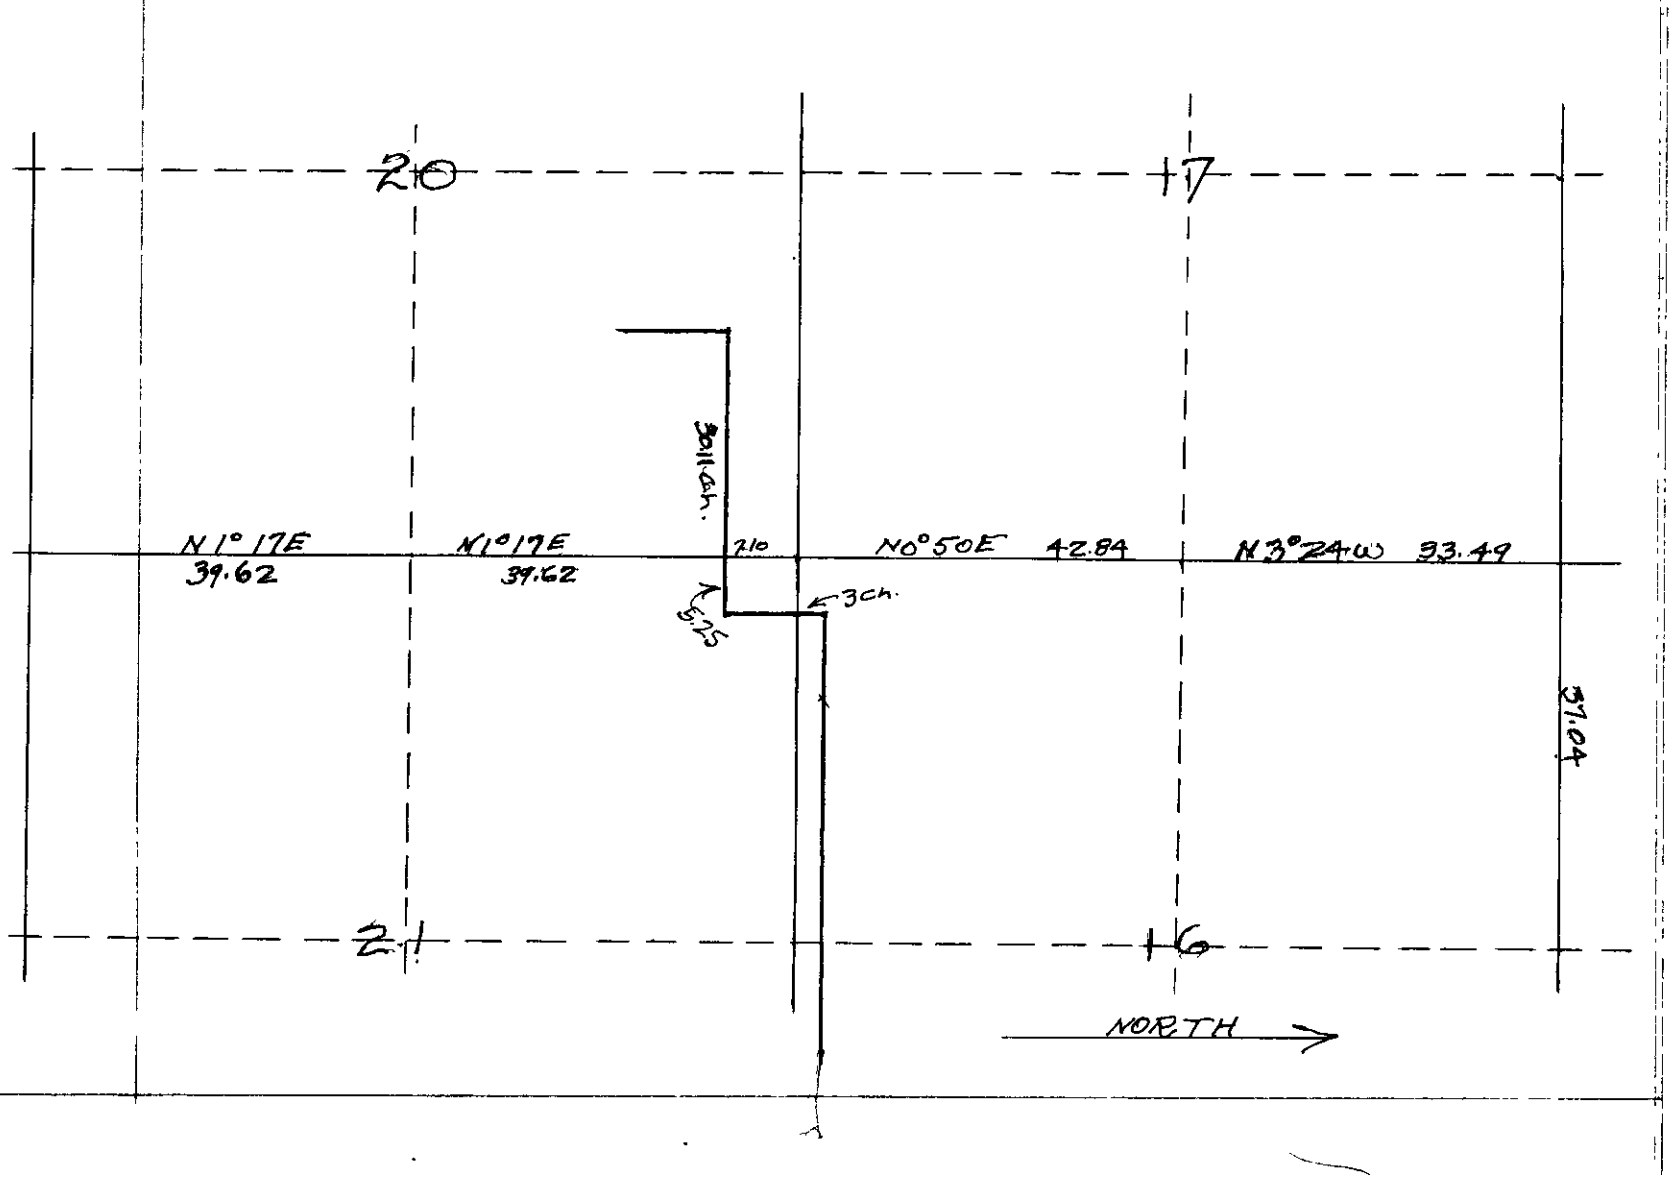
I find both B.T.s but are dead and in perishing condition I set a 3 x 3 oak stake scribed D.L.C. 39 C.S. and mark
Fir 12" S 16 W 20 lks. D.L.C. 39 B.T. C.S.
Fir 18" S 61 E 19 lks. D.L.C. 39 B.T. C.S.